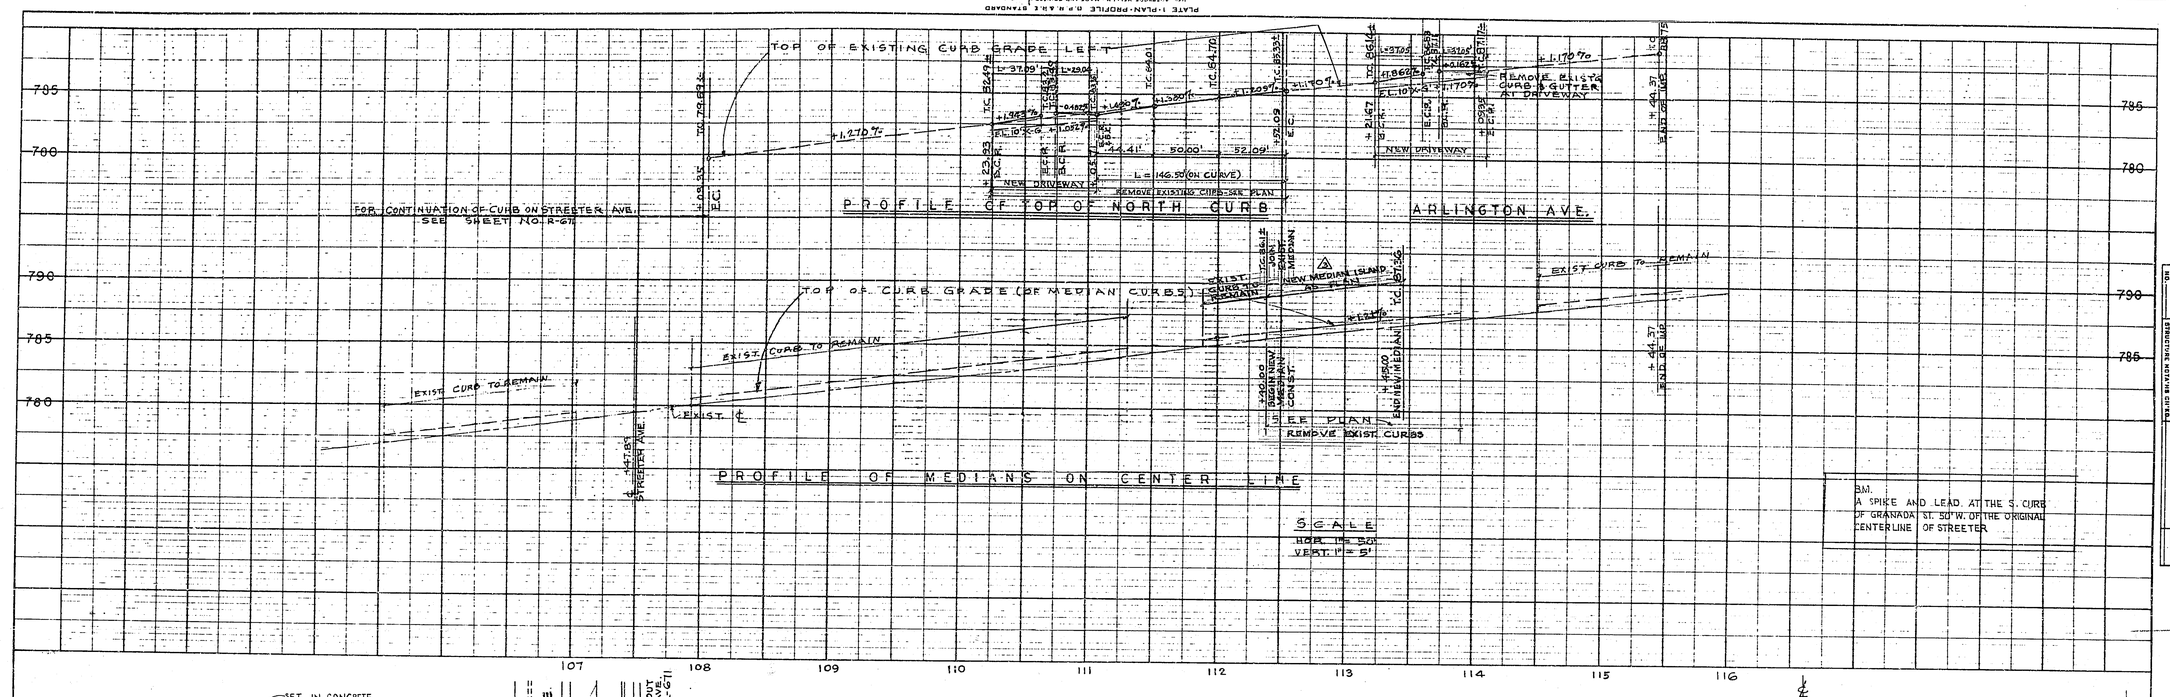

PLATE 1-PLAN-PROFILE O.P.R.R.E. STANOARD
BY ASPHOOT STILLE MADE AND APPROVED BY A.
EUGENE DIETZGEN CO.

PROFILE			
NOTE BOOK NO.	SURVEYED		
	PLOTTED		
	GRADES CHECKED		
	STRUCTURE NOTE IN CURVE		BY
			DATE

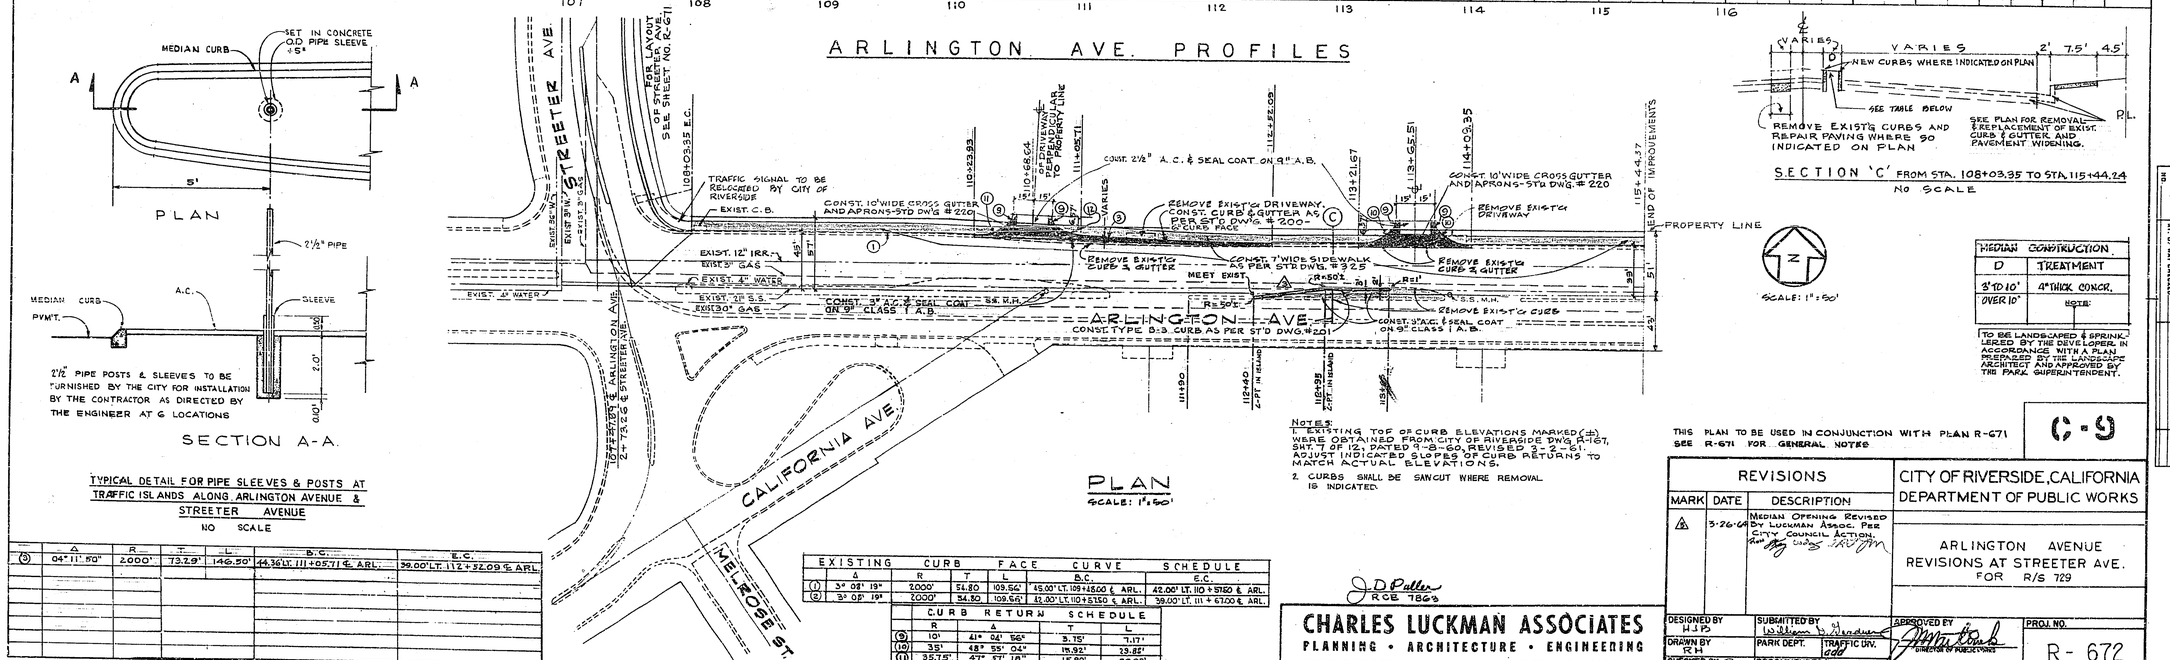

S.ECTION 'C' FROM STA. 108+03.35 TO STA. 115+44.24
NO SCALE

MEDIAN CONSTRUCTION	
D	TREATMENT
3' TO 10'	4" THICK CONCR.
OVER 10'	NOTE:

TO BE LANDSCAPED & SPRINKLERED BY THE DEVELOPER IN ACCORDANCE WITH A PLAN PREPARED BY THE LANDSCAPE ARCHITECT AND APPROVED BY THE PARK SUPERINTENDENT.

SCALE: 1" = 50'

	Δ	R	T	L	B.C.	E.C.
(3)	04° 11' 50"	2000'	73.29'	146.50'	44.36' LT. 111+05.71 ℄ ARL.	39.00' LT. 112+32.09 ℄ ARL.

EXISTING CURB FACE CURVE SCHEDULE						
	Δ	R	T	L	B.C.	E.C.
(1)	3° 02' 19"	2000'	54.80	109.56'	45.00' LT. 109+48.00 ℄ ARL.	42.00' LT. 110+57.60 ℄ ARL.
(2)	3° 02' 19"	2000'	54.80	109.56'	43.00' LT. 110+53.50 ℄ ARL.	39.00' LT. 111+63.00 ℄ ARL.

CURB RETURN SCHEDULE				
	R	Δ	T	L
(9)	10'	41° 04' 56"	3.75'	7.17'
(10)	35'	48° 55' 04"	19.92'	33.85'
(11)	35.75'	47° 57' 18"	15.90'	29.92'
(12)	30'	35° 48' 10"	11.31'	21.87'

NOTES:
1. EXISTING TOP OF CURB ELEVATIONS MARKED (±) WERE OBTAINED FROM CITY OF RIVERSIDE DWG. R-167, SHT. 7 OF 12; DATED 9-8-60, REVISED 3-2-51. ADJUST INDICATED SLOPES OF CURB RETURNS TO MATCH ACTUAL ELEVATIONS.
2. CURBS SHALL BE SAWCUT WHERE REMOVAL IS INDICATED.

THIS PLAN TO BE USED IN CONJUNCTION WITH PLAN R-671
SEE R-671 FOR GENERAL NOTES

C-9

PLAN			
NOTE BOOK NO.	SURVEYED		
	PLOTTED		
	ALIGNMENT CHECKED		
	ST. OF WAY CHECKED		BY
			DATE

J.D. Pullen
RCE 7868

CHARLES LUCKMAN ASSOCIATES
PLANNING • ARCHITECTURE • ENGINEERING
9220 SUNSET BLVD. • LOS ANGELES • CALIFORNIA

REVISIONS		
MARK	DATE	DESCRIPTION
4	3-26-68	MEDIAN OPENING REVISED BY LUCKMAN ASSOC. PER CITY COUNCIL ACTION.

CITY OF RIVERSIDE, CALIFORNIA
DEPARTMENT OF PUBLIC WORKS

ARLINGTON AVENUE
REVISIONS AT STREETER AVE.
FOR R/S 729

DESIGNED BY H.J.B.	SUBMITTED BY	APPROVED BY	PROJ. NO.
DRAWN BY R.H.	PARK DEPT. / TRAFFIC DIV.	DIRECTOR OF PUBLIC WORKS	R-672
CHECKED BY R.H.	RECOMMENDED BY ASSISTANT CITY ENGINEER	DATE 10-7-63	SHEET 1 OF 1

SEARS, ROEBUCK & CO. - RIVERSIDE, CALIFORNIA - OFF SITE IMPROVEMENTS JOB 1622.01 1-25-63