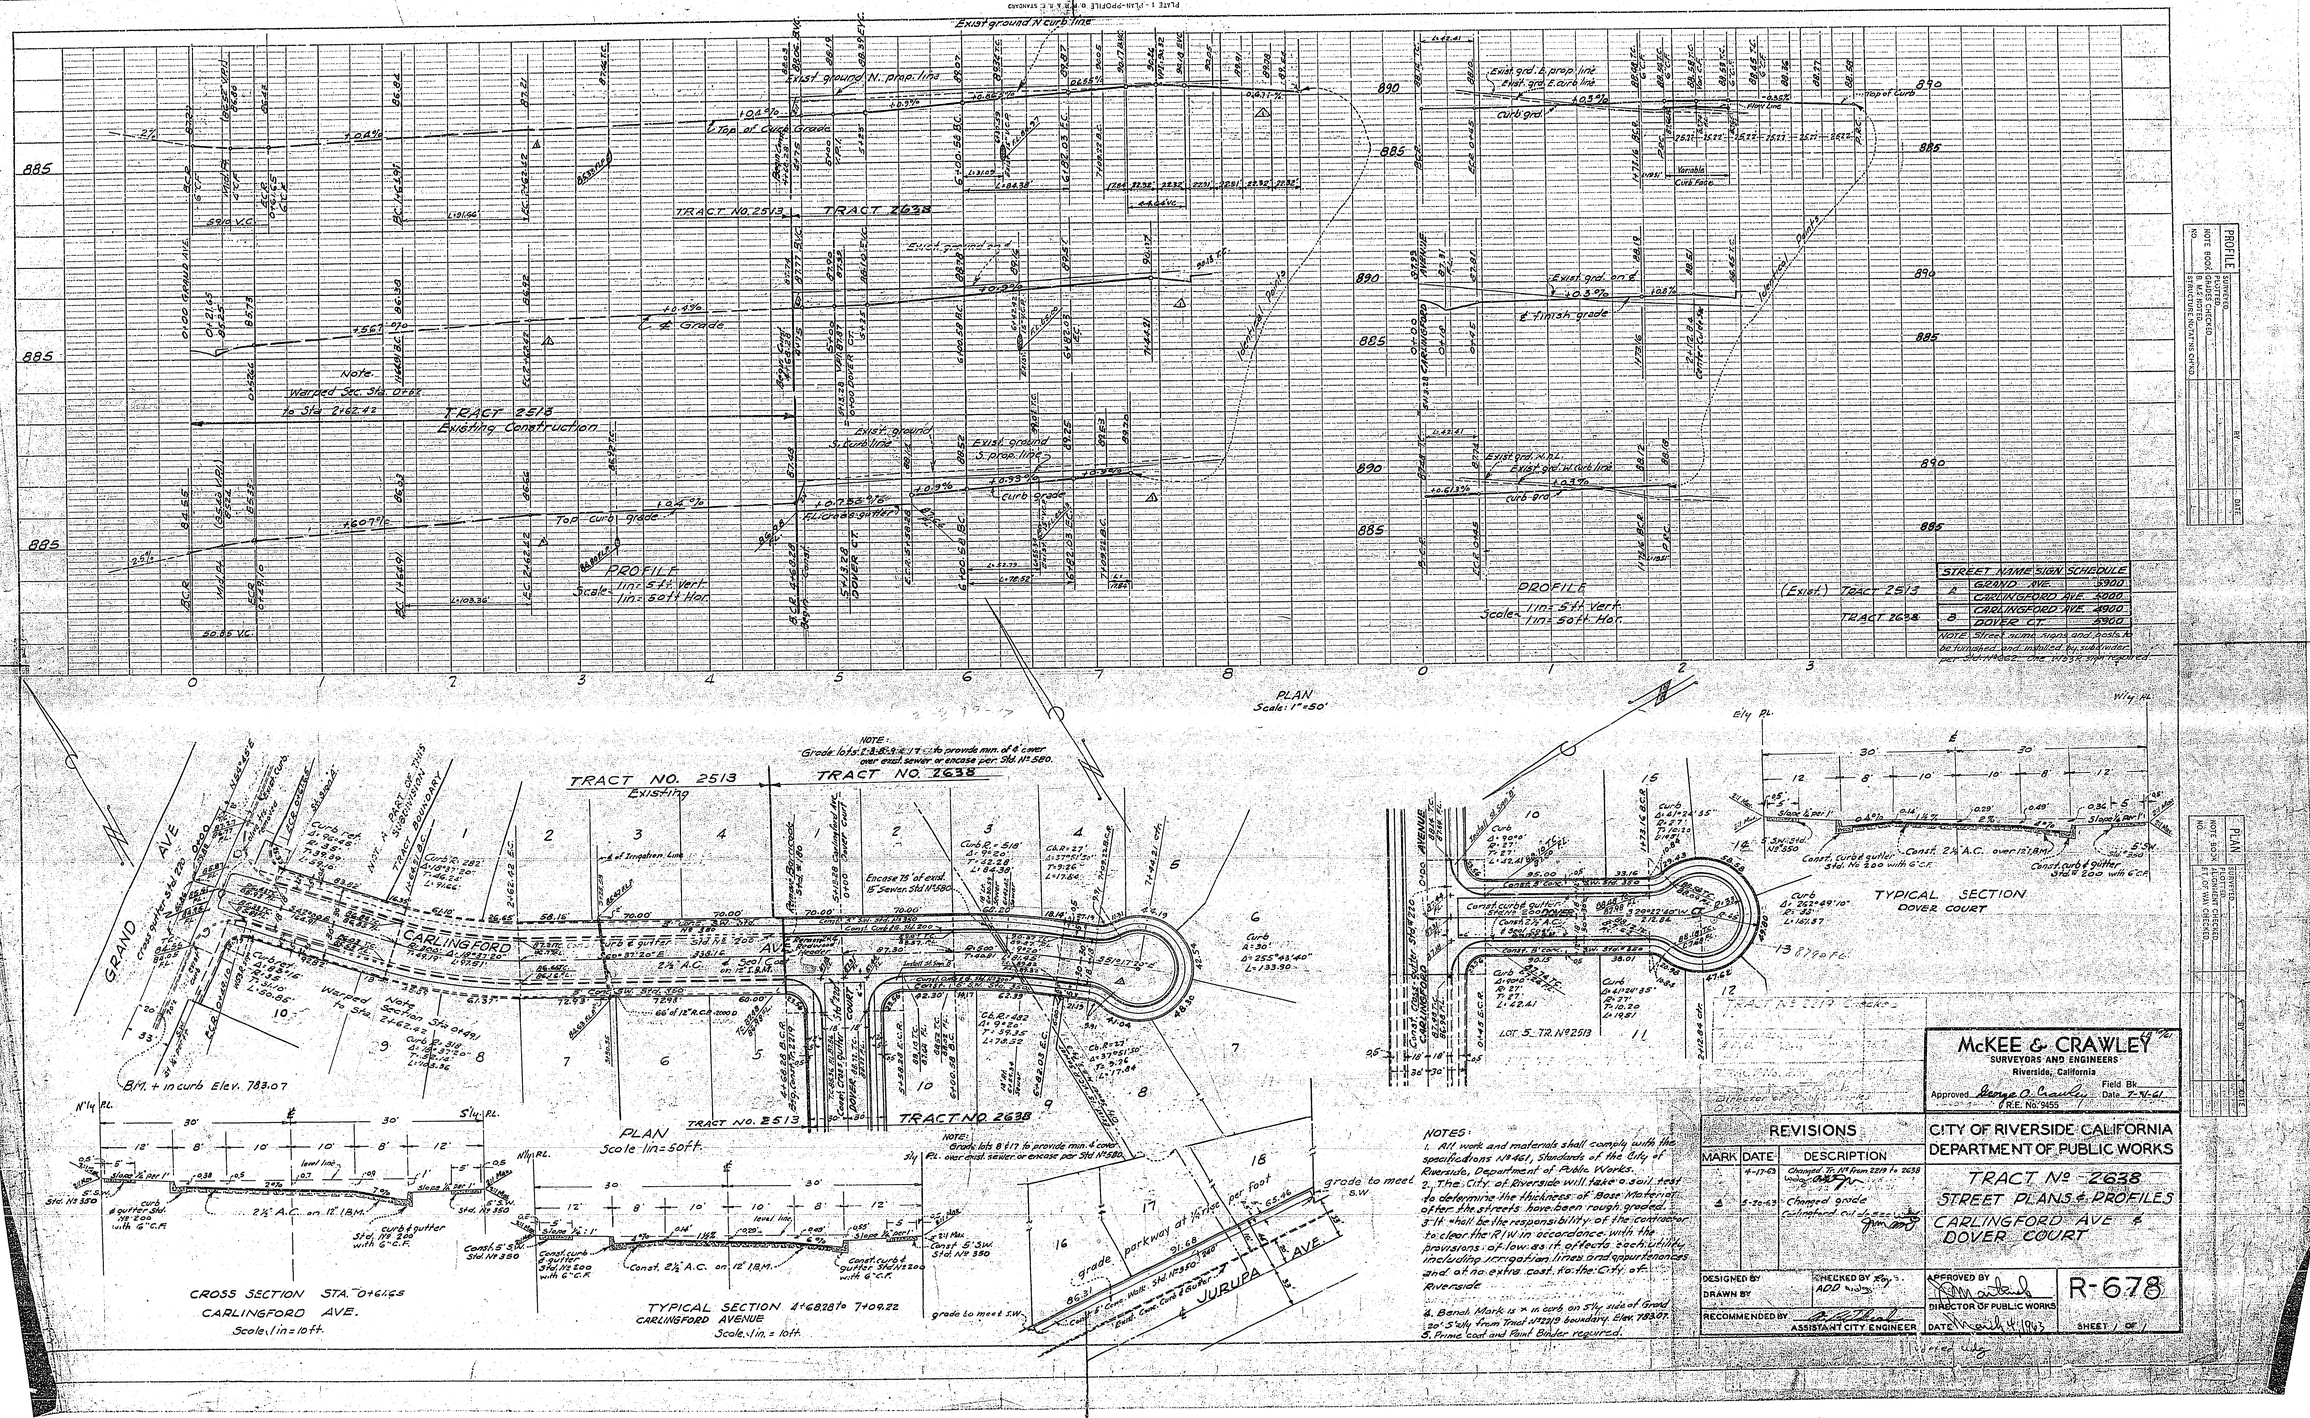


| STREET NAME SIGN SCHEDULE | | |
|---|---|---|
| A | GRAND AVE. | 2900 |
| | CARLINGFORD AVE. | 2000 |
| | CARLINGFORD AVE. | 2900 |
| B | DOVER CT. | 2900 |

NOTE: Street name signs and posts to be furnished and installed by subdivider per Ordinance No. 1283 and regulations.

NOTES:
1. All work and materials shall comply with the specifications No. 461, Standards of the City of Riverside, Department of Public Works.
2. The City of Riverside will take a soil test to determine the thickness of Base Material after the streets have been rough graded.
3. It shall be the responsibility of the contractor to clear the R/W in accordance with the provisions of law as it affects each utility including irrigation lines and appurtenances and at no extra cost to the City of Riverside.
4. Bench Mark is + in curb on S'ly side of Grand 20' S'ly from Tract No. 2219 boundary. Elev. 783.07
5. Prime coat and Paint Binder required.

McKEE & CRAWLEY
SURVEYORS AND ENGINEERS
Riverside, California
Approved George O. Crawley R.E. No. 9455
Field Bk.
Date 7-11-61

| REVISIONS | | |
|---|---|---|
| MARK | DATE | DESCRIPTION |
| | 4-17-63 | Changed Tr. No. from 2219 to 2638 |
| A | 5-20-63 | Changed grade |

CITY OF RIVERSIDE CALIFORNIA
DEPARTMENT OF PUBLIC WORKS

TRACT No. 2638
STREET PLANS & PROFILES
CARLINGFORD AVE. & DOVER COURT

DESIGNED BY
DRAWN BY
RECOMMENDED BY
CHECKED BY
ASSISTANT CITY ENGINEER
APPROVED BY
DIRECTOR OF PUBLIC WORKS
DATE March 4, 1963

R-678

SHEET 1 OF 1

PROFILE
SURVEYED
PLOTTED
GRADES CHECKED
NOTE BOOK
STRUCTURE No. AT THIS STA.
NO.

PLAN
SURVEYED
PLOTTED
FIELD INSPECTION
L.T. OF WAY CHECKED
NOTE BOOK
NO.

PLATE 1 - PLAN-PROFILE & PRESSED STANDARD
McKEE & CRAWLEY
K & E CO. No. 340-10