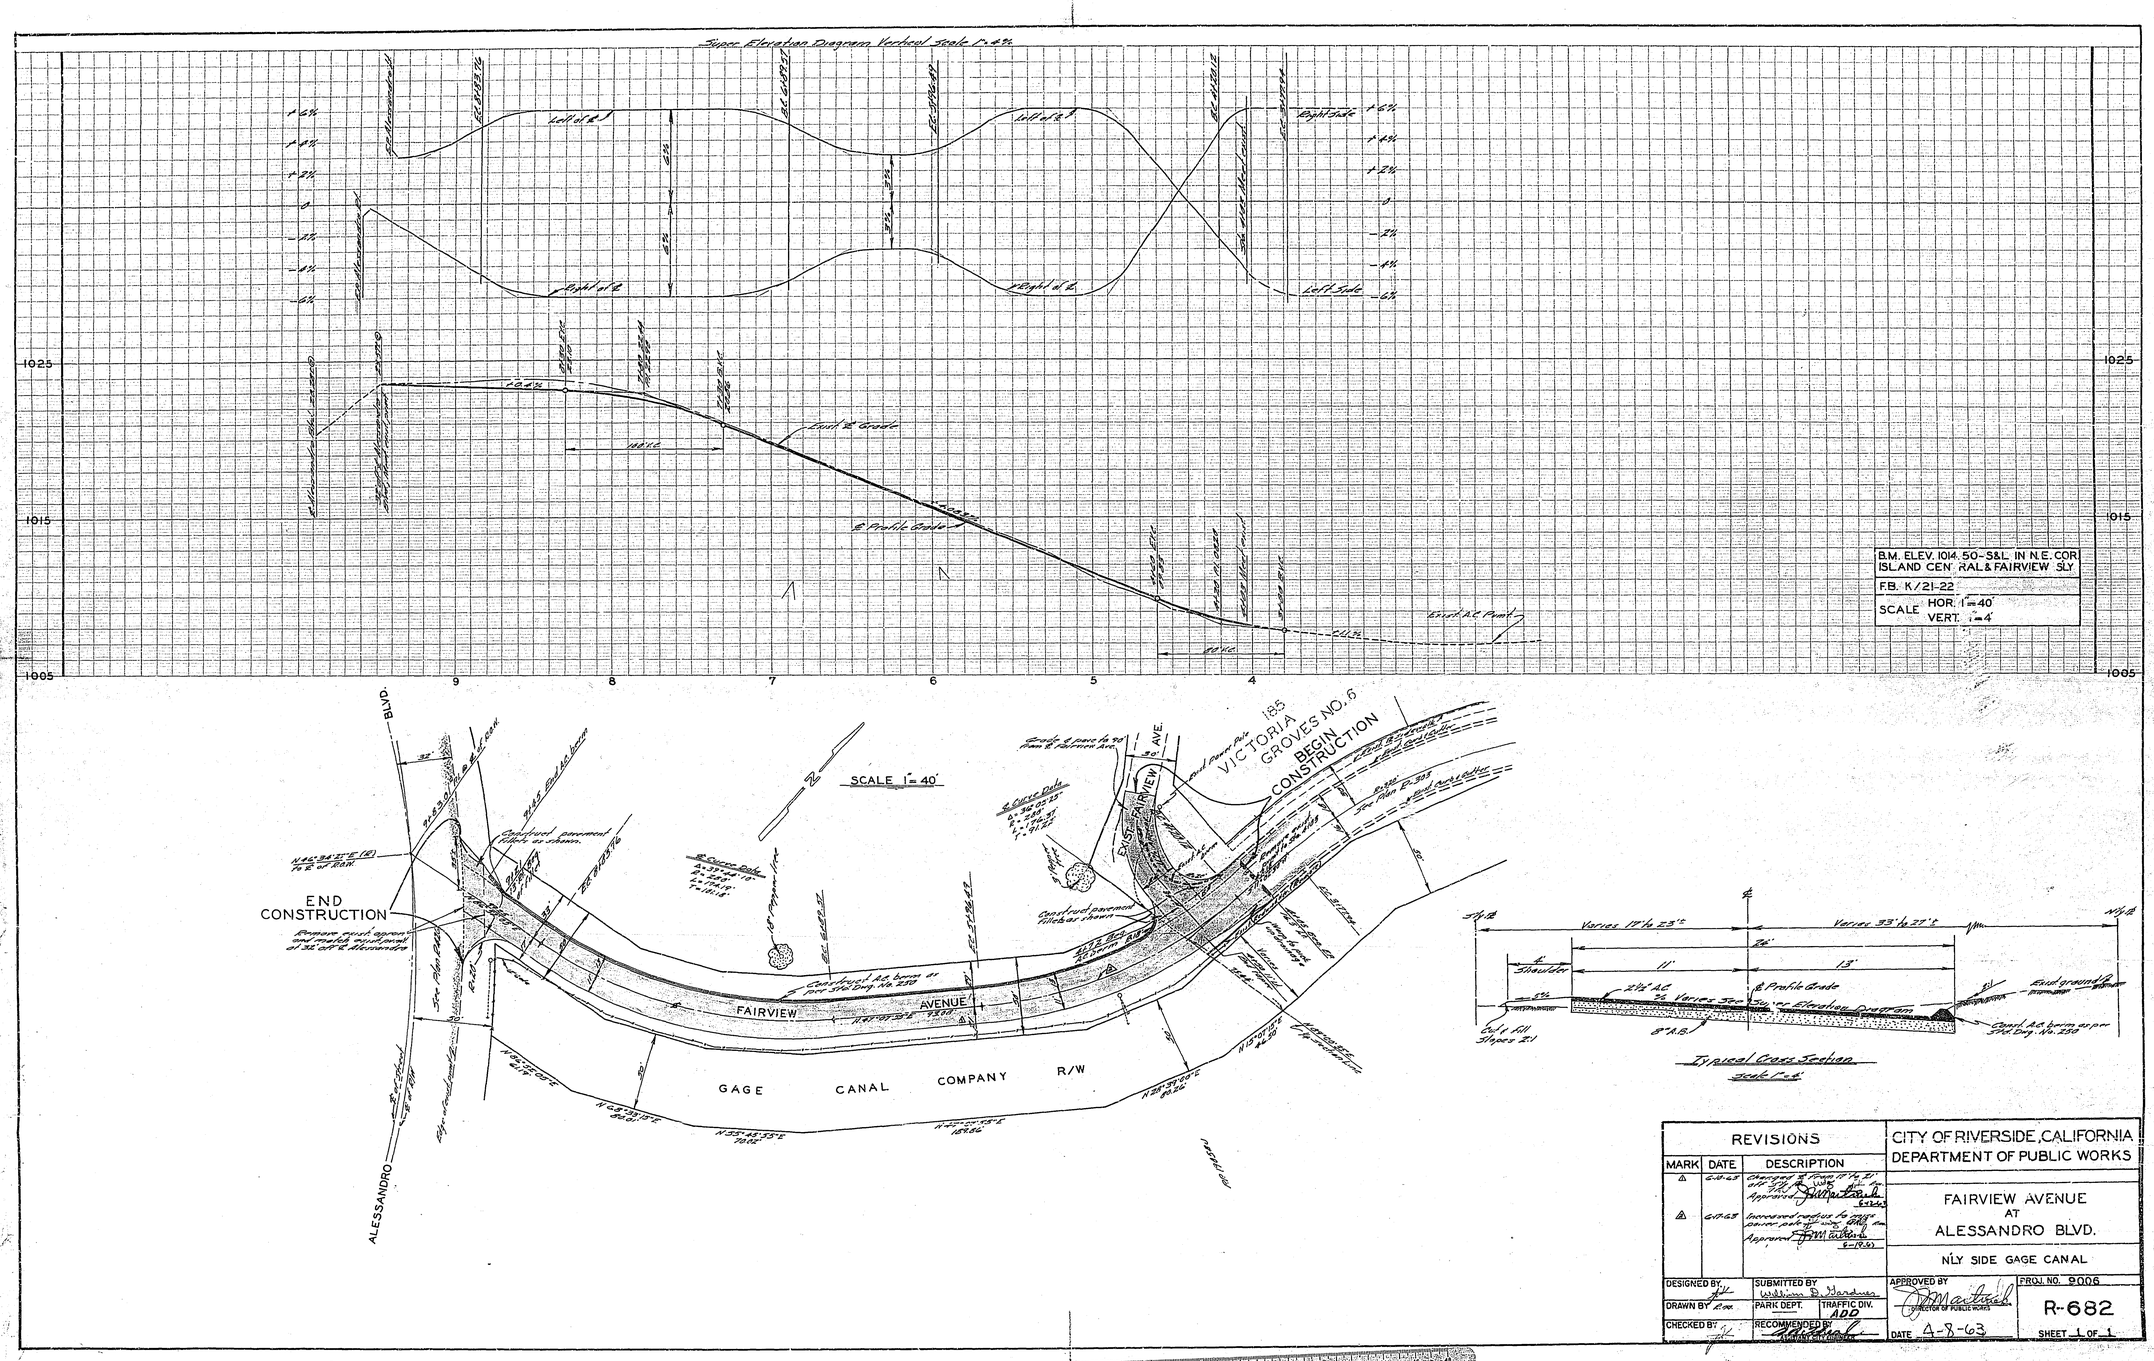

REVISIONS		
MARK	DATE	DESCRIPTION
△	6-18-63	Changed ℄ from 17' to 21' off Sly R/W Approved [signature] 6-24-63
△	6-17-63	Increased radius to make power pole off Sly R/W Approved [signature] 6-19-63

CITY OF RIVERSIDE, CALIFORNIA
DEPARTMENT OF PUBLIC WORKS

FAIRVIEW AVENUE
AT
ALESSANDRO BLVD.

N'LY SIDE GAGE CANAL

DESIGNED BY [signature]	SUBMITTED BY William D. Gardner	APPROVED BY [signature] DIRECTOR OF PUBLIC WORKS	PROJ. NO. 9006
DRAWN BY R.W.	PARK DEPT. / TRAFFIC DIV. ADD		R-682
CHECKED BY [signature]	RECOMMENDED BY [signature] ASSISTANT CITY ENGINEER	DATE 4-8-63	SHEET 1 OF 1