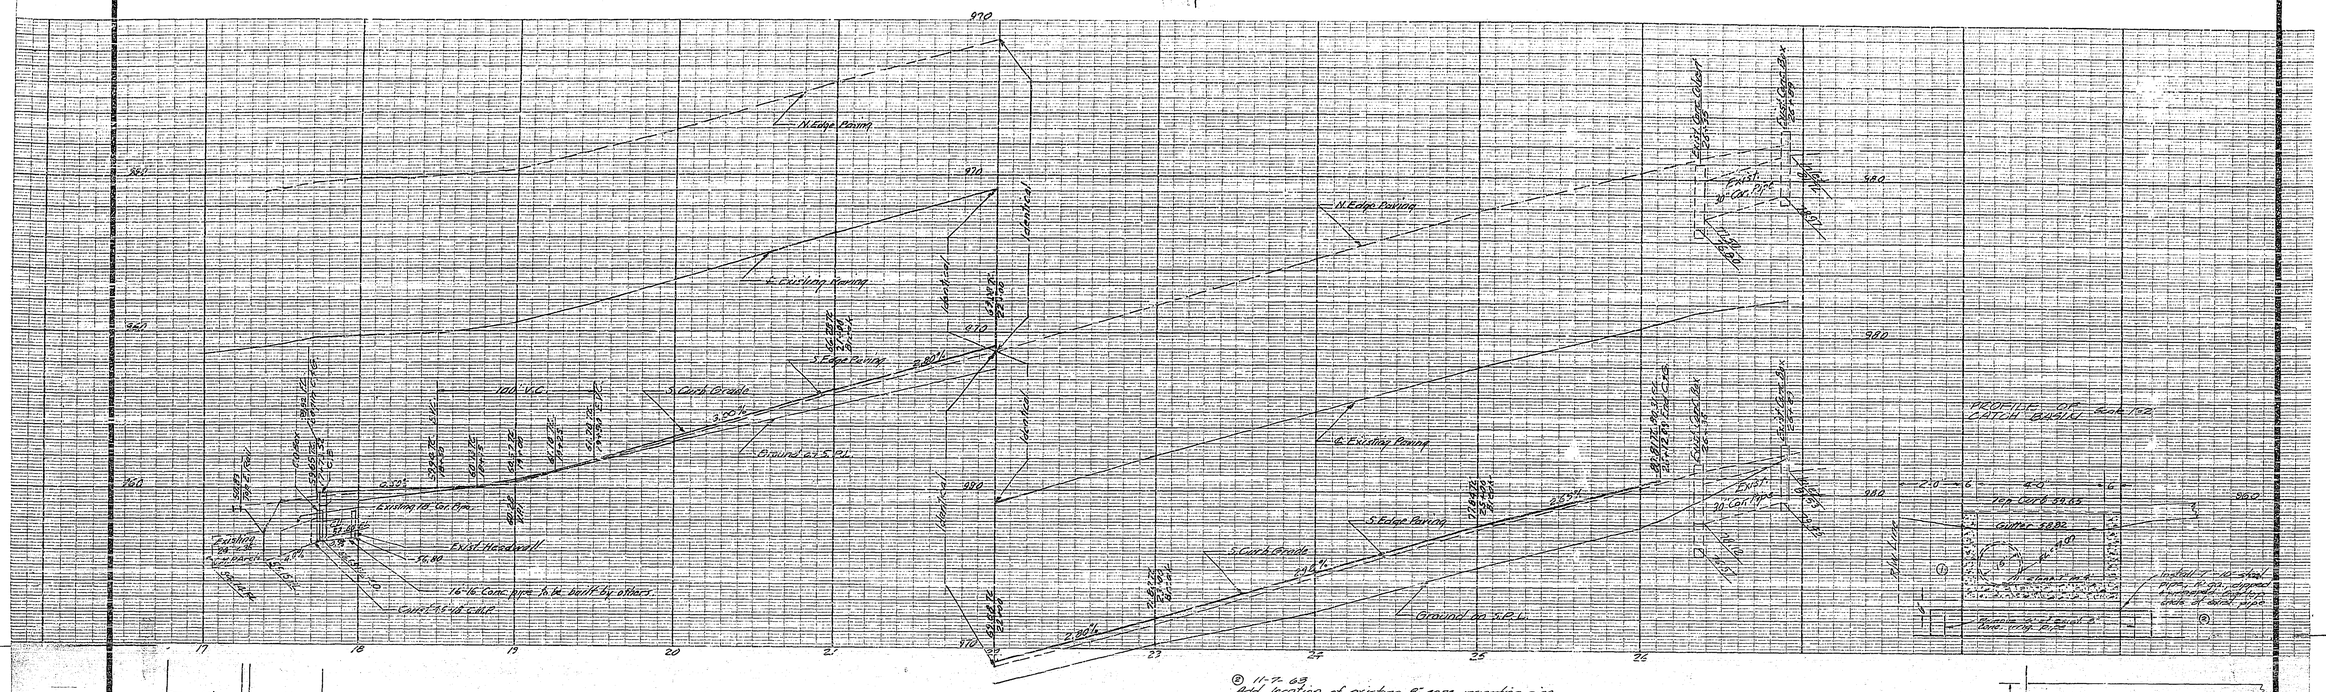

⑧ 11-7-63
Add location of existing 8" conc. irrigation pipe. Remove 6'-8" conc. pipe below catch basin & replace with 7'-10" steel pipe, 10 ga., dipped & wrapped.
Approved R.M. Ricks
R.M. RICKS
East Riverside Water Co.

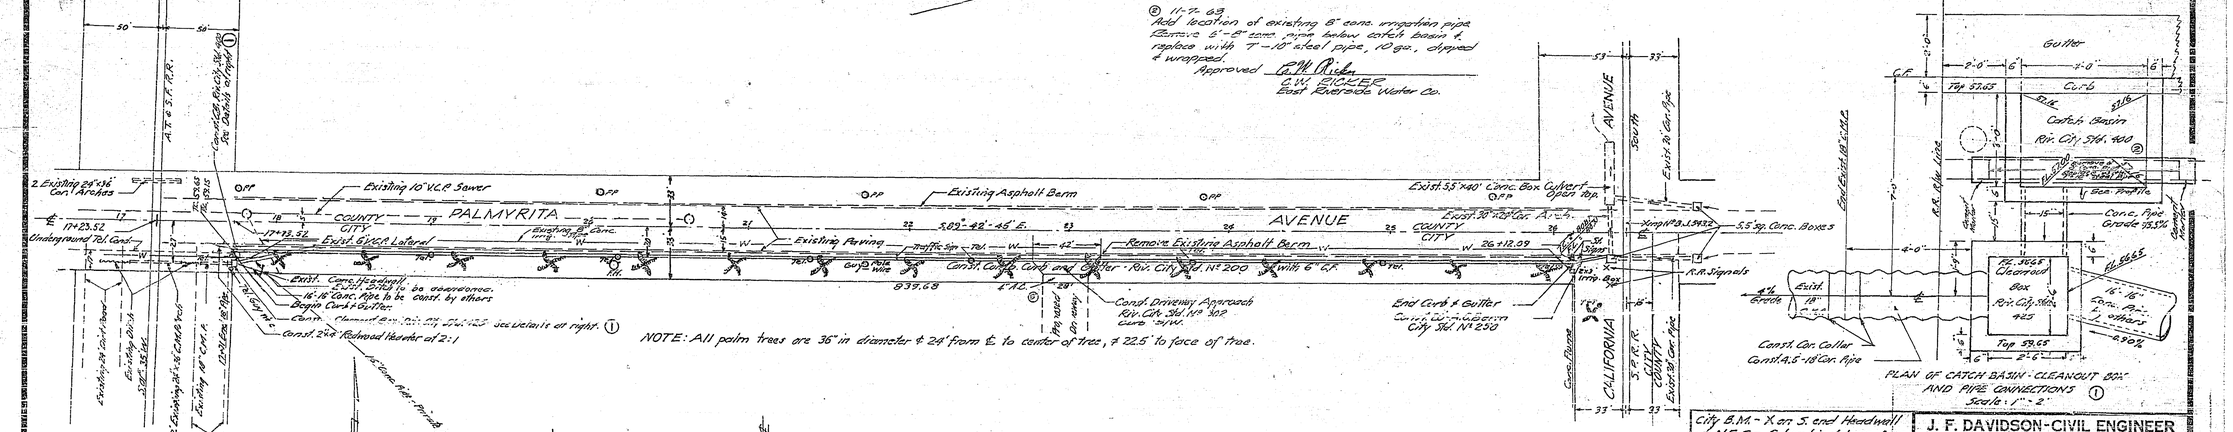

NOTE: All palm trees are 36" in diameter & 24' from ℄ to center of tree, & 22.5' to face of tree.

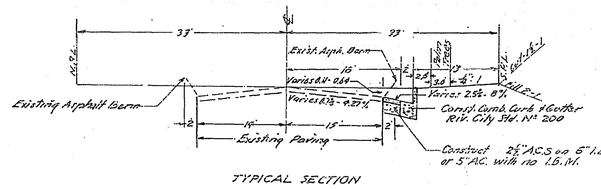

TYPICAL SECTION
TAKEN AT STA. 20
Hor. 1" = 10 Vert. 1" = 2'

Prime coat & paint binder will be required.

4. Trim edge of existing paving to a clean straight line. Construct match-up paving and overlap on existing paving as directed in the field, to produce a smooth crown surface.

City B.M. - X on S. end Headwall at N.E. Cor. Columbia & Iowa Aves. City Imp. Plan No. 19-514 Elev. = 919.98

① 10/11/63 Relocate C.B. & Co. Assembly
C.J. Davidson

⑦ 11-7-63 Add location of 8" conc. pipe & installation of 10" steel pipe
J.D. Fain

⑧ 11-7-63 Add location of existing irrigation pipe
Approved R.M. Ricks
ADD 1 to 8

J. F. DAVIDSON - CIVIL ENGINEER
R.E. NO. 862
RIVERSIDE, CALIFORNIA
APPROVED BY J. F. Davidson DATE 3/28/63

CITY OF RIVERSIDE, CALIFORNIA
DEPARTMENT OF PUBLIC WORKS

STREET PLAN & PROFILE
PALMYRITA AVENUE
BETWEEN A.T. & S.F. R.R. and CALIFORNIA AVENUE

HORIZ. SCALE 1" = 40' VERT. SCALE 1" = 4'

APPROVED BY J. F. Davidson
Director of Public Works
NO. R 693
DATE Aug 9, 1963
SHEET 1 OF 1

W.O. 11669 F.B. 760

2708