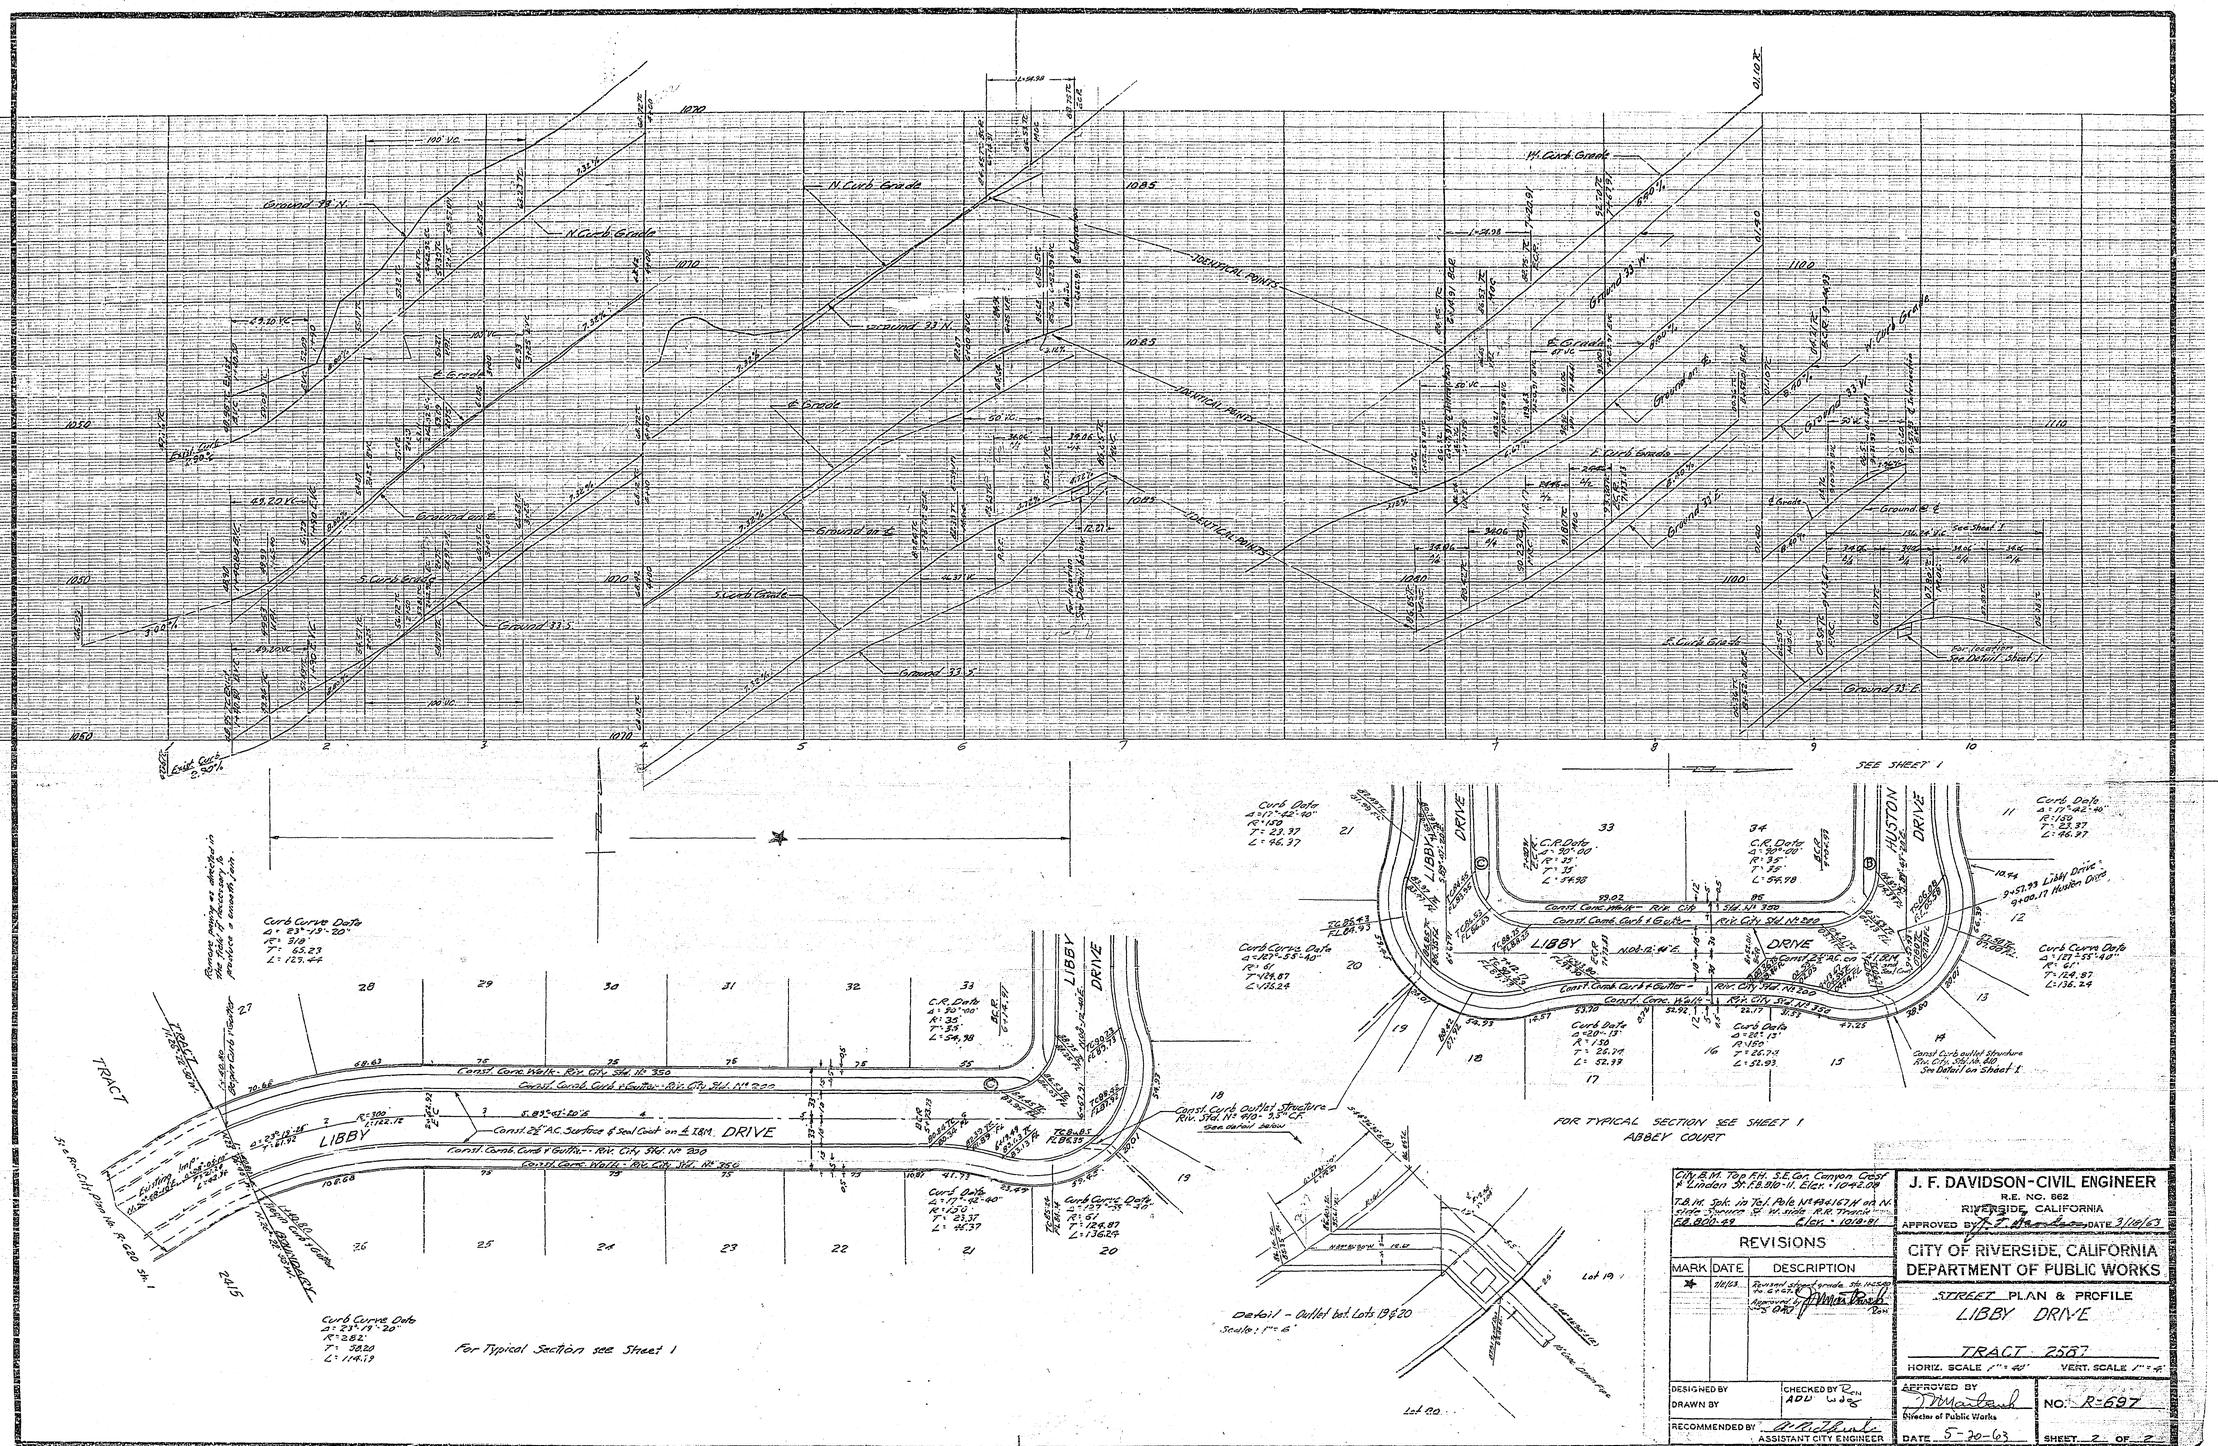

City B.M. Top F.H. S.E. Cor. Canyon Crest & Linden St. F.B. 810-11. Elev. = 1042.09

T.B.M. Spk. in Tel. Pole No. 4434167H on N. side Spruce St. W. side R.R. Tracks F.B. 800-49 Elev. = 1018.81

REVISIONS

MARK	DATE	DESCRIPTION
★	7/16/63	Removed street grade sta. 14+53.80 to 6+67.80. Approved by [signature]

DESIGNED BY
DRAWN BY
CHECKED BY [signature]
RECOMMENDED BY [signature] ASSISTANT CITY ENGINEER

J. F. DAVIDSON-CIVIL ENGINEER
R.E. NO. 862
RIVERSIDE, CALIFORNIA
APPROVED BY [signature] DATE 3/18/63

CITY OF RIVERSIDE, CALIFORNIA
DEPARTMENT OF PUBLIC WORKS

STREET PLAN & PROFILE
LIBBY DRIVE
TRACT 2587

HORIZ. SCALE 1" = 40' VERT. SCALE 1" = 4'

APPROVED BY [signature] Director of Public Works
NO. R-697
DATE 5-20-63
SHEET 2 OF 2

2703

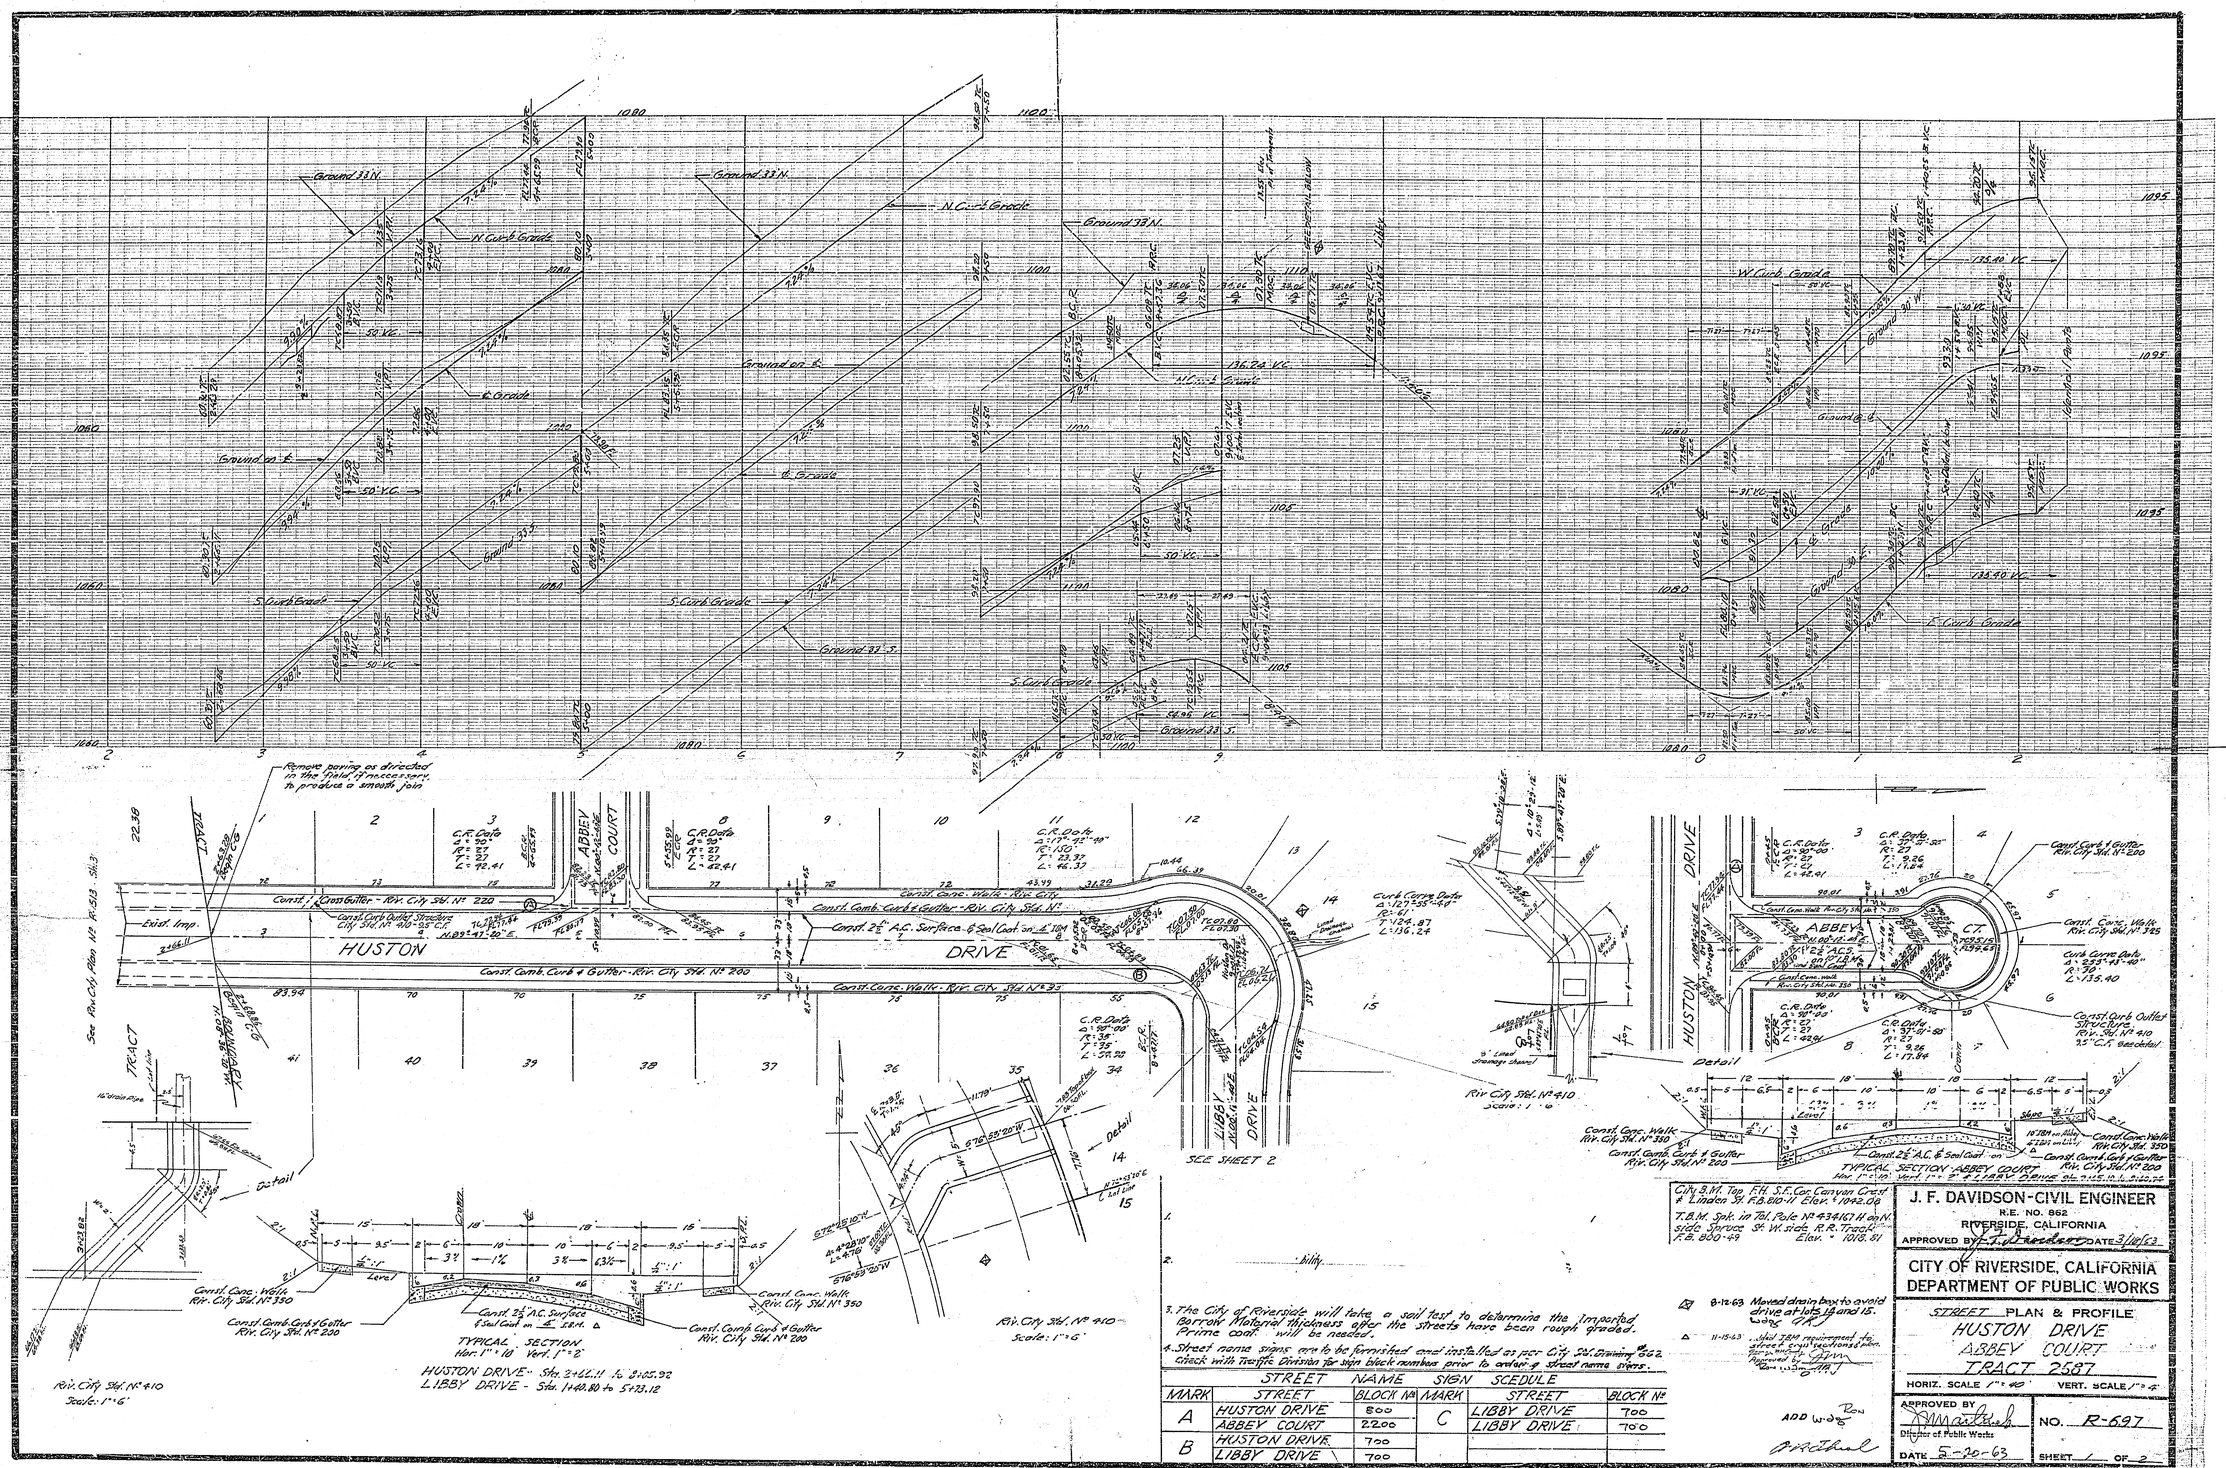

City B.M. Top F.H. S.E. Cor. Canyon Crest & Linden St. F.B. 810-11 Elev. = 1042.06

T.B.M. Spk. in Tel. Pole Nº 434167 H on N. side Spruce St. W. side R.R. Track F.B. 800-49 Elev. = 1010.81

3. The City of Riverside will take a soil test to determine the Imported Borrow Material thickness after the streets have been rough graded. Prime coat will be needed.

4. Street name signs are to be furnished and installed as per City Std. Drawing #662. Check with Traffic Division for sign block numbers prior to order of street name signs.

STREET NAME SIGN SCEDULE					
MARK	STREET	BLOCK Nº	MARK	STREET	BLOCK Nº
A	HUSTON DRIVE	800	C	LIBBY DRIVE	700
	ABBEY COURT	2200		LIBBY DRIVE	700
B	HUSTON DRIVE	700			
	LIBBY DRIVE	700			

8-12-63 Moved drain box to avoid drive at lots 14 and 15. [illegible]

11-15-63 Shut T&M equipment for street construction & plan for [illegible] Approved by [illegible]

ADD [illegible]

J. F. DAVIDSON - CIVIL ENGINEER
R.E. NO. 862
RIVERSIDE, CALIFORNIA

APPROVED BY [signature] DATE 3/16/63

CITY OF RIVERSIDE, CALIFORNIA
DEPARTMENT OF PUBLIC WORKS

STREET PLAN & PROFILE
HUSTON DRIVE
ABBEY COURT
TRACT 2587

HORIZ. SCALE 1" = 40' VERT. SCALE 1" = 4'

APPROVED BY [signature]
Director of Public Works

NO. R-697

DATE 5-20-63

SHEET 1 OF 2

2703