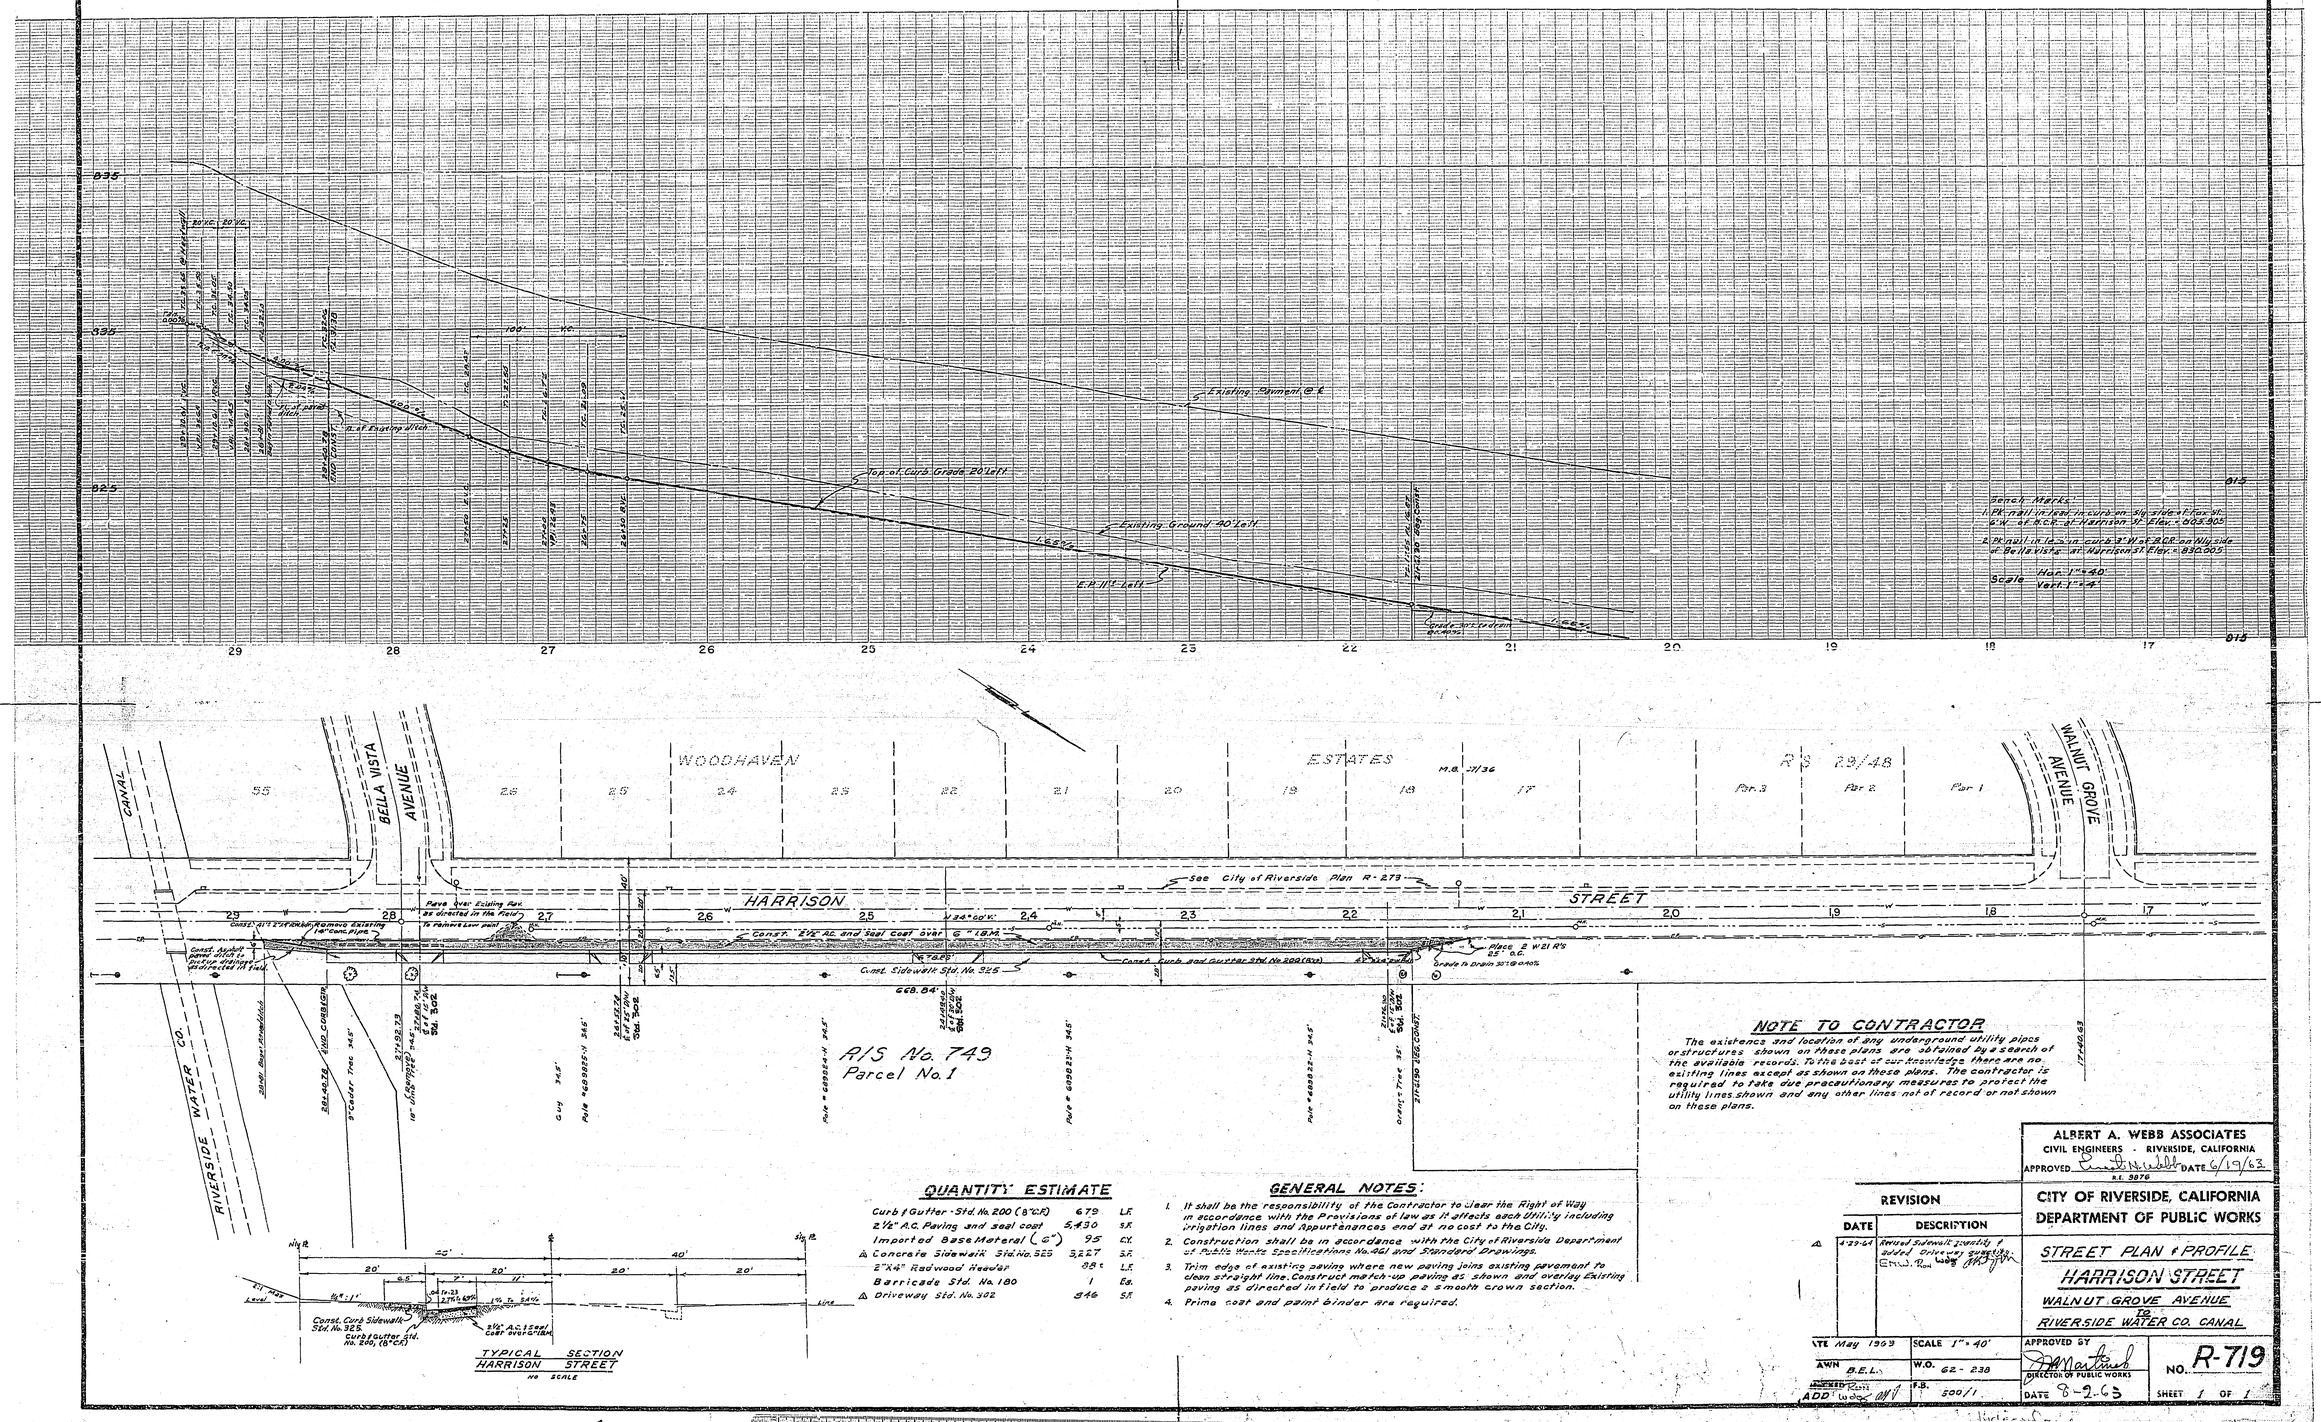

NOTE TO CONTRACTOR

The existence and location of any underground utility pipes or structures shown on these plans are obtained by a search of the available records. To the best of our knowledge there are no existing lines except as shown on these plans. The contractor is required to take due precautionary measures to protect the utility lines shown and any other lines not of record or not shown on these plans.

QUANTITY ESTIMATE

Curb & Gutter - Std. No. 200 (8" C.R.)	679	L.F.
2½" A.C. Paving and seal coat	5,430	S.F.
Imported Base Material (6")	95	C.Y.
△ Concrete Sidewalk Std. No. 325	3,227	S.F.
2"X4" Redwood Header	88	L.F.
Barricade Std. No. 180	1	Ea.
△ Driveway Std. No. 302	346	S.F.

GENERAL NOTES:

1. It shall be the responsibility of the Contractor to clear the Right of Way in accordance with the Provisions of law as it affects each Utility including irrigation lines and Appurtenances and at no cost to the City.
2. Construction shall be in accordance with the City of Riverside Department of Public Works Specifications No. 461 and Standard Drawings.
3. Trim edge of existing paving where new paving joins existing pavement to clean straight line. Construct match-up paving as shown and overlay Existing paving as directed in field to produce a smooth crown section.
4. Prime coat and paint binder are required.

ALBERT A. WEBB ASSOCIATES
CIVIL ENGINEERS - RIVERSIDE, CALIFORNIA
APPROVED [signature] DATE 6/19/63
R.E. 9876

CITY OF RIVERSIDE, CALIFORNIA
DEPARTMENT OF PUBLIC WORKS

STREET PLAN & PROFILE
HARRISON STREET
WALNUT GROVE AVENUE
TO
RIVERSIDE WATER CO. CANAL

REVISION		
	DATE	DESCRIPTION
△	4-29-64	Revised Sidewalk quantity & added Driveway quantity. EMW. Ron Wdg [signature]

DATE May 1963	SCALE 1" = 40'	APPROVED BY [signature] DIRECTOR OF PUBLIC WORKS	NO. R-719
DRAWN B.E.L.	W.O. 62-238		
CHECKED Ron ADD Wdg [signature]	F.B. 500/1	DATE 8-2-63	SHEET 1 OF 1