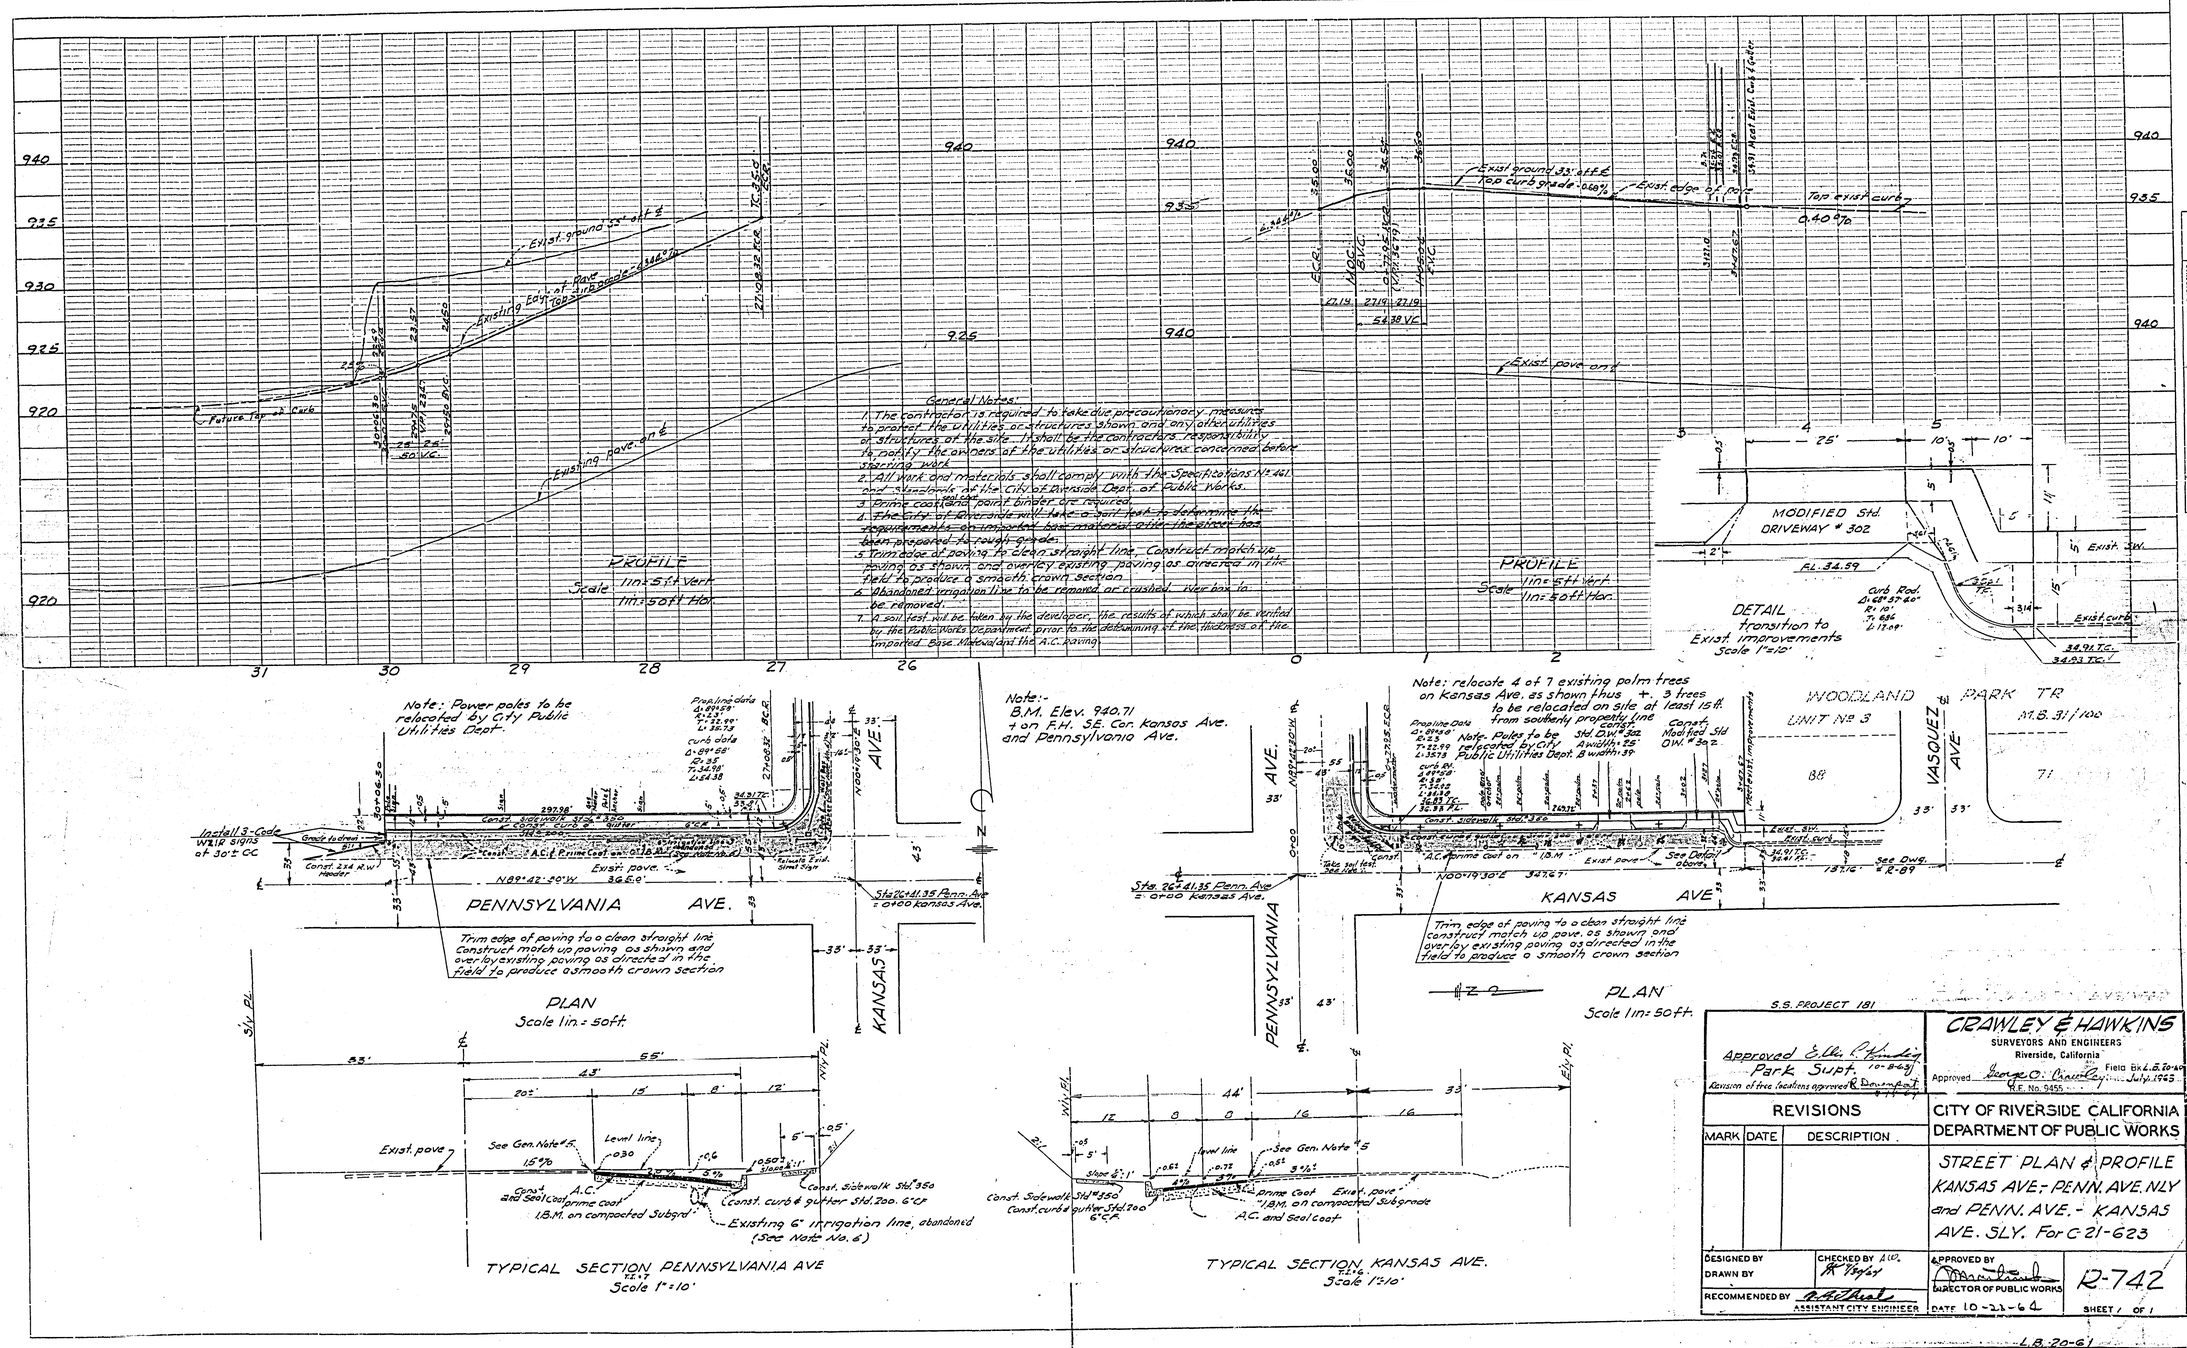

General Notes:

1. The contractor is required to take due precautionary measures to protect the utilities or structures shown and any other utilities or structures of the site. It shall be the contractors responsibility to notify the owners of the utilities or structures concerned before starting work.
2. All work and materials shall comply with the Specifications No. 461 and Standards of the City of Riverside Dept. of Public Works.
3. Prime coat and paint binder are required.
4. ~~The City of Riverside will take a soil test to determine the requirements on imported base material after the street has been prepared to rough grade.~~
5. Trim edge of paving to clean straight line, Construct match up paving as shown and overlay existing paving as directed in the field to produce a smooth crown section.
6. Abandoned irrigation line to be removed or crushed. Weir box to be removed.
7. A soil test will be taken by the developer, the results of which shall be verified by the Public Works Department prior to the determining of the thickness of the Imported Base Material and the A.C. paving.

S.S. PROJECT 181

Approved E. Ellis R. Kindley
Park Supt. 10-8-63
Revision of tree locations approved R. Dowmont 8-19-64

CRAWLEY & HAWKINS
SURVEYORS AND ENGINEERS
Riverside, California
Approved George O. Crawley
Field Bk. L.B. 20-60 July 1963
R.E. No. 9455

REVISIONS

MARK	DATE	DESCRIPTION

CITY OF RIVERSIDE CALIFORNIA
DEPARTMENT OF PUBLIC WORKS

STREET PLAN & PROFILE
KANSAS AVE.- PENN. AVE. NLY and PENN. AVE. - KANSAS AVE. SLY. For C-21-623

DESIGNED BY
DRAWN BY
CHECKED BY A.W. 8/30/64
RECOMMENDED BY A. A. Thiel ASSISTANT CITY ENGINEER
APPROVED BY [signature] DIRECTOR OF PUBLIC WORKS
DATE 10-23-64
R-742
SHEET 1 OF 1

L.B. 20-61