K+E PLATE 1, PLANEPROFILE
KEUFFEL & ESSER CO.
46 7024 HEMOLUENE® BLUELINE PRINT 3 MM

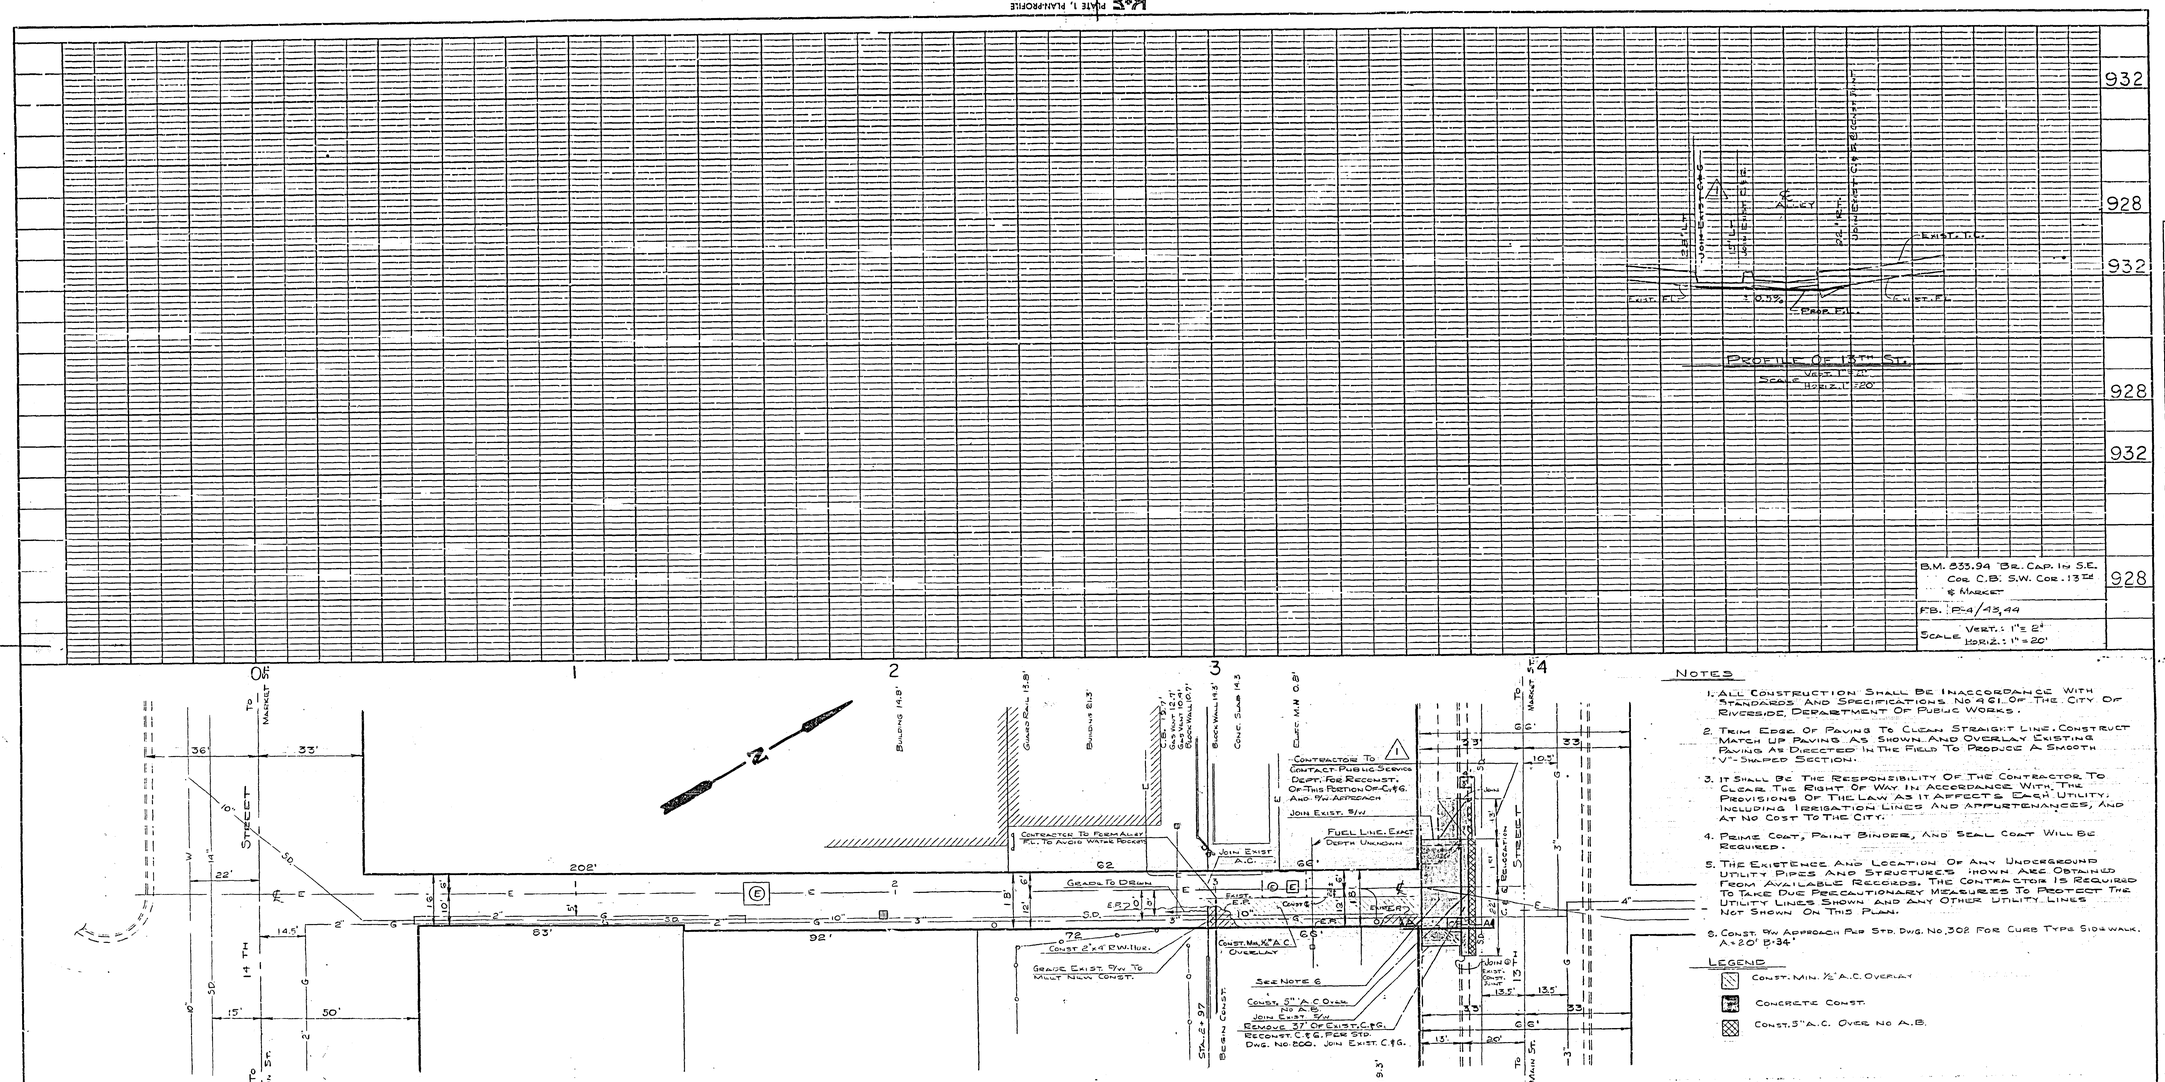

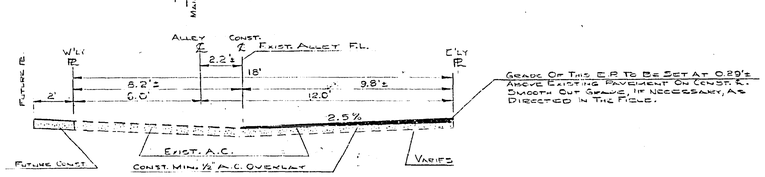

Typical Cross Section
Sta. 2+97.± To 3+65.±
No Scale

Notes

1. All Construction Shall Be In Accordance With Standards And Specifications No 461 Of The City Of Riverside, Department Of Public Works.
2. Trim Edge Of Paving To Clean Straight Line. Construct Match Up Paving As Shown And Overlay Existing Paving As Directed In The Field To Produce A Smooth "V"-Shaped Section.
3. It Shall Be The Responsibility Of The Contractor To Clear The Right Of Way In Accordance With The Provisions Of The Law As It Affects Each Utility, Including Irrigation Lines And Appurtenances, And At No Cost To The City.
4. Prime Coat, Paint Binder, And Seal Coat Will Be Required.
5. The Existence And Location Of Any Underground Utility Pipes And Structures Shown Are Obtained From Available Records. The Contractor Is Required To Take Due Precautionary Measures To Protect The Utility Lines Shown And Any Other Utility Lines Not Shown On This Plan.
6. Const. S/W Approach Per Std. Dwg. No. 302 For Curb Type Sidewalk. A=20' B=34'

Legend

- Const. Min. ½" A.C. Overlay
- Concrete Const.
- Const. 3" A.C. Over No A.B.

Mark	Date	Description
1	12-2-63	Deleted Reconst. Of 13 L.P. C.&G. And S/W Approach. A.W., OA Purdy

REVISIONS

CITY OF RIVERSIDE, CALIFORNIA
DEPARTMENT OF PUBLIC WORKS

ALLEY
13TH ST. TO 14TH ST.
E'LY. OF MARKET ST.

Designed by OAP
Drawn by A.W.
Checked by
Submitted by William D. Newhouse
Park Dept. Traffic Div.
Recommended by Assistant City Engineer
Approved by Director of Public Works
Date 11-26-63
Proj. No. 1012
R-747
Sheet 1 of 1

PROFILE: Surveyed, Plotted, Reviewed, Grades Checked, Staked, Noted, Structure Data Fms Ck'd, By, Date, Note Book, No.

PLAN: Surveyed, Plotted, Reviewed, Alignment Checked, Rt. of Way Checked, By, Date, Note Book, No.