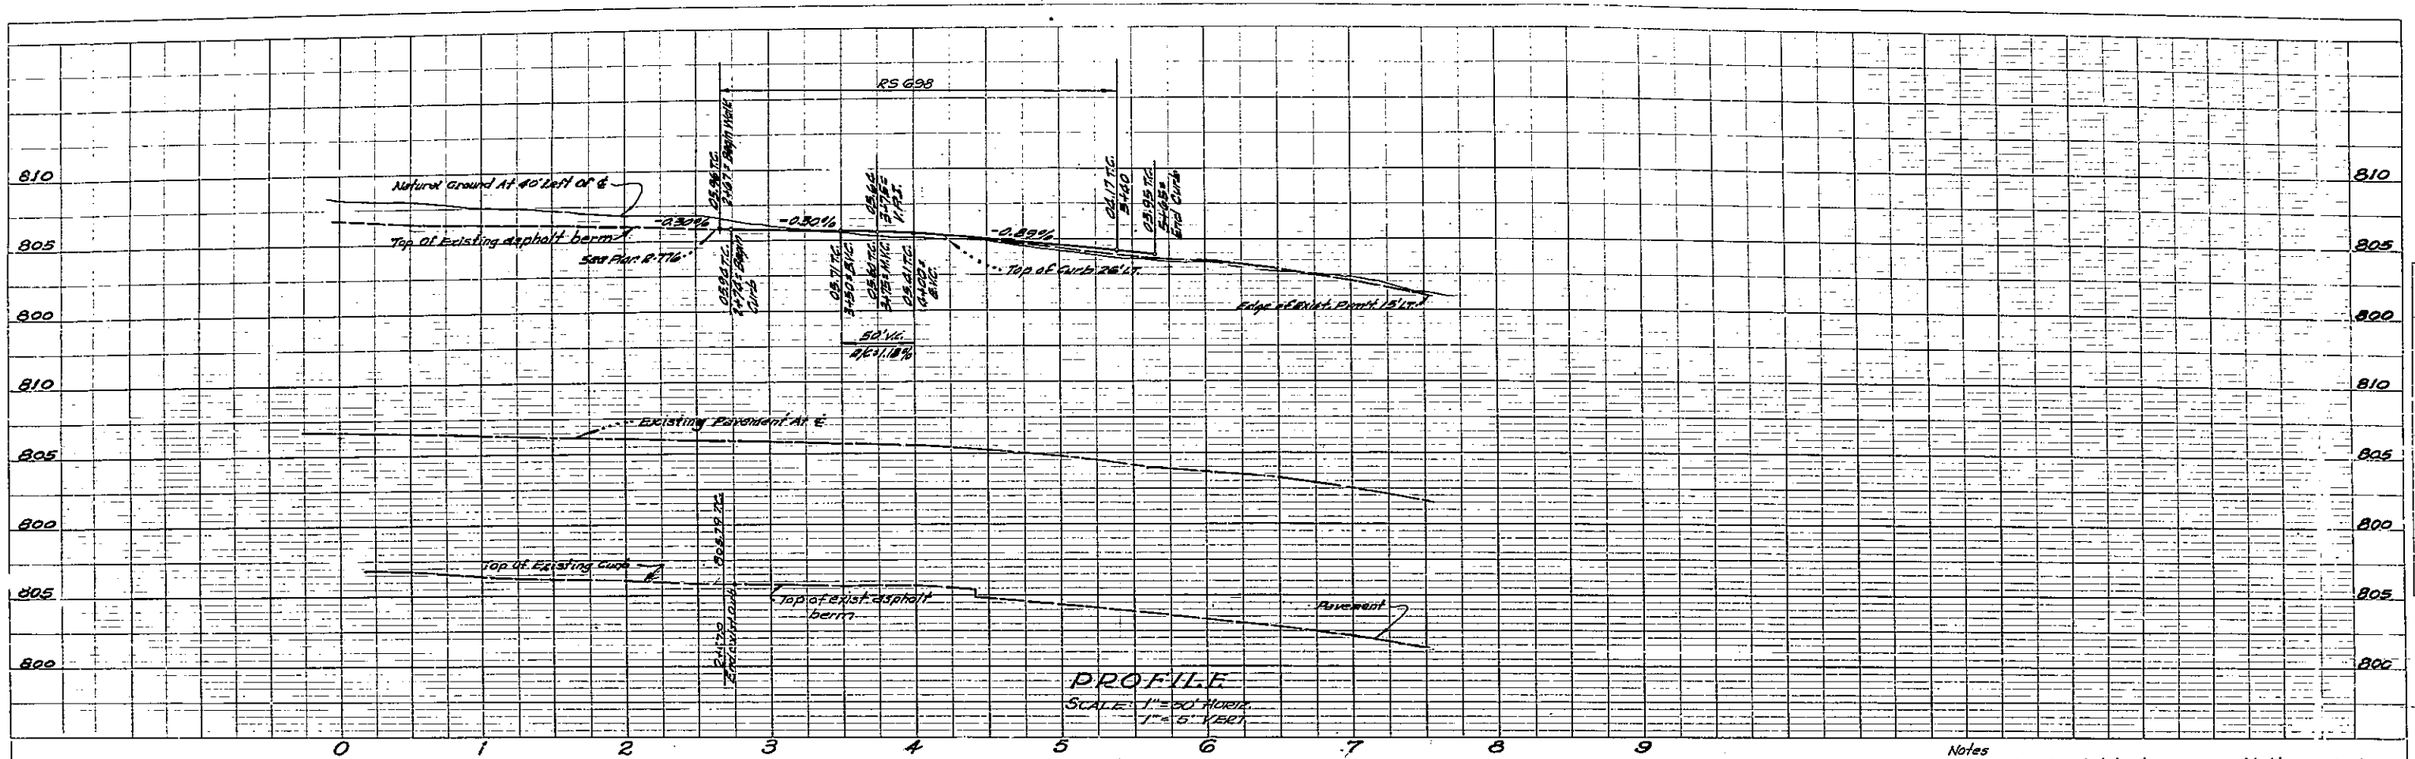

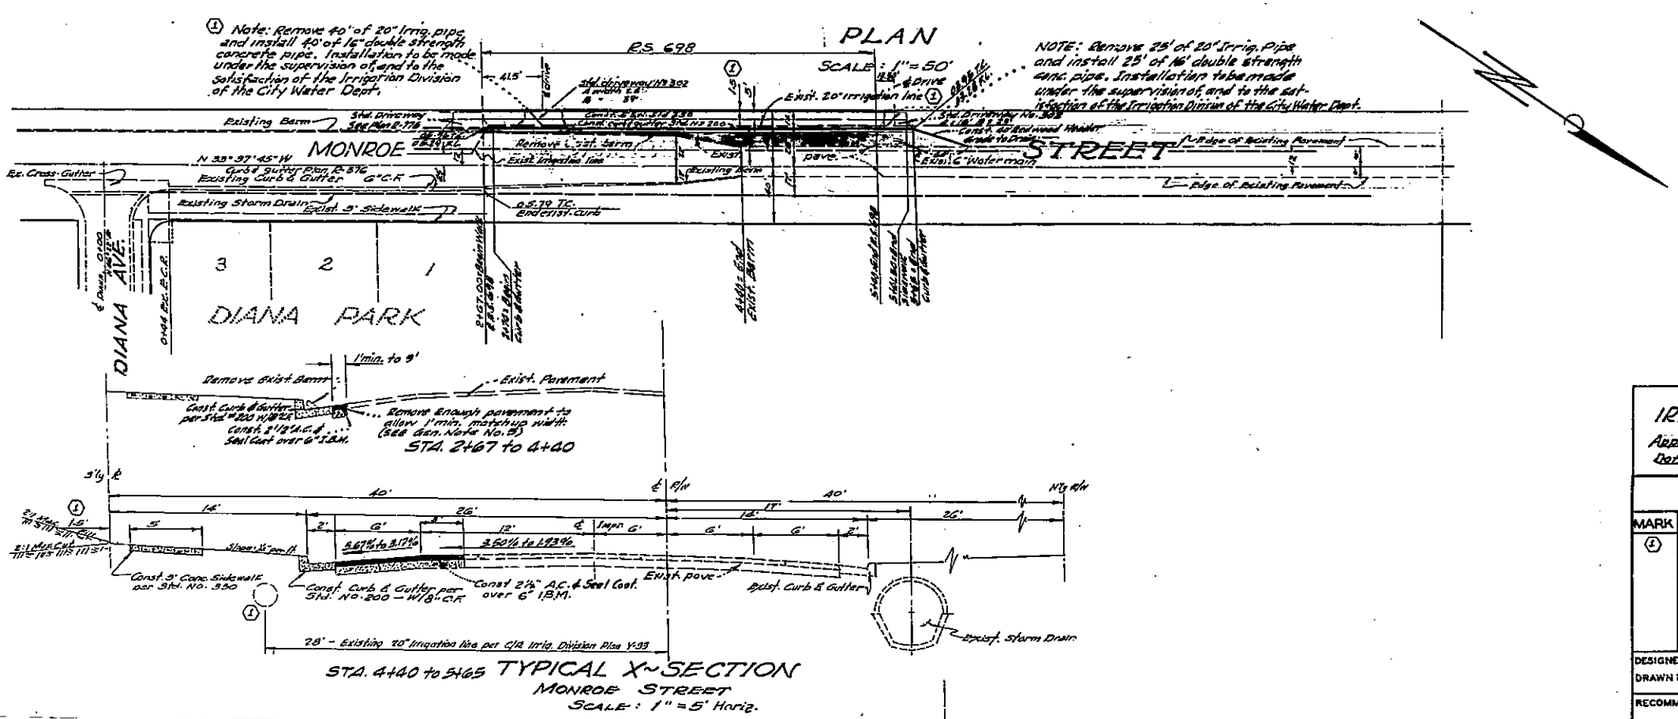

Notes
1. All work and materials shall comply with the specifications No. 461, Standards of the City of Riverside, Dept. of Public Works.
2. Prime coat, seal coat, and paint binder are required.
4. B.M. is + on bolt on F.H. of S.W. corner of Magnolia Ave and Monroe St. Elev. 781.78
5. Trim edge of existing paving to clean straight line construct matchup paving as shown and overlay existing paving as directed in the field to produce smooth crown section.
6. It shall be the responsibility of the contractor to clear the right of way in accordance with the provisions of law as it affects each utility, including irrigation lines and appurtenances and at no extra cost to the City of Riverside

IRRIGATION DIV. Approved Howard L. Creson Date: 10/29/63	McKEE & CRAWLEY SURVEYORS AND ENGINEERS Riverside, California Approved George A. Crawley R.E. No. 9455 Field Bk. Date 7-3-63
REVISIONS	CITY OF RIVERSIDE CALIFORNIA DEPARTMENT OF PUBLIC WORKS
MARK / DATE / DESCRIPTION	STREET PLAN & PROFILE R/S 698 MONROE STREET BETWEEN DIANA & MAGNOLIA
1 / 2-24-64 / Change sidewalk location from 0.5' off ℄ to 1.5' off ℄ and change location of irrigation per N.L. Creason R.C.	
6-16-64 / Change limits of Const. and Revise Grade Line & Typical Section. Ron George A. Crawley R.E. 9455	
DESIGNED BY / DRAWN BY / CHECKED BY Ron / Luigi JLK	APPROVED BY / DIRECTOR OF PUBLIC WORKS
RECOMMENDED BY / ASSISTANT CITY ENGINEER	DATE Nov 6, 1963
	R-749 SHEET 1 OF 1

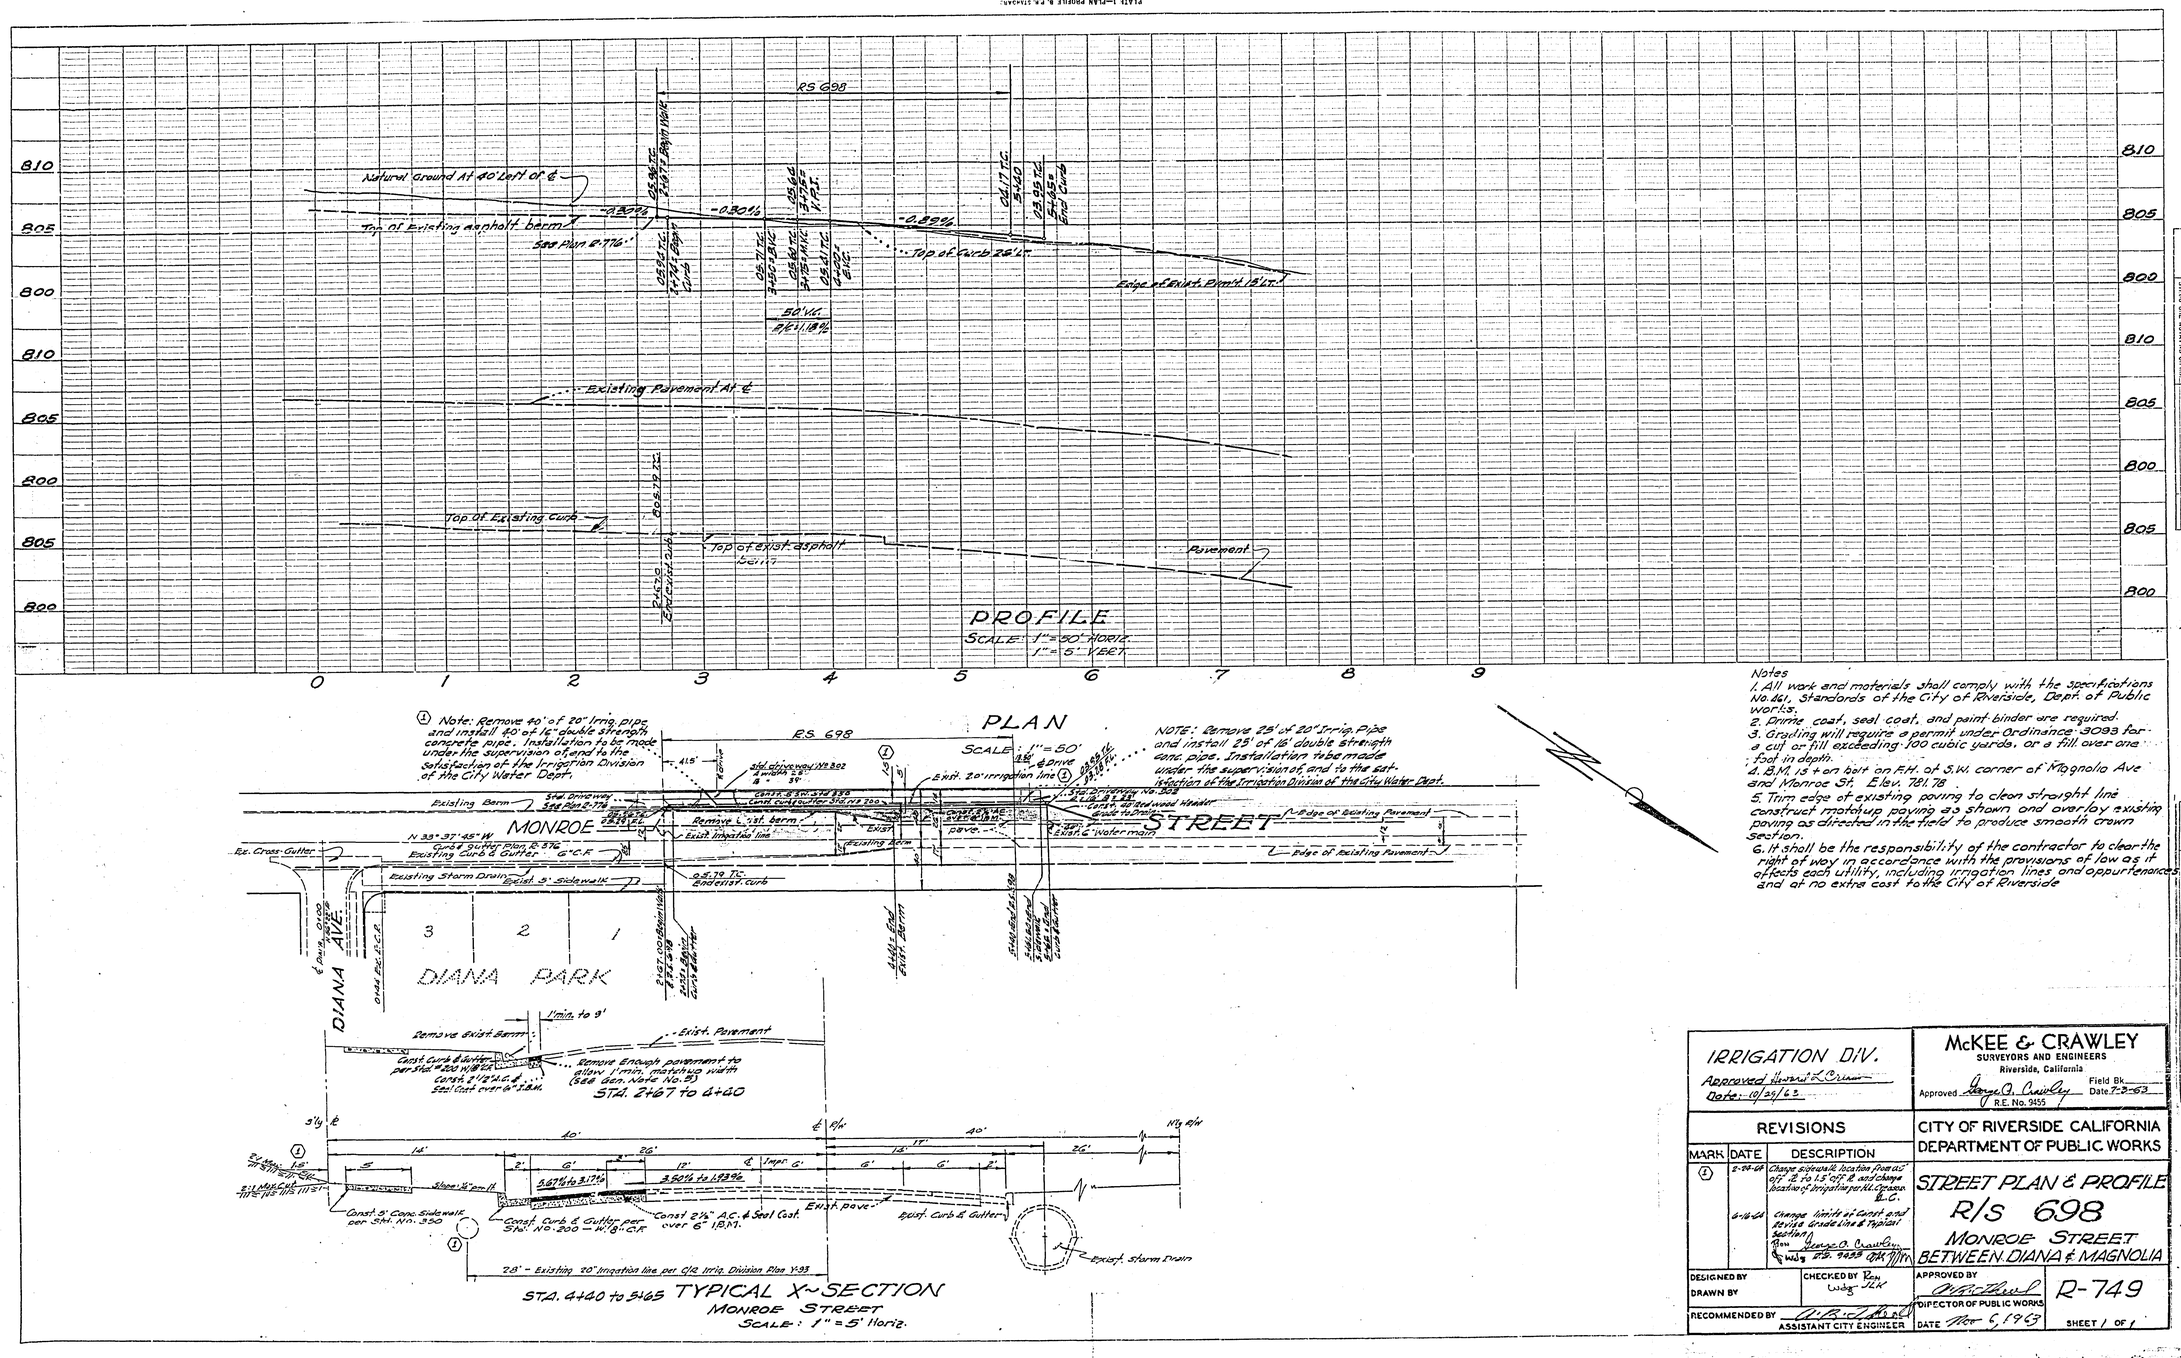

Notes
1. All work and materials shall comply with the specifications No. 461, Standards of the City of Riverside, Dept. of Public works.
2. Prime coat, seal coat, and paint binder are required.
3. Grading will require a permit under Ordinance 3093 for a cut or fill exceeding 100 cubic yards, or a fill over one foot in depth.
4. B.M. is + on bolt on F.H. of S.W. corner of Magnolia Ave and Monroe St. Elev. 781.78
5. Trim edge of existing paving to clean straight line construct matchup paving as shown and overlay existing paving as directed in the field to produce smooth crown section.
6. It shall be the responsibility of the contractor to clear the right of way in accordance with the provisions of law as it affects each utility, including irrigation lines and appurtenances and at no extra cost to the City of Riverside

IRRIGATION DIV.	McKEE & CRAWLEY SURVEYORS AND ENGINEERS Riverside, California
Approved Howard L. Crum Date: 10/29/63	Approved George A. Crawley R.E. No. 9455 Field Bk. Date 7-3-63

REVISIONS			CITY OF RIVERSIDE CALIFORNIA DEPARTMENT OF PUBLIC WORKS
MARK	DATE	DESCRIPTION	STREET PLAN & PROFILE R/S 698 MONROE STREET BETWEEN DIANA & MAGNOLIA
1	2-24-64	Change sidewalk location from 0.5' off ℄ to 1.5' off ℄ and change location of irrigation per H.L. Crum R.C.	
	6-16-64	Change limits of Const. and Revise Grade Line & Typical Section Ron George A. Crawley Wdg R.E. 9455	

DESIGNED BY DRAWN BY	CHECKED BY Ron Wdg JLK	APPROVED BY DIRECTOR OF PUBLIC WORKS	R-749
RECOMMENDED BY ASSISTANT CITY ENGINEER		DATE Nov 6, 1963	SHEET 1 OF 1