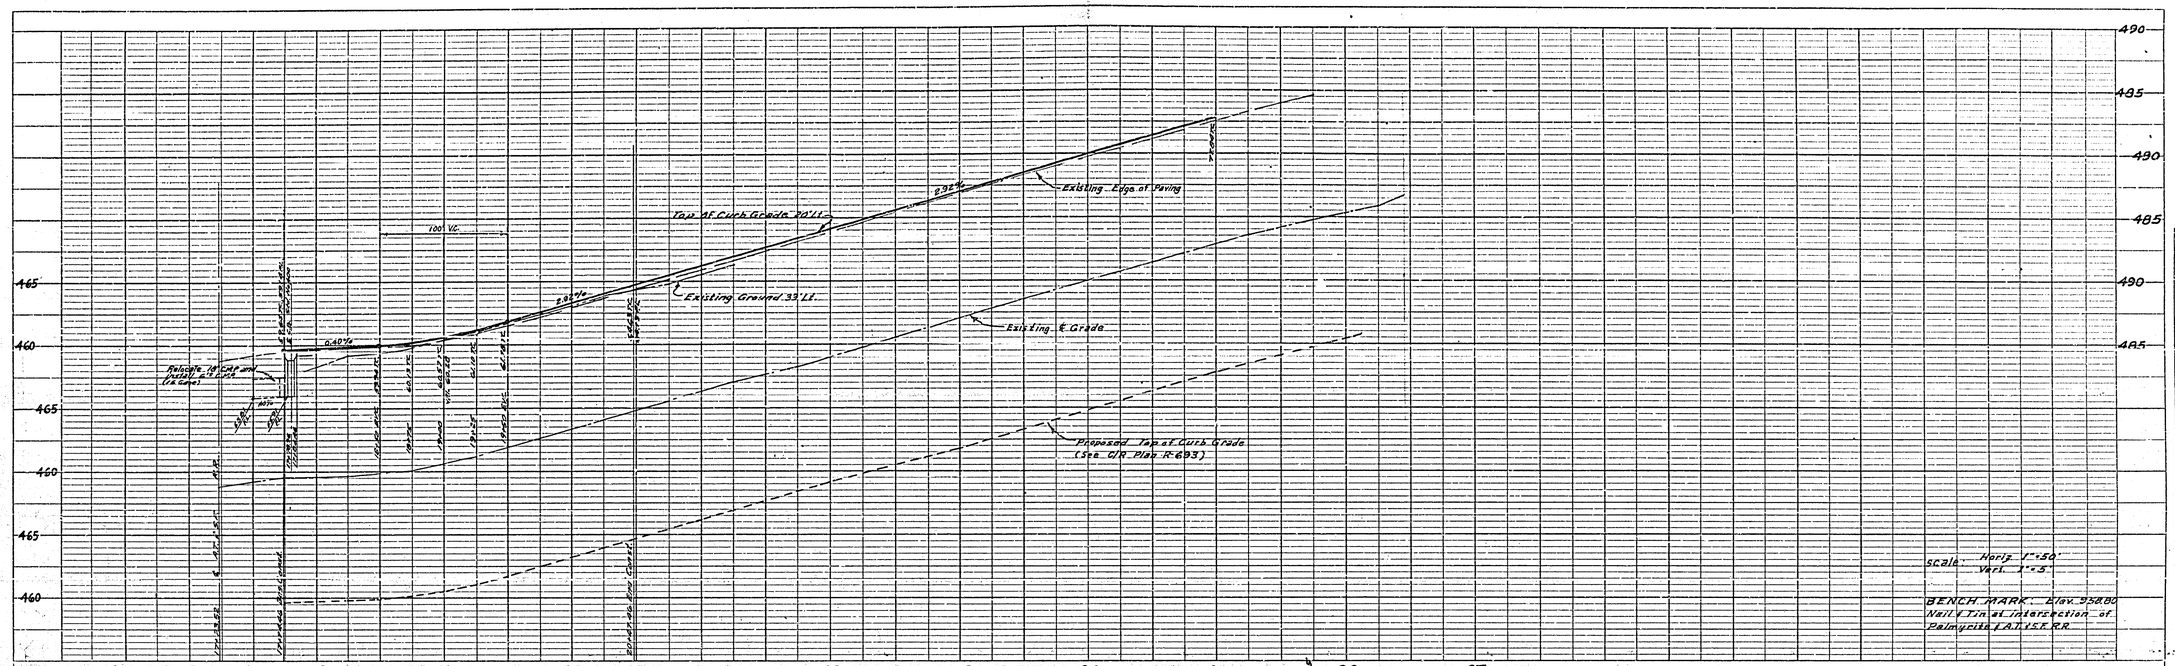

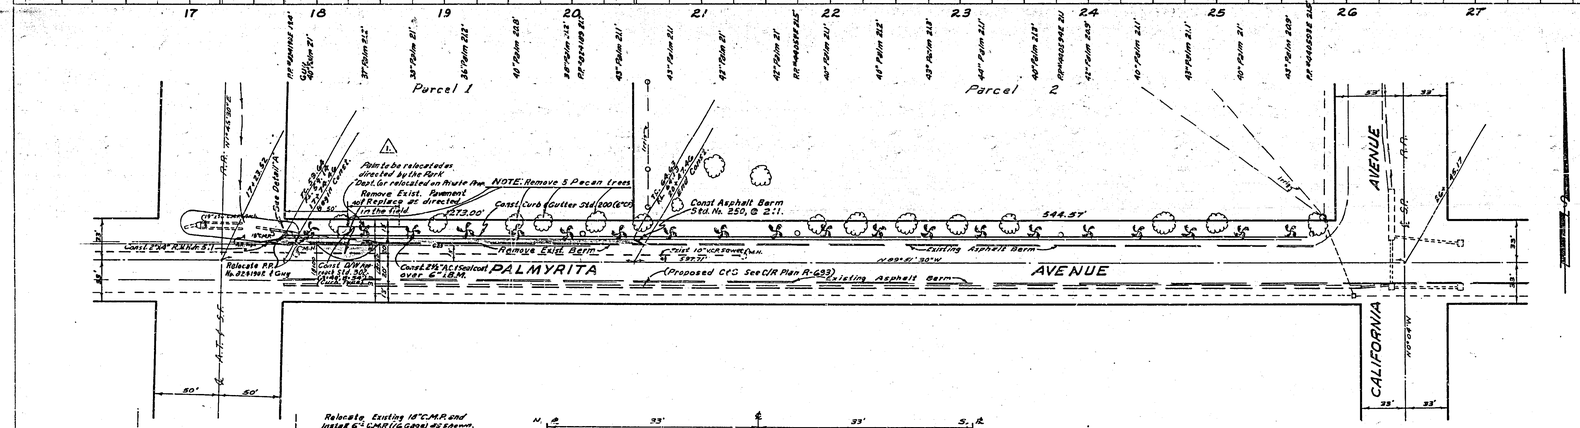

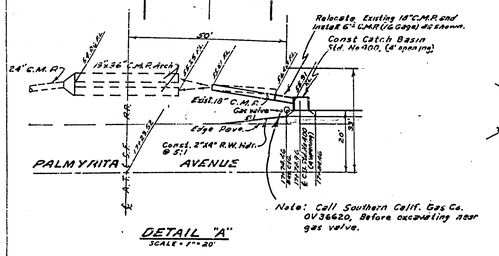

DETAIL "A"
SCALE: 1"=20'

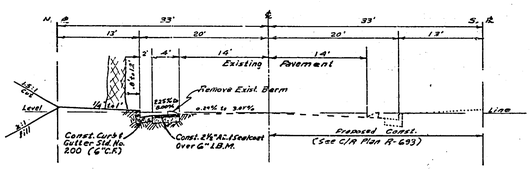

TYPICAL SECTION
PALMYRITA AVENUE
NO SCALE

QUANTITY ESTIMATE

Standard No. 200 Curb & Gutter (6" C.P.)	263	L.F.
Standard No. 250 Berm	10±	L.F.
2"x4" R.W. Hdr.	20±	L.F.
2½" A.C. & Sealcoat	1,373	S.F.
6" Imported Base Material	25	C.Y.
Standard No. 400 Catch Basin (4' opening)	1	Ea.
18" C.M.P.	6±	L.F.
Driveway Approach Standard No. 302	600	S.F.

GENERAL NOTES:

1. Construction to be in accordance with Standards and Specifications No. 461 of the City of Riverside, Dept. of Public Works.
2. Trim edge of existing paving where new paving joins existing pavement, to clean, straight line. Construct match-up paving as shown and overlay existing paving as directed in the field to produce a smooth crown section.
3. Prime coat & paint binder are required.
4. It shall be the responsibility of the Contractor to clear the Right of way in accordance with the provisions of law as it affects each utility, including irrigation lines and appurtenances and at no extra cost to the City of Riverside.
5. Location of curb & gutter, driveway approaches to be determined at time of construction for flat, high spot, as approved by the Traffic Dept.

Approved: Ellen R. Hendricks
PARK SUPERINTENDENT
Date: 3-30-64

ALBERT A. WEBB ASSOCIATES
CIVIL ENGINEERS - RIVERSIDE, CALIFORNIA
APPROVED Emil N. Webb DATE 10/2/63
R.E. 9874

REVISION		
MARK	DATE	DESCRIPTION
1	3/26/64	Added D/W, Remove Pecan trees, Relocated Palm. EN Webb

CITY OF RIVERSIDE, CALIFORNIA
DEPARTMENT OF PUBLIC WORKS

STREET PLAN & PROFILE

PALMYRITA AVENUE
Between A.T. & S.F. R.R. & California

DATE Oct. 1963	SCALE 1" = 50'	APPROVED BY	
DRAWN B.E.L.	W.O. 63-235	DIRECTOR OF PUBLIC WORKS	NO. R-754
CHECKED A.D.D.	F.B. 361/65-73	DATE 11-19-63	SHEET 1 OF 1

Dwg. No. 63-235-A

PROFILE: SURVEYED ..... / PLOTTED ..... / GRADES CHECKED ..... / B.M.'S NOTED ..... / STRUCTURE NOTES ..... / CHKD. ..... / NOTE BOOK ..... / NO. ..... / BY ..... / DATE .....

PLAN: NOTE BOOK NO. ..... / SURVEYED ..... / PLOTTED ..... / ALIGNMENT CHECKED ..... / RT. OF WAY CHECKED ..... / BY ..... / DATE .....

PLATE 1—PLAN PROFILE & P. & S. STANDARD
THE PROBSTFIELD & HOFF CO., CHICAGO