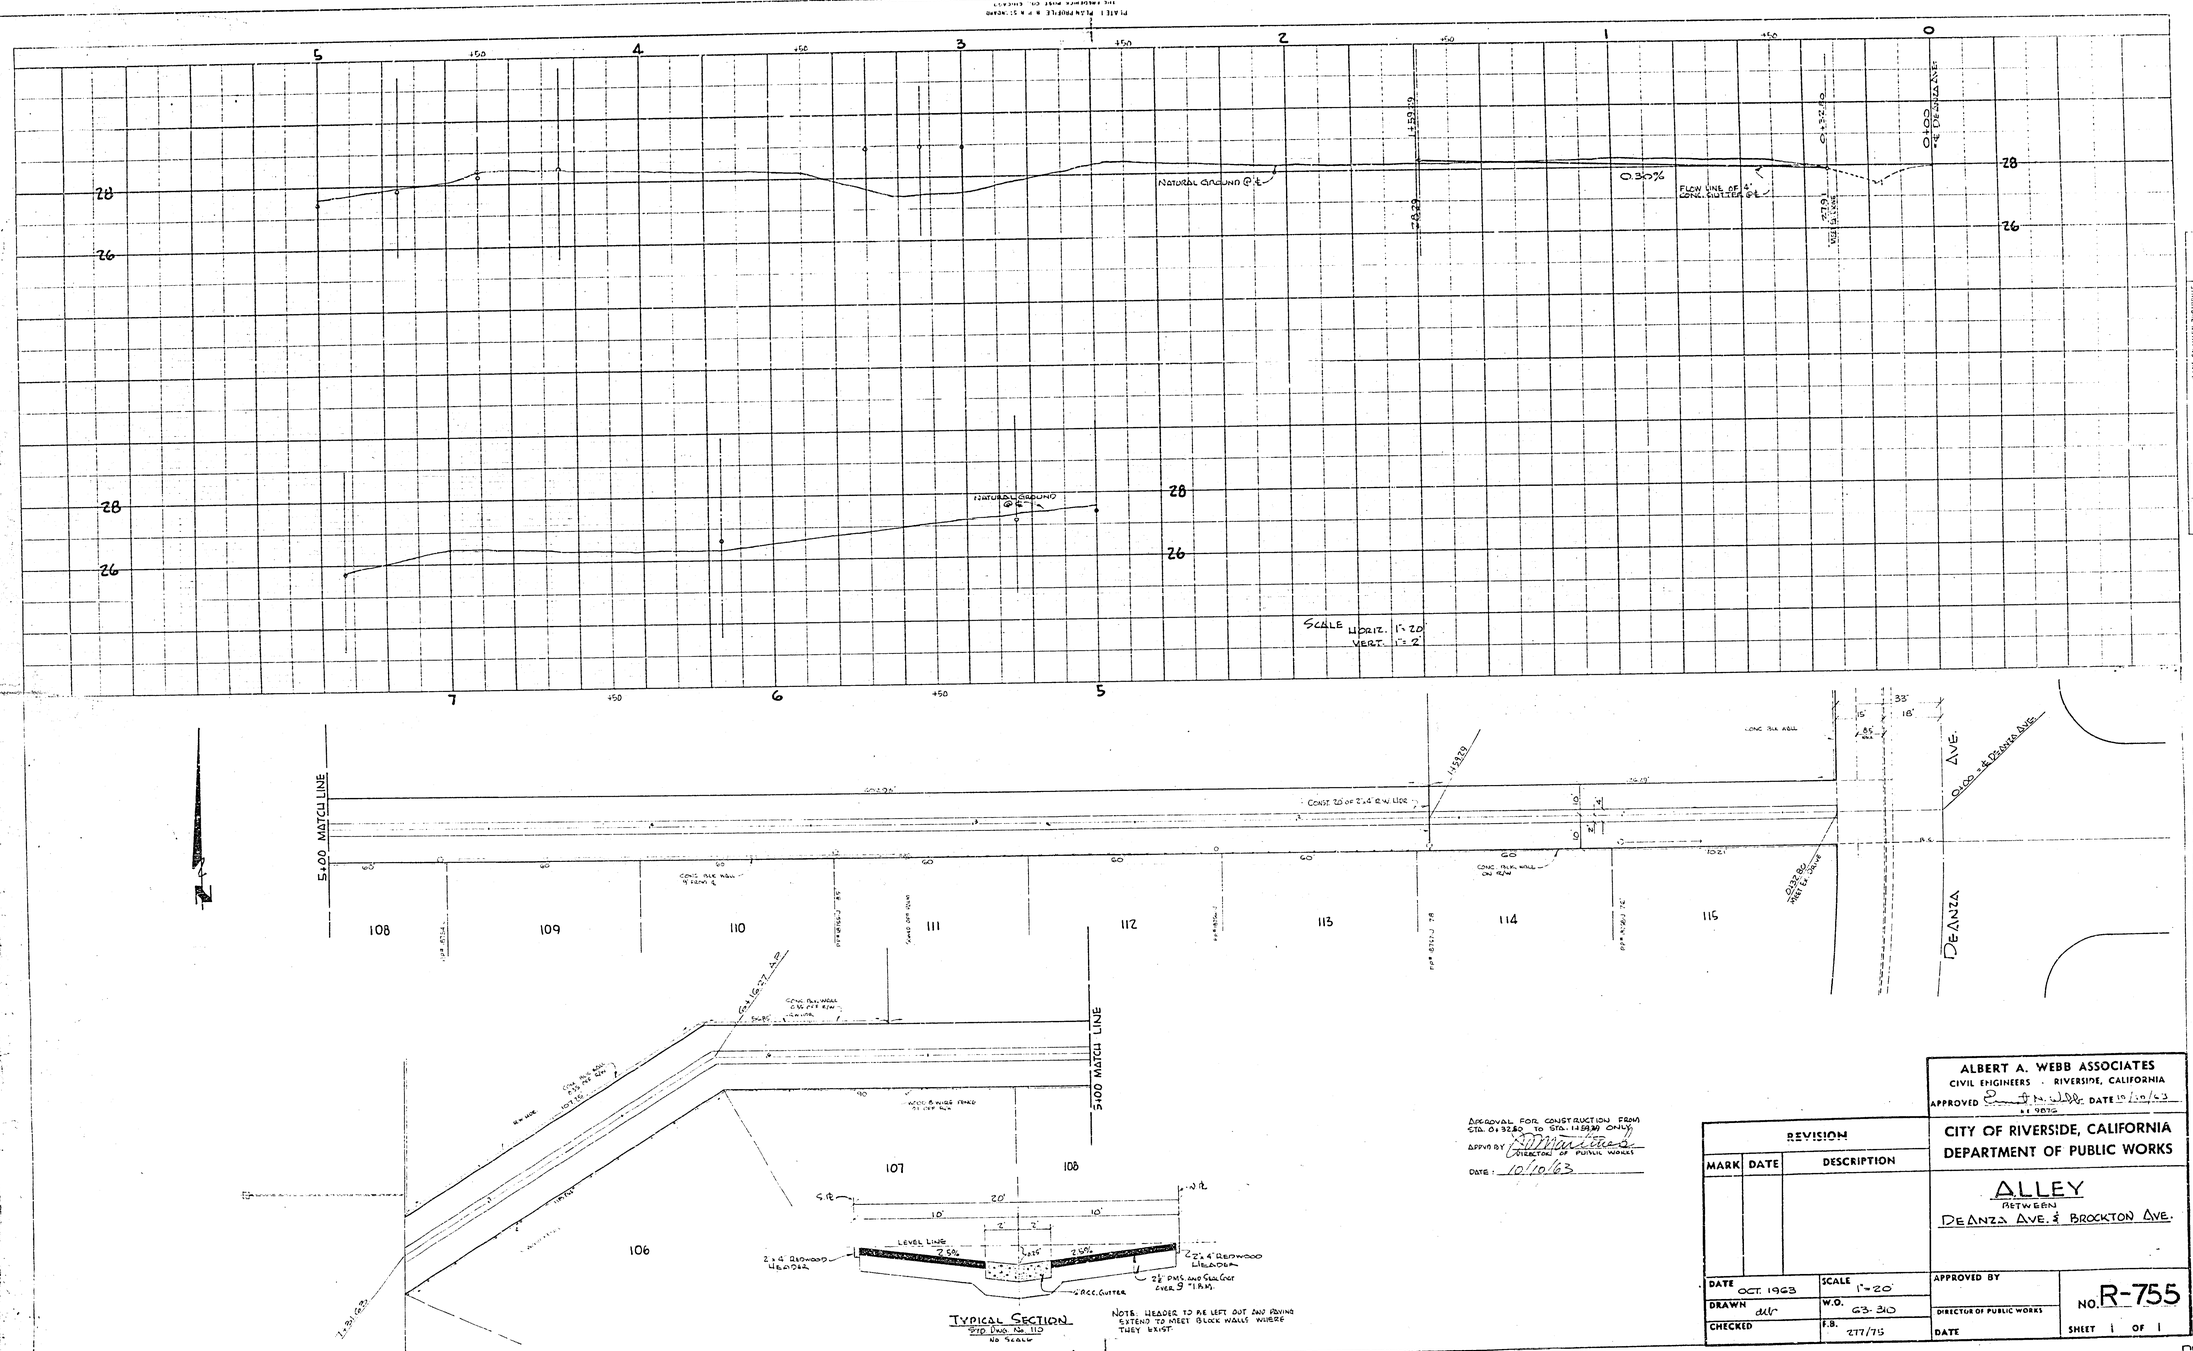

APPROVAL FOR CONSTRUCTION FROM STA. 0+32.80 TO STA. 1+58.30 ONLY
APPVD BY [signature] DIRECTOR OF PUBLIC WORKS
DATE: 10/10/63

REVISION		
MARK	DATE	DESCRIPTION

ALBERT A. WEBB ASSOCIATES
CIVIL ENGINEERS · RIVERSIDE, CALIFORNIA
APPROVED [signature] DATE 10/10/63
BY WRD

CITY OF RIVERSIDE, CALIFORNIA
DEPARTMENT OF PUBLIC WORKS

ALLEY
BETWEEN
DE ANZA AVE. & BROCKTON AVE.

DATE OCT. 1963	SCALE 1"=20'	APPROVED BY	NO. R-755
DRAWN dlr	W.O. 63-310	DIRECTOR OF PUBLIC WORKS	
CHECKED	F.B. 277/75	DATE	SHEET 1 OF 1

DWG. No. 63-310 A

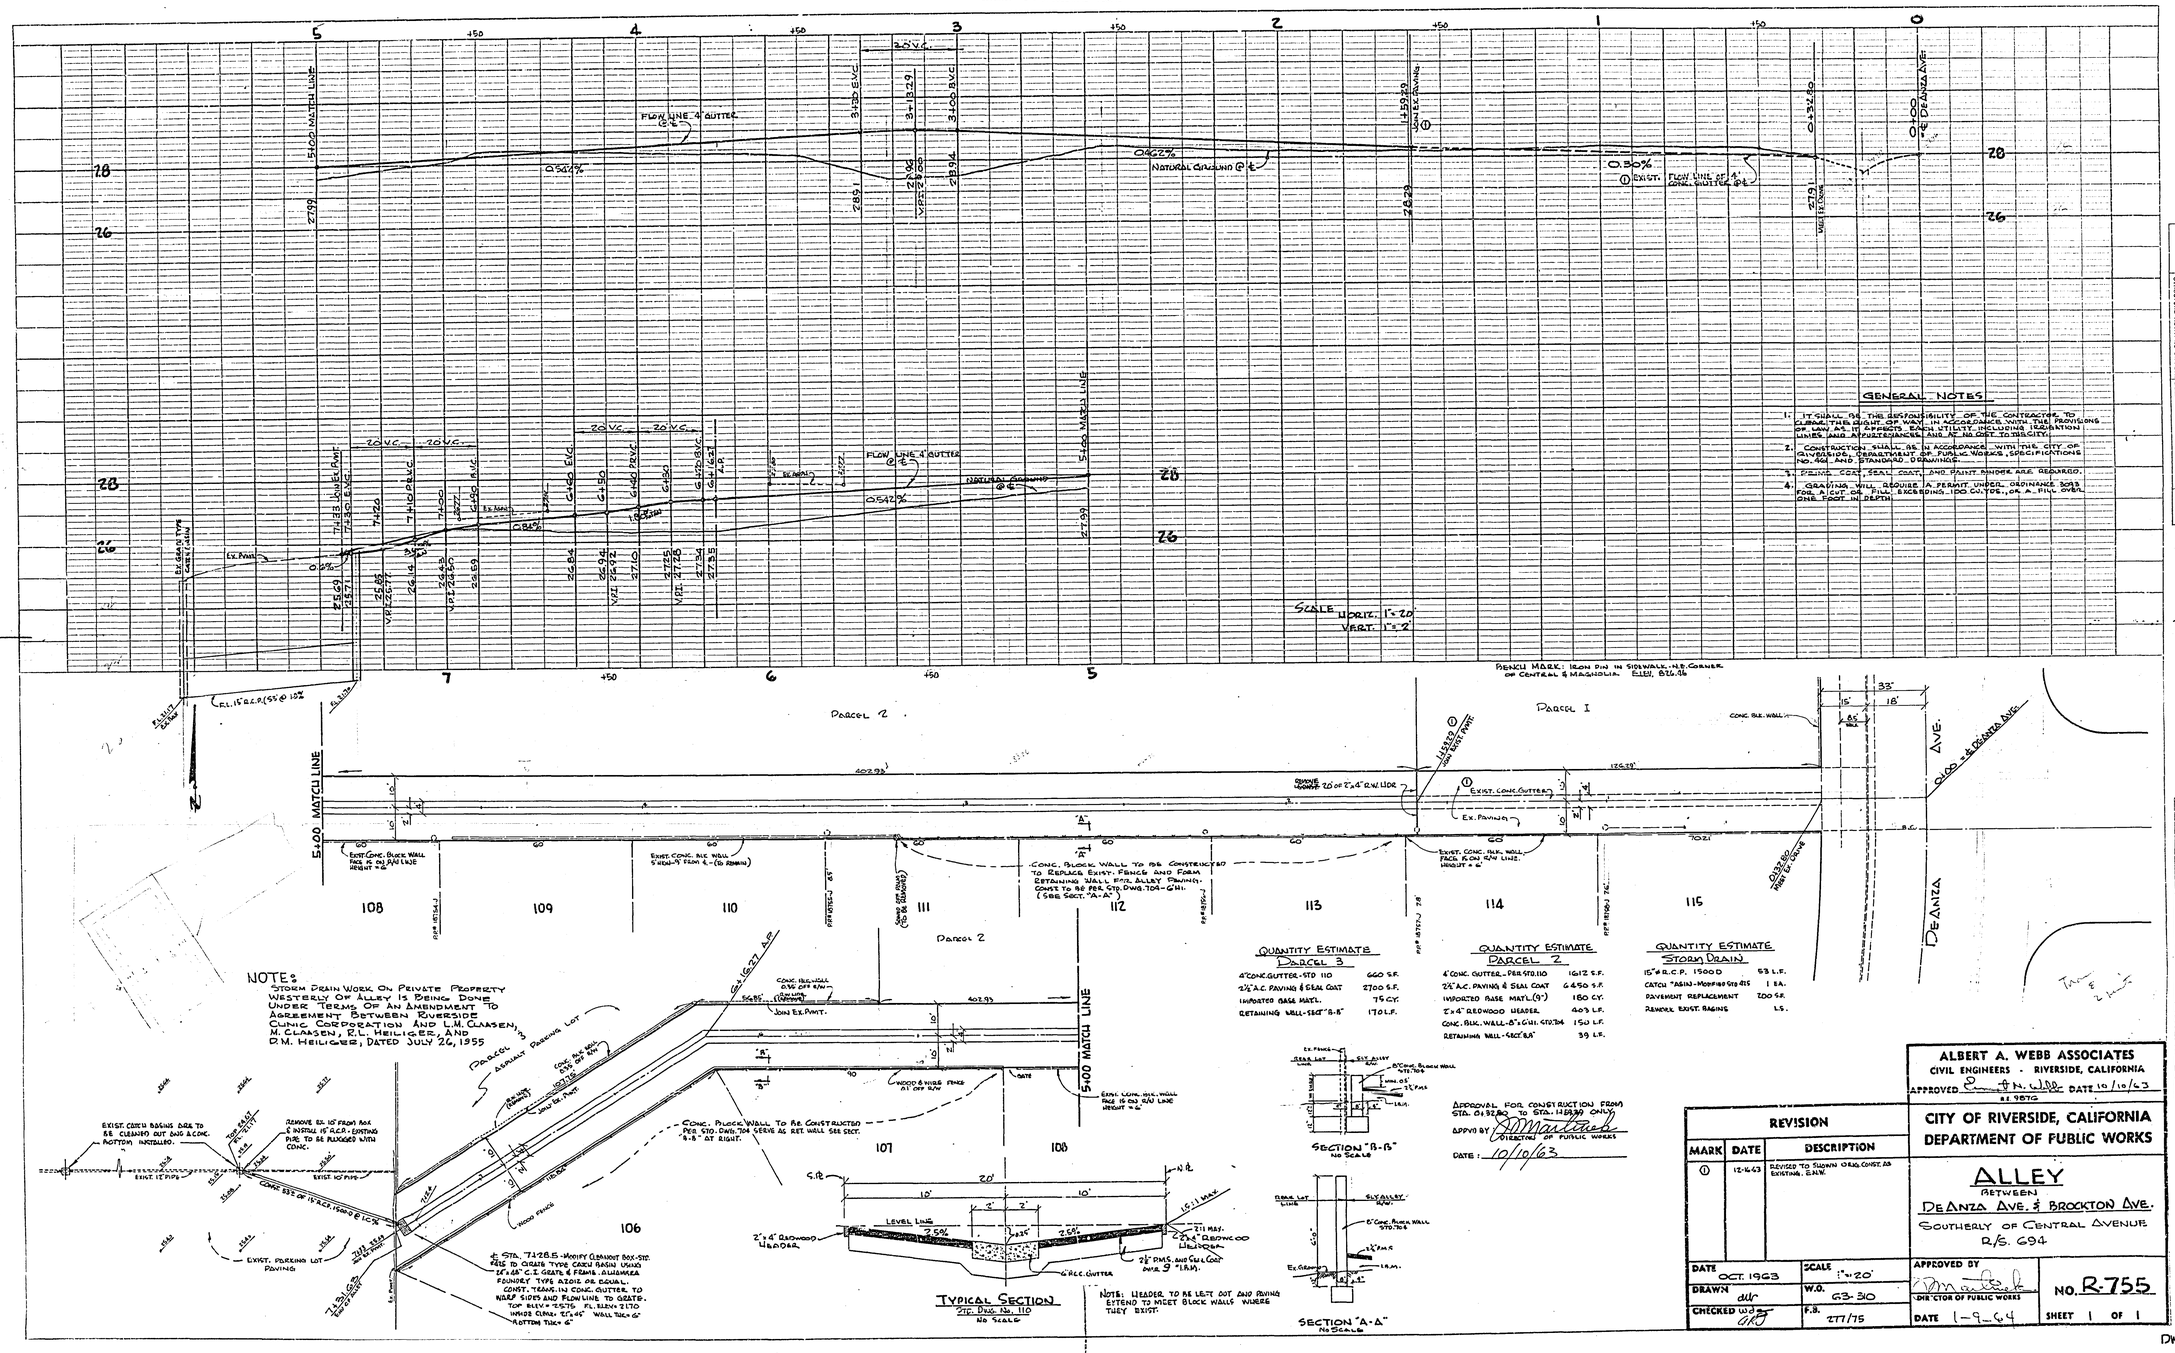

GENERAL NOTES

1. IT SHALL BE THE RESPONSIBILITY OF THE CONTRACTOR TO CLEAR THE RIGHT OF WAY IN ACCORDANCE WITH THE PROVISIONS OF LAW AS IT AFFECTS EACH UTILITY INCLUDING IRRIGATION LINES AND APPURTENANCES AND AT NO COST TO THE CITY.
2. CONSTRUCTION SHALL BE IN ACCORDANCE WITH THE CITY OF RIVERSIDE, DEPARTMENT OF PUBLIC WORKS, SPECIFICATIONS NO. 464 AND STANDARD DRAWINGS.
3. PRIME COAT, SEAL COAT, AND PAINT UNDER ARE REQUIRED.
4. GRADING WILL REQUIRE A PERMIT UNDER ORDINANCE 3093 FOR A CUT OR FILL EXCEEDING 100 CU.YDS., OR A FILL OVER ONE FOOT IN DEPTH.

QUANTITY ESTIMATE PARCEL 3

4" CONC. GUTTER - STD 110	660 S.F.
2½" A.C. PAVING & SEAL COAT	2700 S.F.
IMPORTED BASE MAT'L.	75 C.Y.
RETAINING WALL - SECT "B-B"	170 L.F.

QUANTITY ESTIMATE PARCEL 2

4" CONC. GUTTER - PER STD. 110	1612 S.F.
2½" A.C. PAVING & SEAL COAT	6450 S.F.
IMPORTED BASE MAT'L. (9")	180 C.Y.
2"x4" REDWOOD HEADER	403 L.F.
CONC. BLK. WALL - 8" x 6'H. STD. 704	150 L.F.
RETAINING WALL - SECT "B-B"	39 L.F.

QUANTITY ESTIMATE STORM DRAIN

15" ø R.C.P. 15000	53 L.F.
CATCH "ASIN" - MODIFIED STD 415	1 EA.
PAVEMENT REPLACEMENT	200 S.F.
REMOVE EXIST. BASINS	L.S.

APPROVAL FOR CONSTRUCTION FROM STA. 0+32.80 TO STA. 1+59.29 ONLY

APPVD BY [signature] DIRECTOR OF PUBLIC WORKS

DATE: 10/10/63

ALBERT A. WEBB ASSOCIATES
CIVIL ENGINEERS - RIVERSIDE, CALIFORNIA
APPROVED [signature] DATE 10/10/63
R.E. 9876

CITY OF RIVERSIDE, CALIFORNIA
DEPARTMENT OF PUBLIC WORKS

ALLEY
BETWEEN
DEANZA AVE. & BROCKTON AVE.
SOUTHERLY OF CENTRAL AVENUE
R/S. 694

REVISION		
MARK	DATE	DESCRIPTION
①	12-16-63	REVISED TO SHOWN ORIG. CONST. AS EXISTING. E.N.W.

DATE OCT. 1963	SCALE 1"=20'	APPROVED BY [signature] DIRECTOR OF PUBLIC WORKS	NO. R-755
DRAWN dlr	W.O. 63-310		
CHECKED wdg GRJ	F.B. 277/75	DATE 1-9-64	SHEET 1 OF 1

DWG. No. 63-310 A