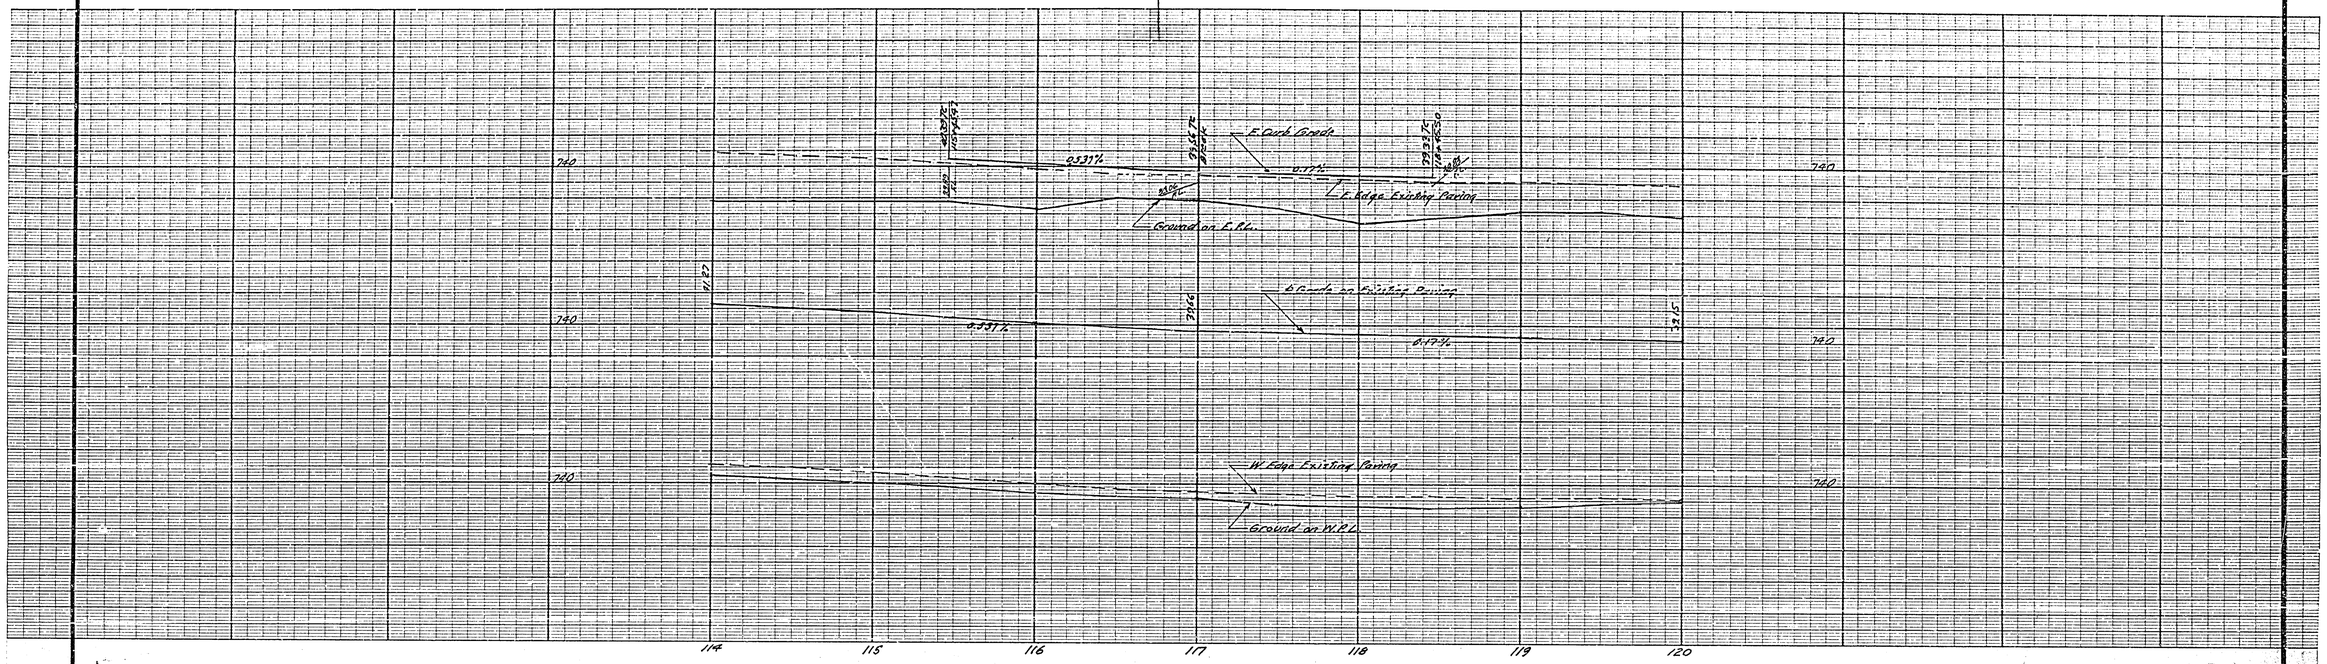


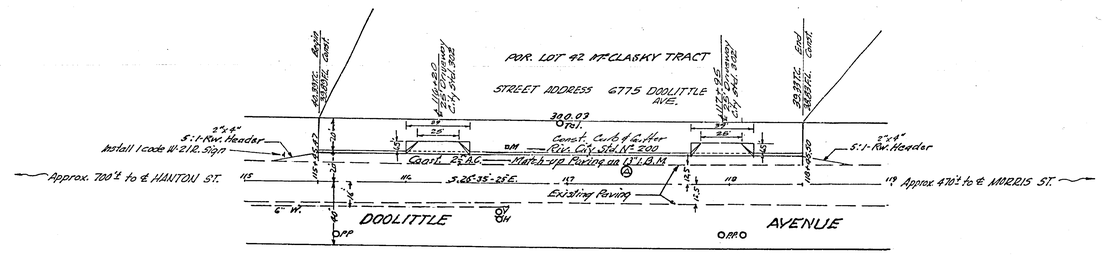


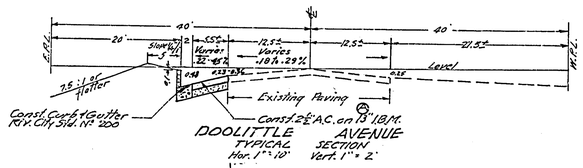


## GENERAL NOTES

1. All Construction shall be in accordance with Standards and Specifications No. 461 of the City of Riverside Department of Public Works.
2. It shall be the responsibility of the Contractor to clear the Right of Way in accordance with the provisions of law as it affects each utility including irrigation lines and appurtenances, and at no extra cost to the City of Riverside.
3. The City of Riverside will take a soil test to determine the Import Base Material thickness after the street has been rough graded. ~~Prime Coat and paint binder will be required.~~
4. Trim edge of existing paving to a clean straight line. Construct match-up paving and overlap on existing paving as directed in the field to produce a smooth crown surface.
5. Seal Coat, Prime Coat, and Paint binder required.
6. Grading will require a permit under Ordinance 3093 for a cut or fill exceeding 100 cubic yards, or a fill over one foot in depth.

B.M.-R.R. Spike in P.P. No. 612416 E. on West side of Doolittle Avenue. Elev.: 740.722 - City.

J. F. DAVIDSON-CIVIL ENGINEER
R.E. No 862
RIVERSIDE, CALIFORNIA
APPROVED BY J. F. Davidson DATE 10-17-62

REVISIONS

| MARK | DATE | DESCRIPTION |
|---|---|---|
| A | 2-11-64 | Add 13" I.B.M. J.F.D. Rev. wdg OR J. [illegible] |

CITY OF RIVERSIDE, CALIFORNIA
DEPARTMENT OF PUBLIC WORKS

STREET PLAN & PROFILE
DOOLITTLE AVENUE
FOR: HUNTER & STEVENS
HORIZ. SCALE 1" = 40' VERT. SCALE 1" = 4'

DESIGNED BY
DRAWN BY
CHECKED BY Ron Kay add wdg
RECOMMENDED BY A. R. [illegible] ASSISTANT CITY ENGINEER
APPROVED BY [illegible] Director of Public Works
DATE 12-2-63
NO. R-761
SHEET 1 OF 1

W.O. 11394 FR 756-62 / 819-70

2726