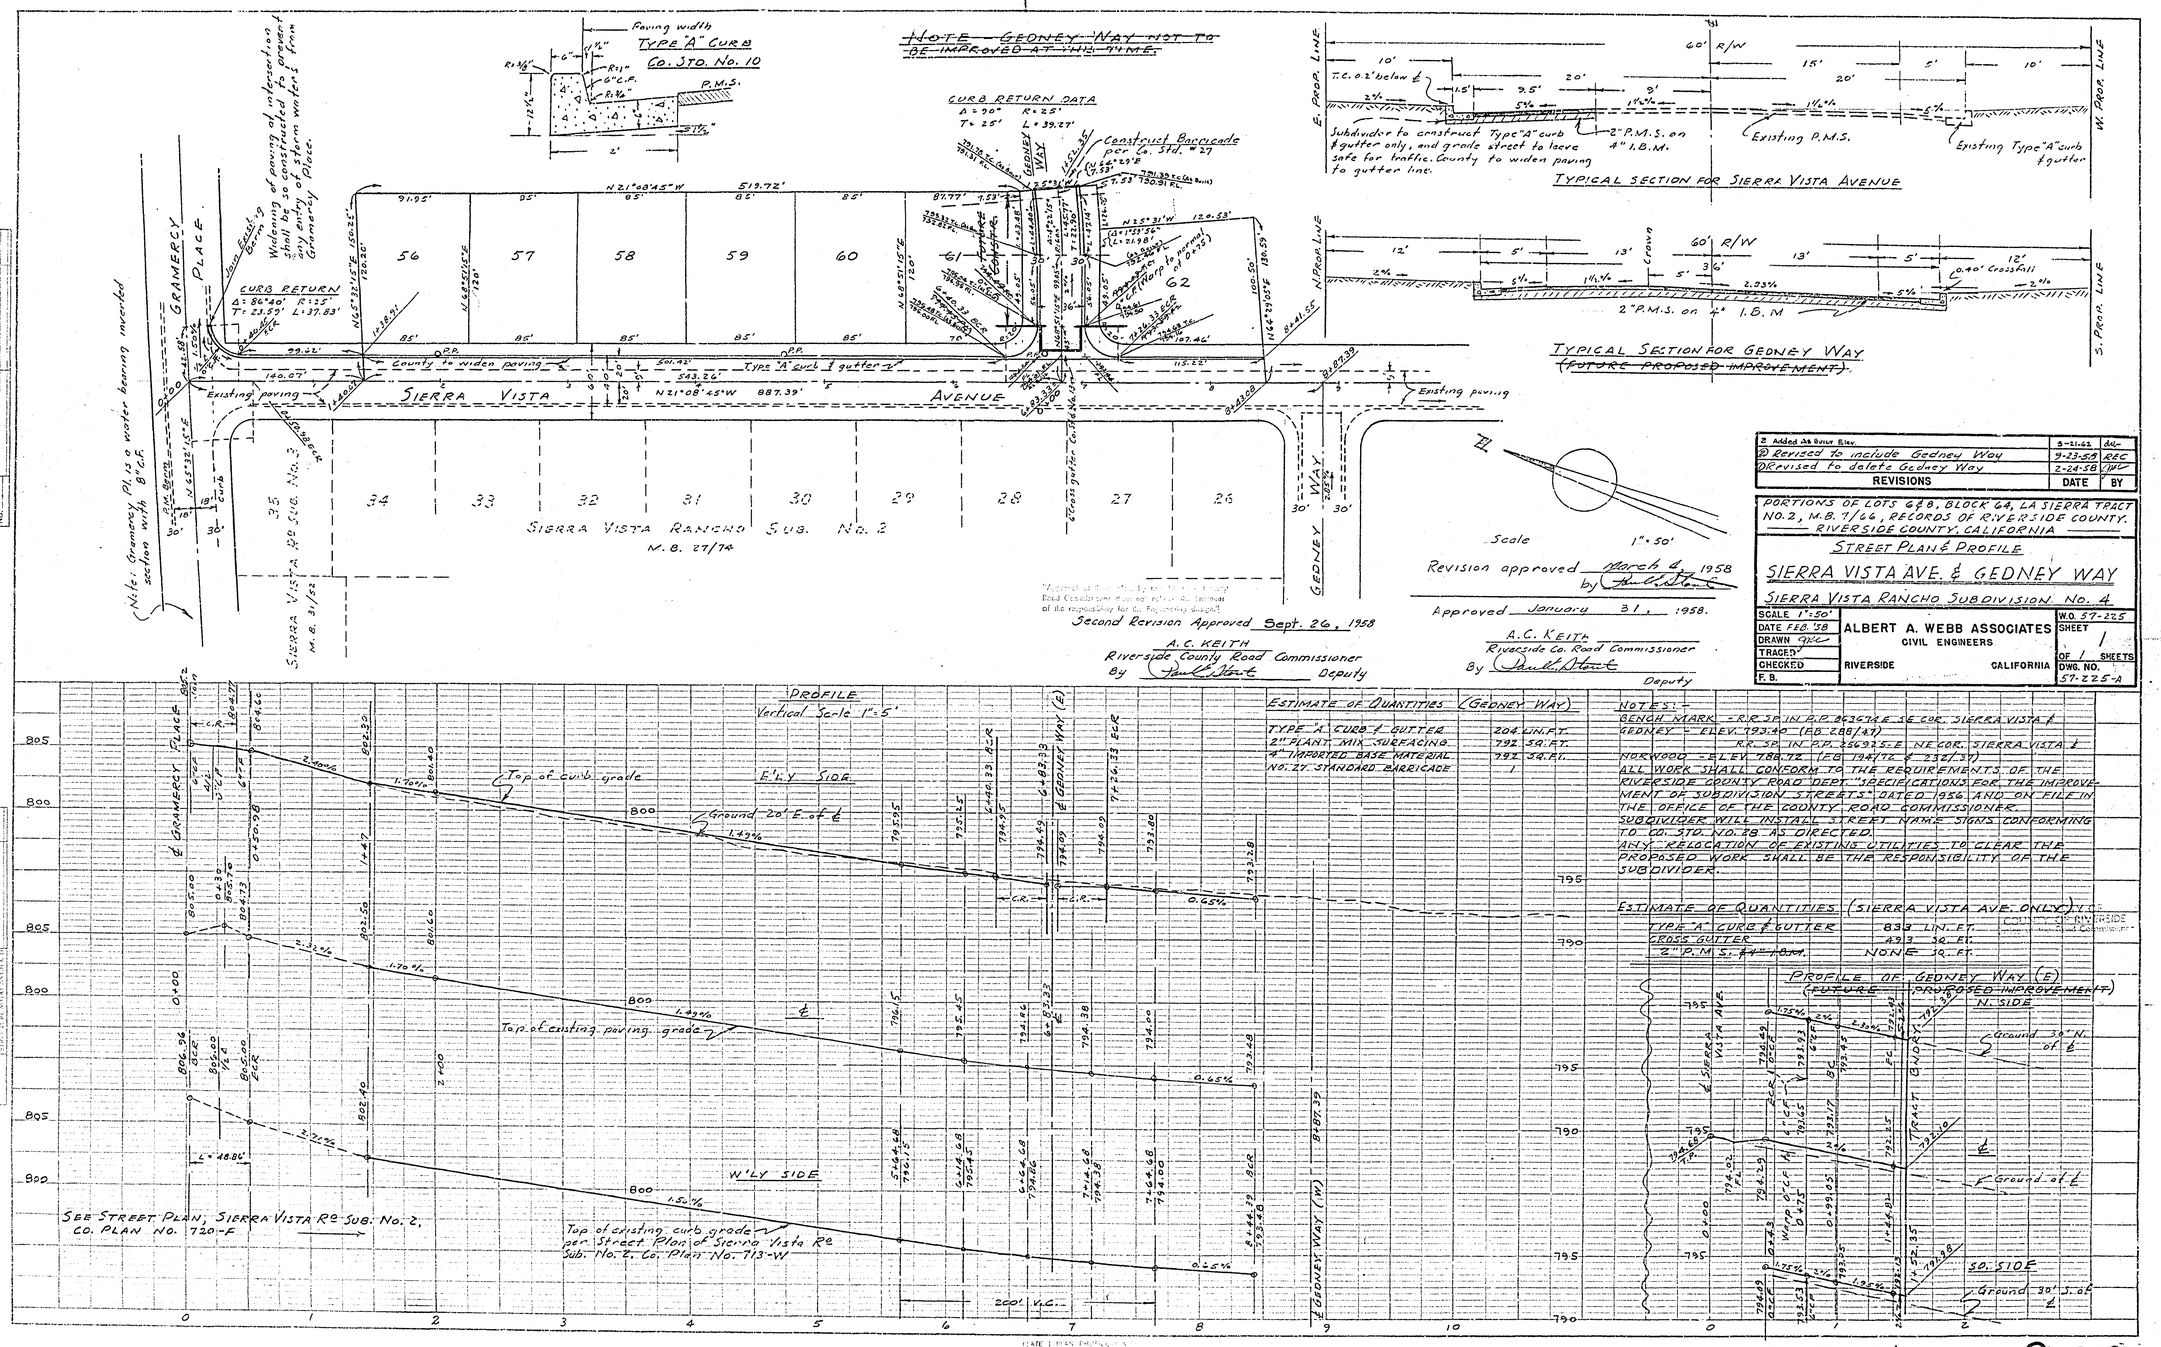


| REVISIONS | DATE | BY |
|---|---|---|
| 2 Added As Built Elev. | 5-21-62 | |
| 1 Revised to include Gedney Way | 9-23-58 | REC |
| 0 Revised to delete Gedney Way | 2-24-58 | |

PORTIONS OF LOTS 6 & 8, BLOCK 64, LA SIERRA TRACT NO. 2, M.B. 7/66, RECORDS OF RIVERSIDE COUNTY. RIVERSIDE COUNTY, CALIFORNIA

STREET PLAN & PROFILE

SIERRA VISTA AVE. & GEDNEY WAY

SIERRA VISTA RANCHO SUBDIVISION No. 4

| | | |
|---|---|---|
| SCALE 1" = 50' | ALBERT A. WEBB ASSOCIATES CIVIL ENGINEERS | W.O. 57-225 |
| DATE FEB. '58 | | SHEET 1 |
| DRAWN | | OF 1 SHEETS |
| TRACED | RIVERSIDE CALIFORNIA | DWG. NO. 57-225-A |
| CHECKED | | |
| F.B. | | |

ESTIMATE OF QUANTITIES (GEDNEY WAY)

| | |
|---|---|
| TYPE "A" CURB & GUTTER | 204 LIN. FT. |
| 2" PLANT MIX SURFACING | 792 SQ. FT. |
| 4" IMPORTED BASE MATERIAL | 792 SQ. FT. |
| NO. 27 STANDARD BARRICADE | 1 |

NOTES:-

BENCH MARK - R.R. SP. IN P.P. 863674 E SE COR. SIERRA VISTA & GEDNEY - ELEV. 793.40 (FB 288/47)
R.R. SP. IN P.P. 256925-E NE COR. SIERRA VISTA & NORWOOD - ELEV. 788.72 (FB 194/72 & 232/37)

ALL WORK SHALL CONFORM TO THE REQUIREMENTS OF THE RIVERSIDE COUNTY ROAD DEPT. "SPECIFICATIONS FOR THE IMPROVEMENT OF SUBDIVISION STREETS" DATED 1956 AND ON FILE IN THE OFFICE OF THE COUNTY ROAD COMMISSIONER.

SUBDIVIDER WILL INSTALL STREET NAME SIGNS CONFORMING TO CO. STD. NO. 28 AS DIRECTED.

ANY RELOCATION OF EXISTING UTILITIES TO CLEAR THE PROPOSED WORK SHALL BE THE RESPONSIBILITY OF THE SUBDIVIDER.

ESTIMATE OF QUANTITIES (SIERRA VISTA AVE. ONLY)

| | |
|---|---|
| TYPE "A" CURB & GUTTER | 833 LIN. FT. |
| CROSS GUTTER | 493 SQ. FT. |
| 2" P.M.S. & 4" I.B.M. | NONE SQ. FT. |




D.N. 57-225-A

R-818