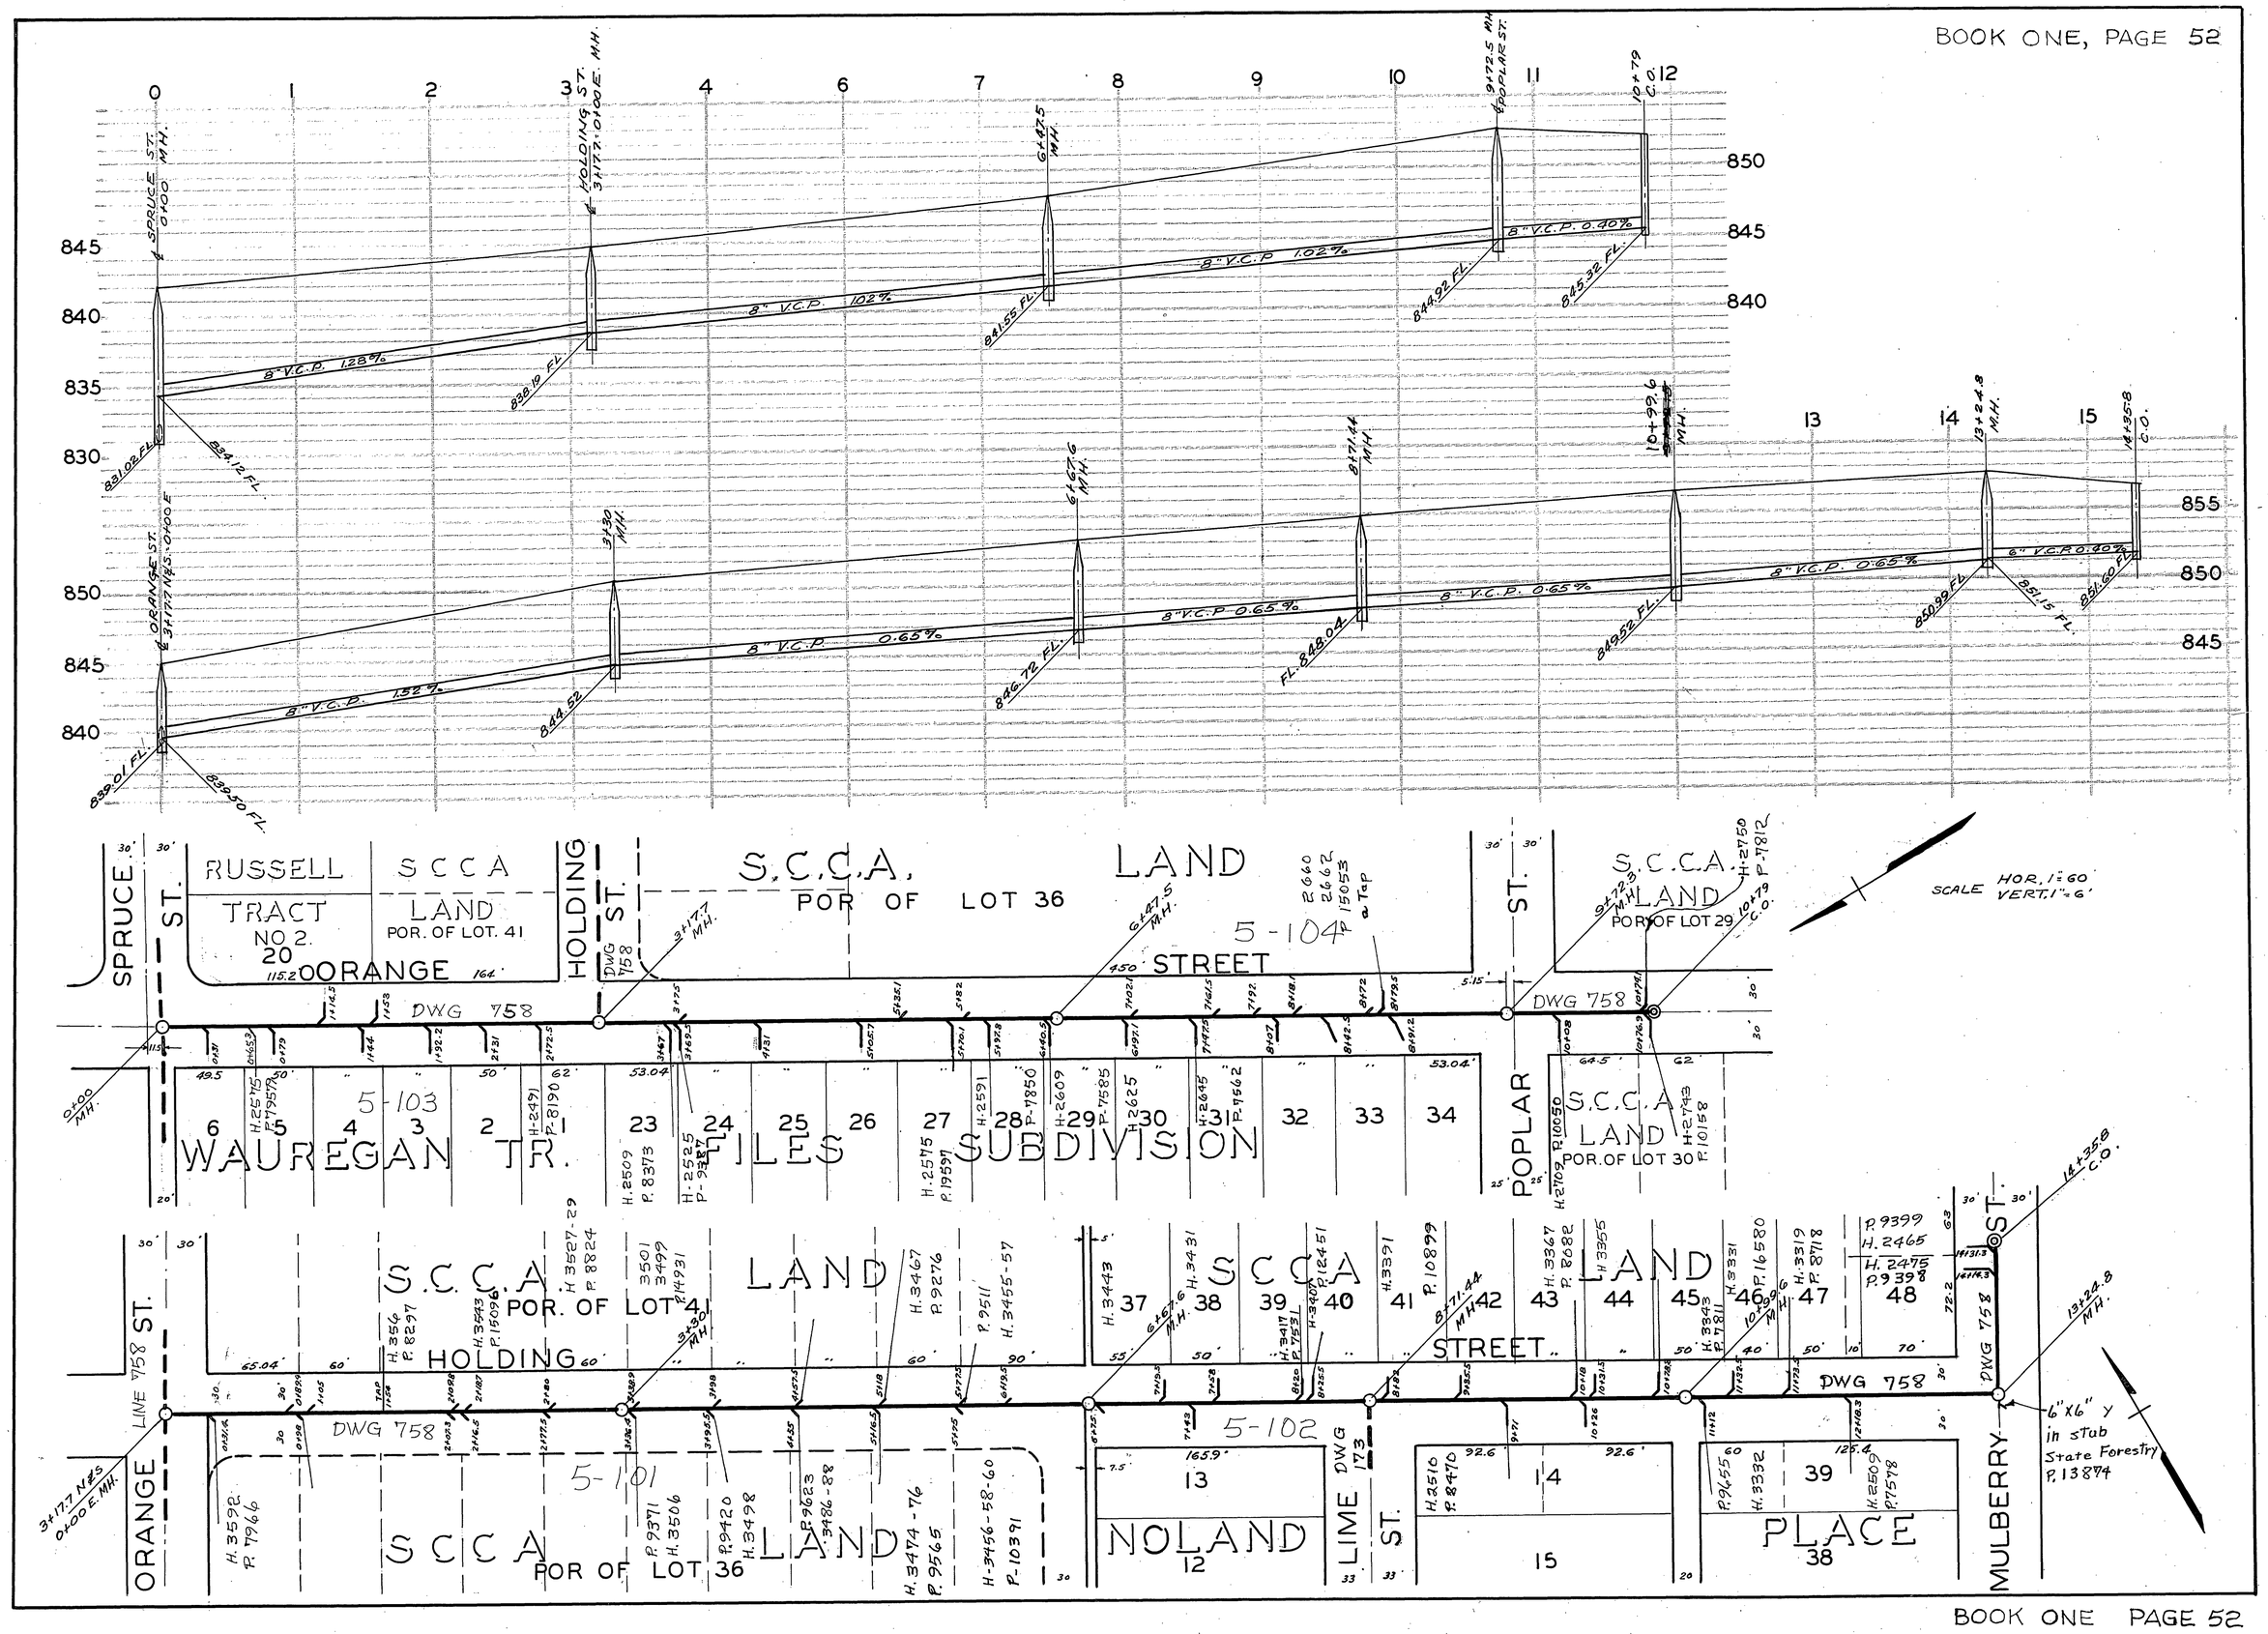
SPRUCE ST. 0+00 M.H.
HOLDING ST. 3+17.7 = 0+00 E. M.H.
6+47.5 M.H.
9+72.5 M.H. POPLAR ST.
10+79 C.O.
8" V.C.P. 1.28%
8" V.C.P. 1.02%
8" V.C.P. 0.40%
831.02 FL.
834.12 FL.
838.19 FL.
841.55 FL.
844.92 FL.
845.32 FL.
ORANGE ST. 3+17.7 N&S = 0+00 E
3+30 M.H.
6+67.6 M.H.
8+71.44 M.H.
10+99.6 M.H.
13+24.8 M.H.
14+35.8 C.O.
8" V.C.P. 1.52%
8" V.C.P. 0.65%
6" V.C.P. 0.40%
839.01 FL.
839.50 FL.
844.52
846.72 FL.
FL. 848.04
849.52 FL.
850.99 FL.
851.15 FL.
851.60 FL.
RUSSELL TRACT NO. 2
S C C A LAND POR. OF LOT. 41
S.C.C.A. LAND POR OF LOT 36
S.C.C.A. LAND POR OF LOT 29
S.C.C.A. LAND POR. OF LOT 30
SCALE HOR. 1" = 60' VERT. 1" = 6'
SPRUCE ST.
HOLDING ST.
ORANGE STREET
POPLAR ST.
DWG 758
5-104
5-103
WAUREGAN TR. FILES SUBDIVISION
S.C.C.A. LAND POR. OF LOT 41
S C C A LAND POR OF LOT 36
S C C A LAND
NOLAND PLACE
LIME ST.
MULBERRY ST.
5-101
5-102
6"X6" Y in stub State Forestry P. 13874