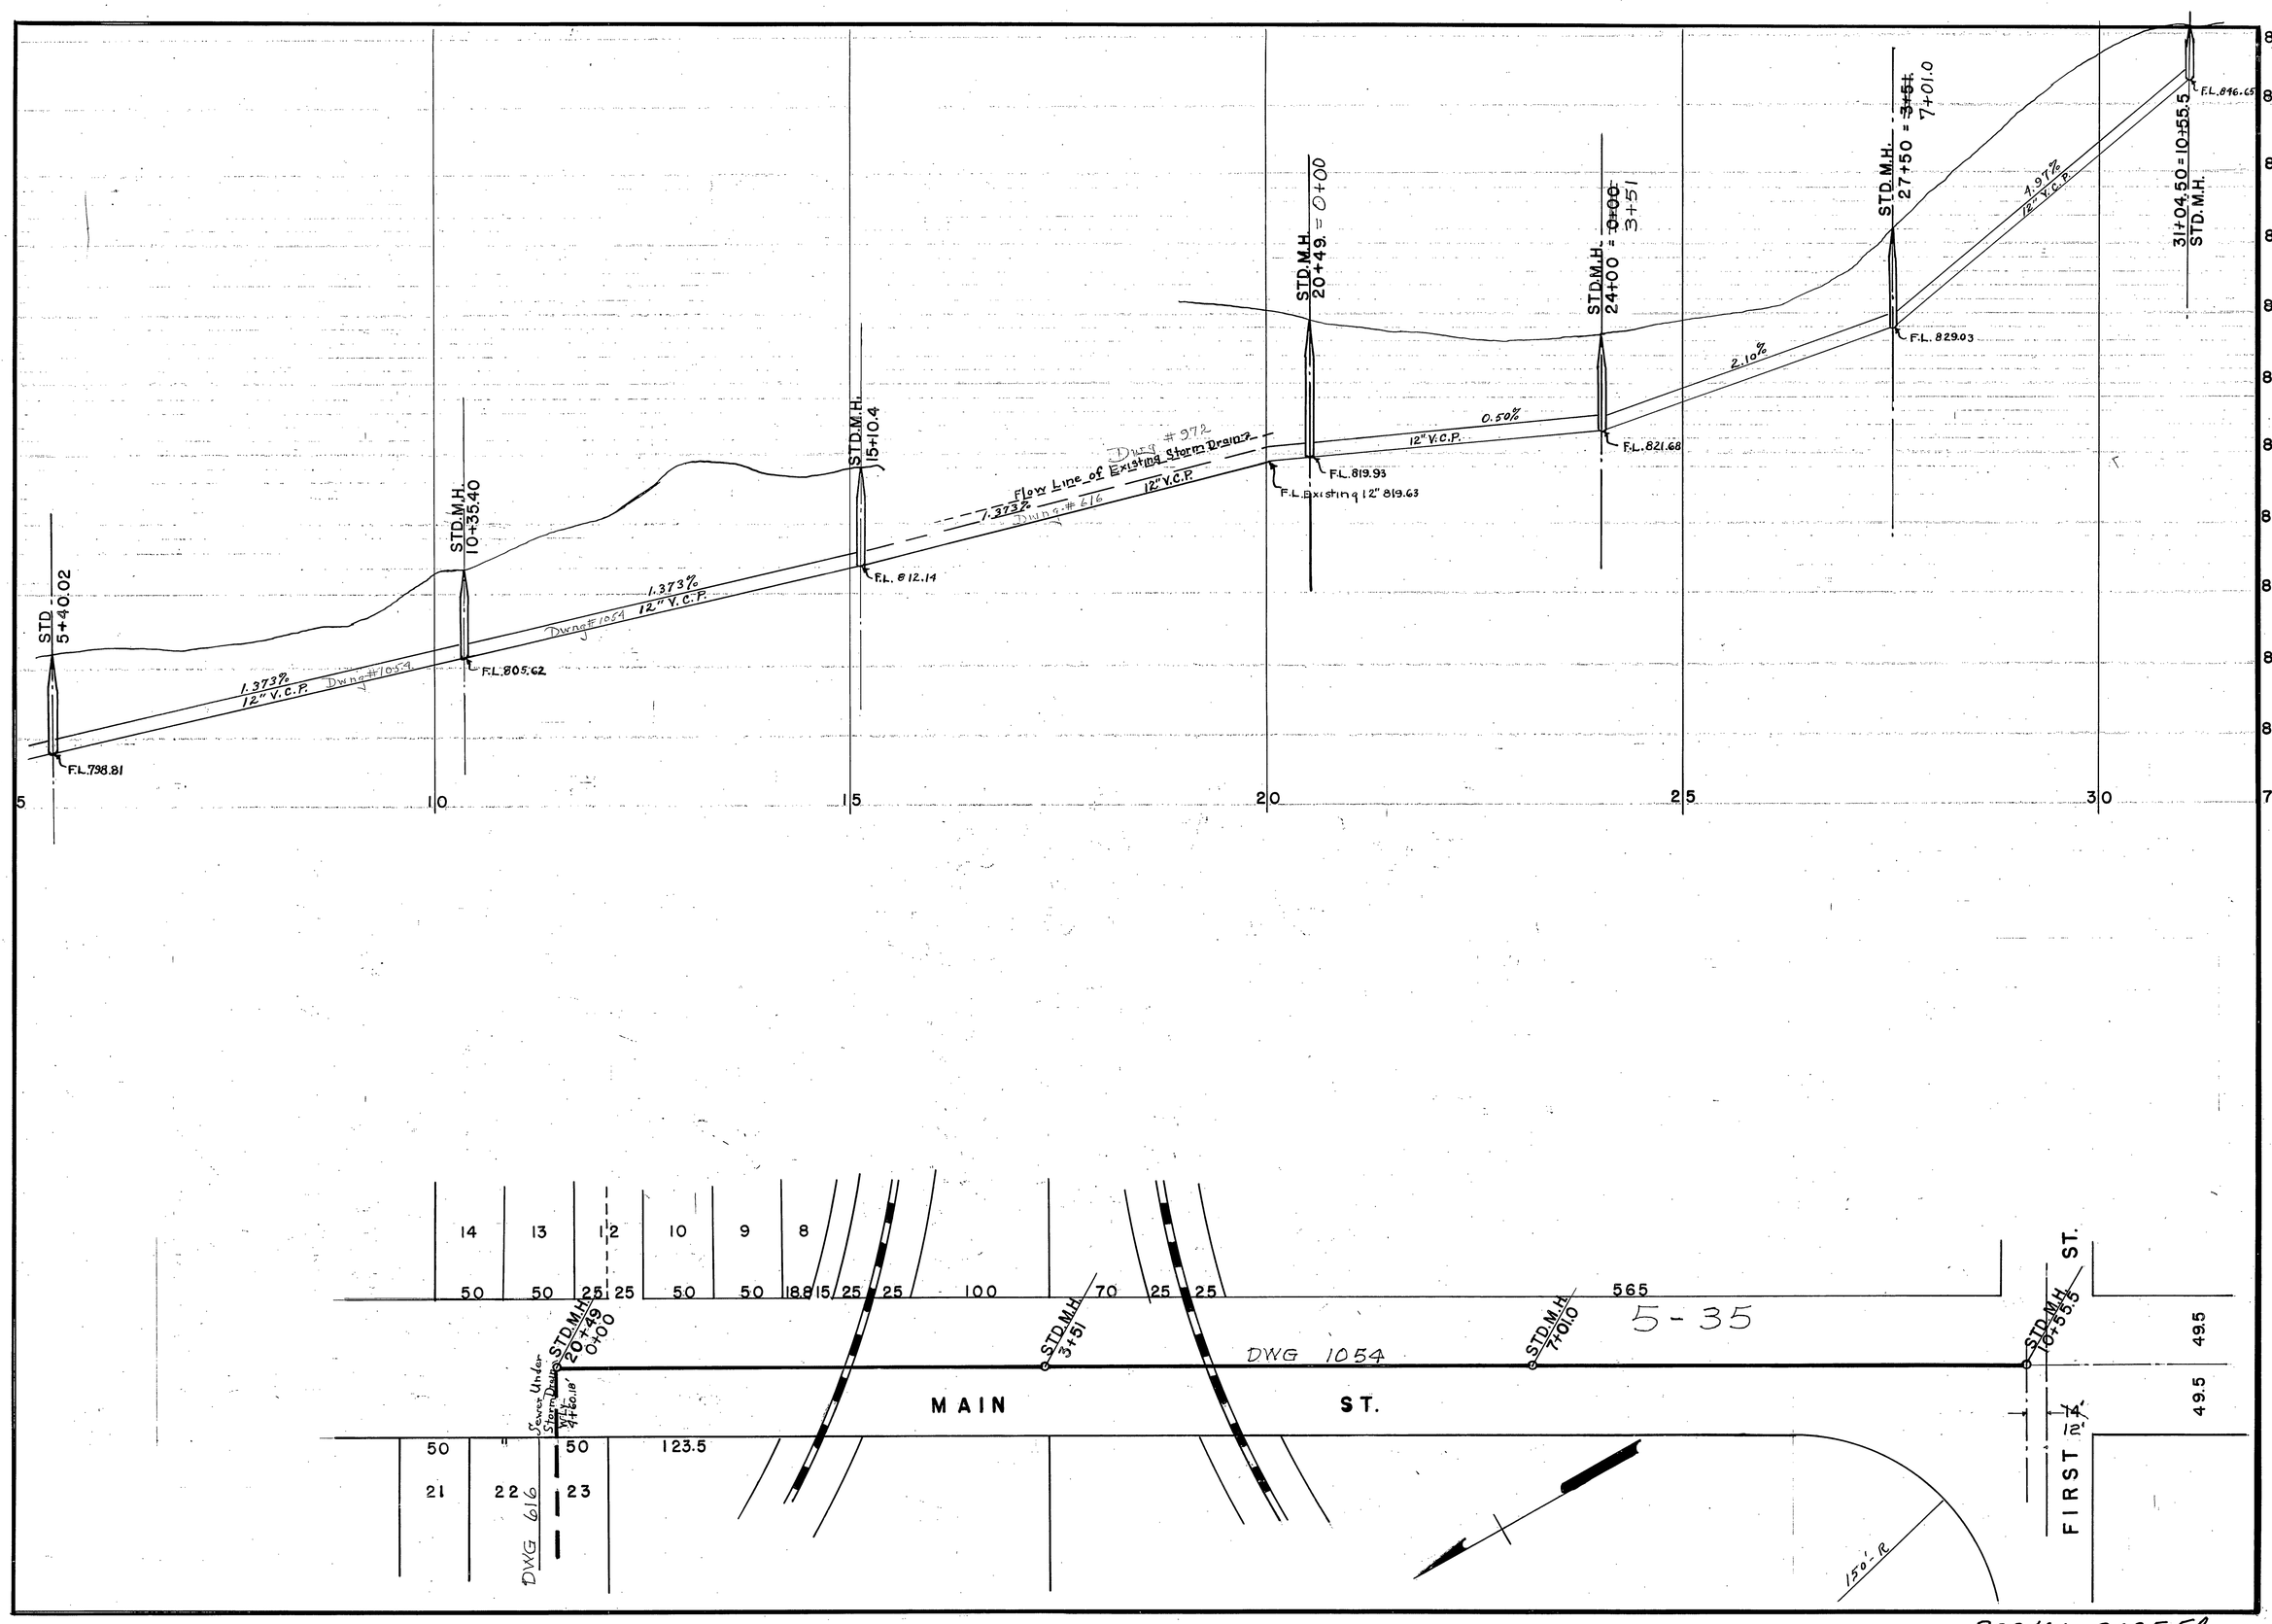

BOOK 1 - PAGE 54