


FAIRMOUNT BLVD.

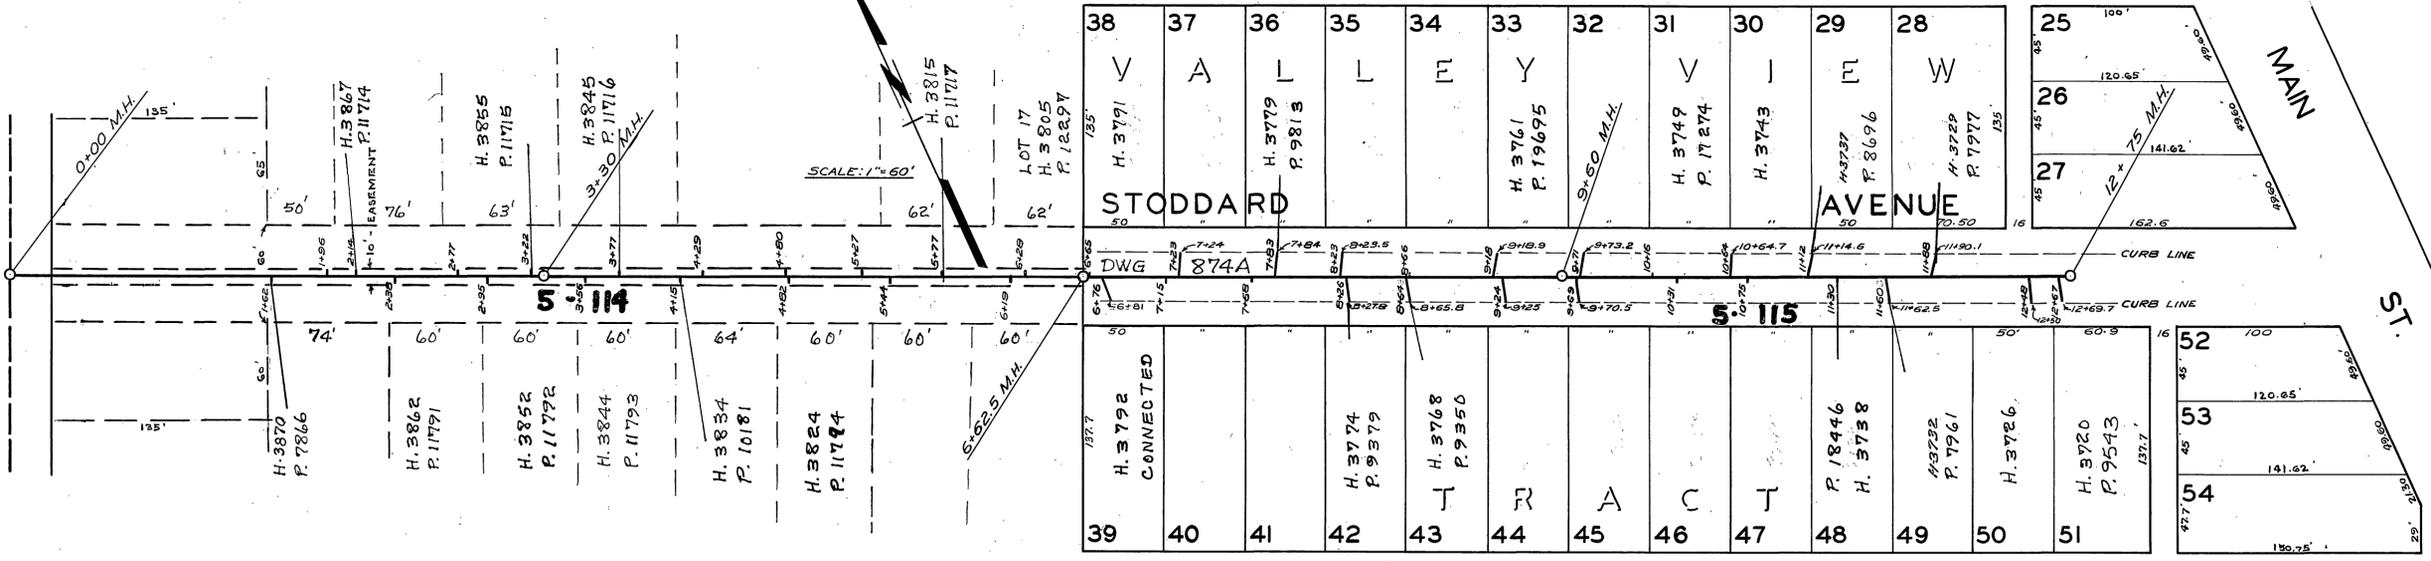

38	37	36	35	34	33	32	31	30	29	28	25	26	27		
V	A	L	L	L	Y	V	J	E	W						
H. 3791 P. 9813	H. 3779 P. 9813	H. 3761 P. 19695				H. 3749 P. 17274	H. 3743	H. 3737 P. 8696	H. 3729 P. 7977						
39	40	41	42	43	44	45	46	47	48	49	50	51	52	53	54
H. 3792 CONNECTED			H. 3774 P. 9379	H. 3768 P. 9350					P. 18446 H. 3758	H. 3722 P. 7961	H. 3726	H. 3720 P. 9543			