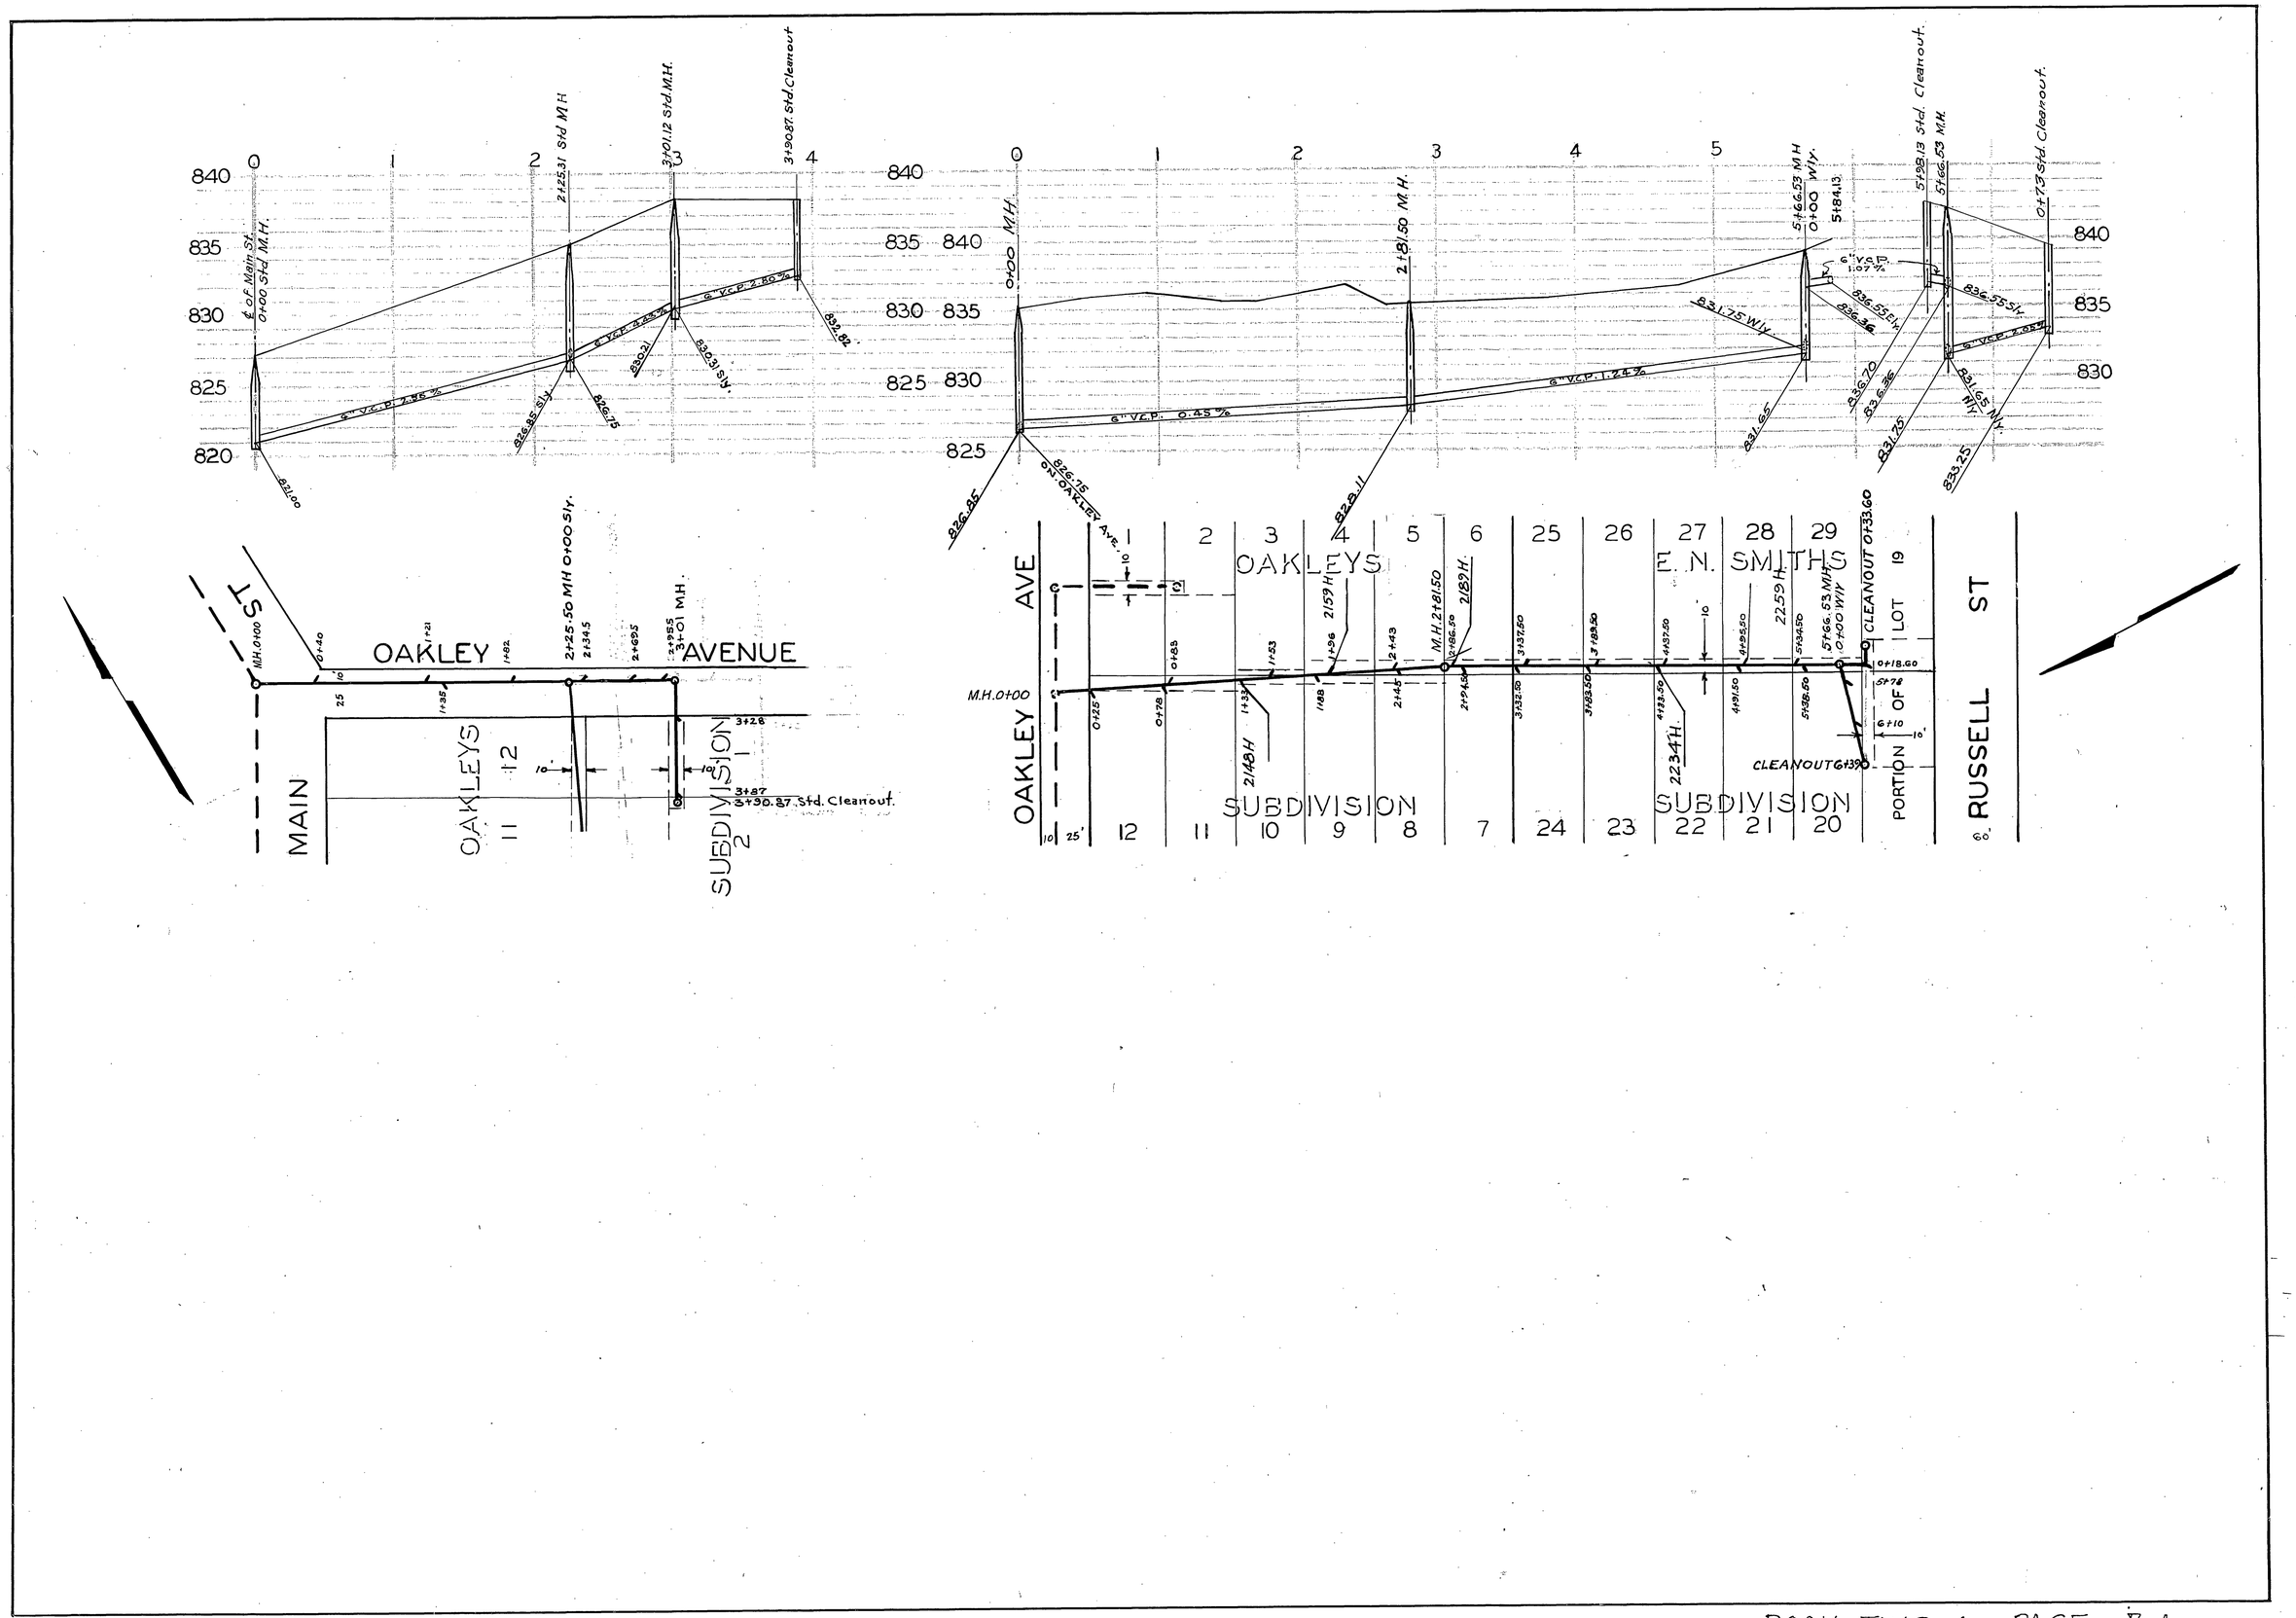

OAKLEY AVENUE
MAIN ST
OAKLEYS SUBDIVISION
E. N. SMITHS SUBDIVISION
OAKLEY AVE
RUSSELL ST
PORTION OF LOT 19
CLEANOUT 0+33.60
CLEANOUT 6+39.0
M.H. 0+00

BK 2