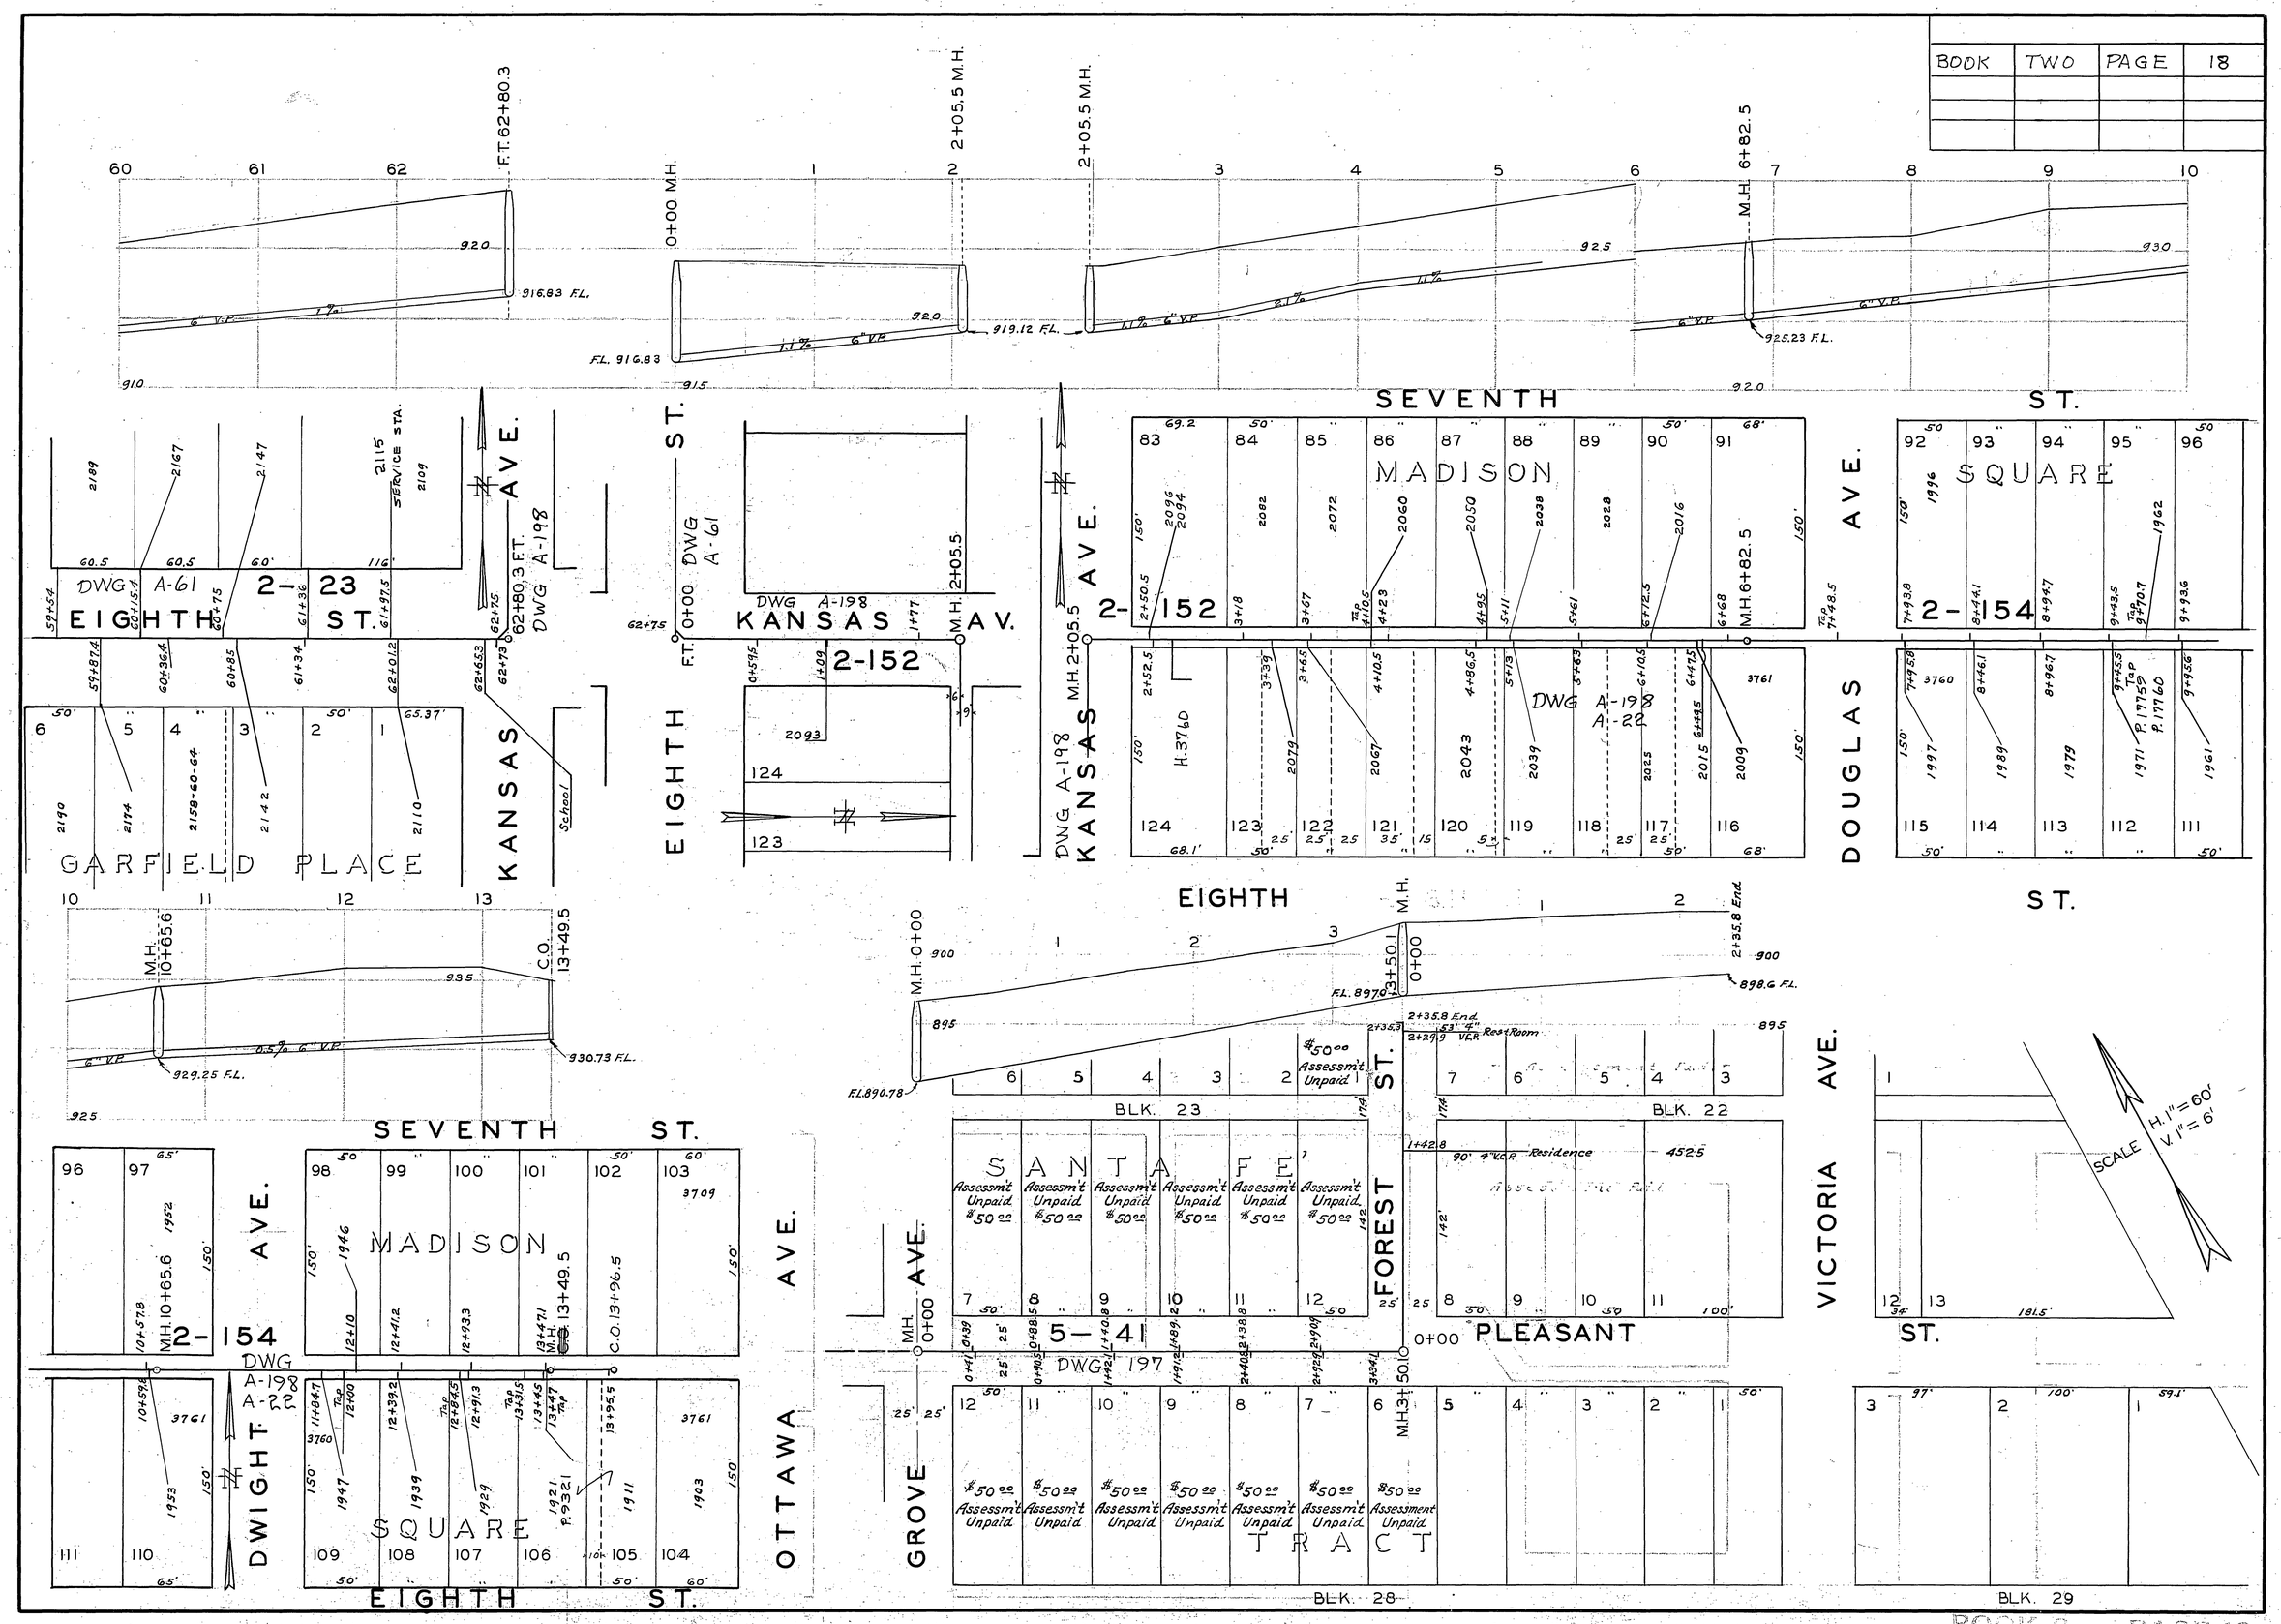BOOK	TWO	PAGE	18