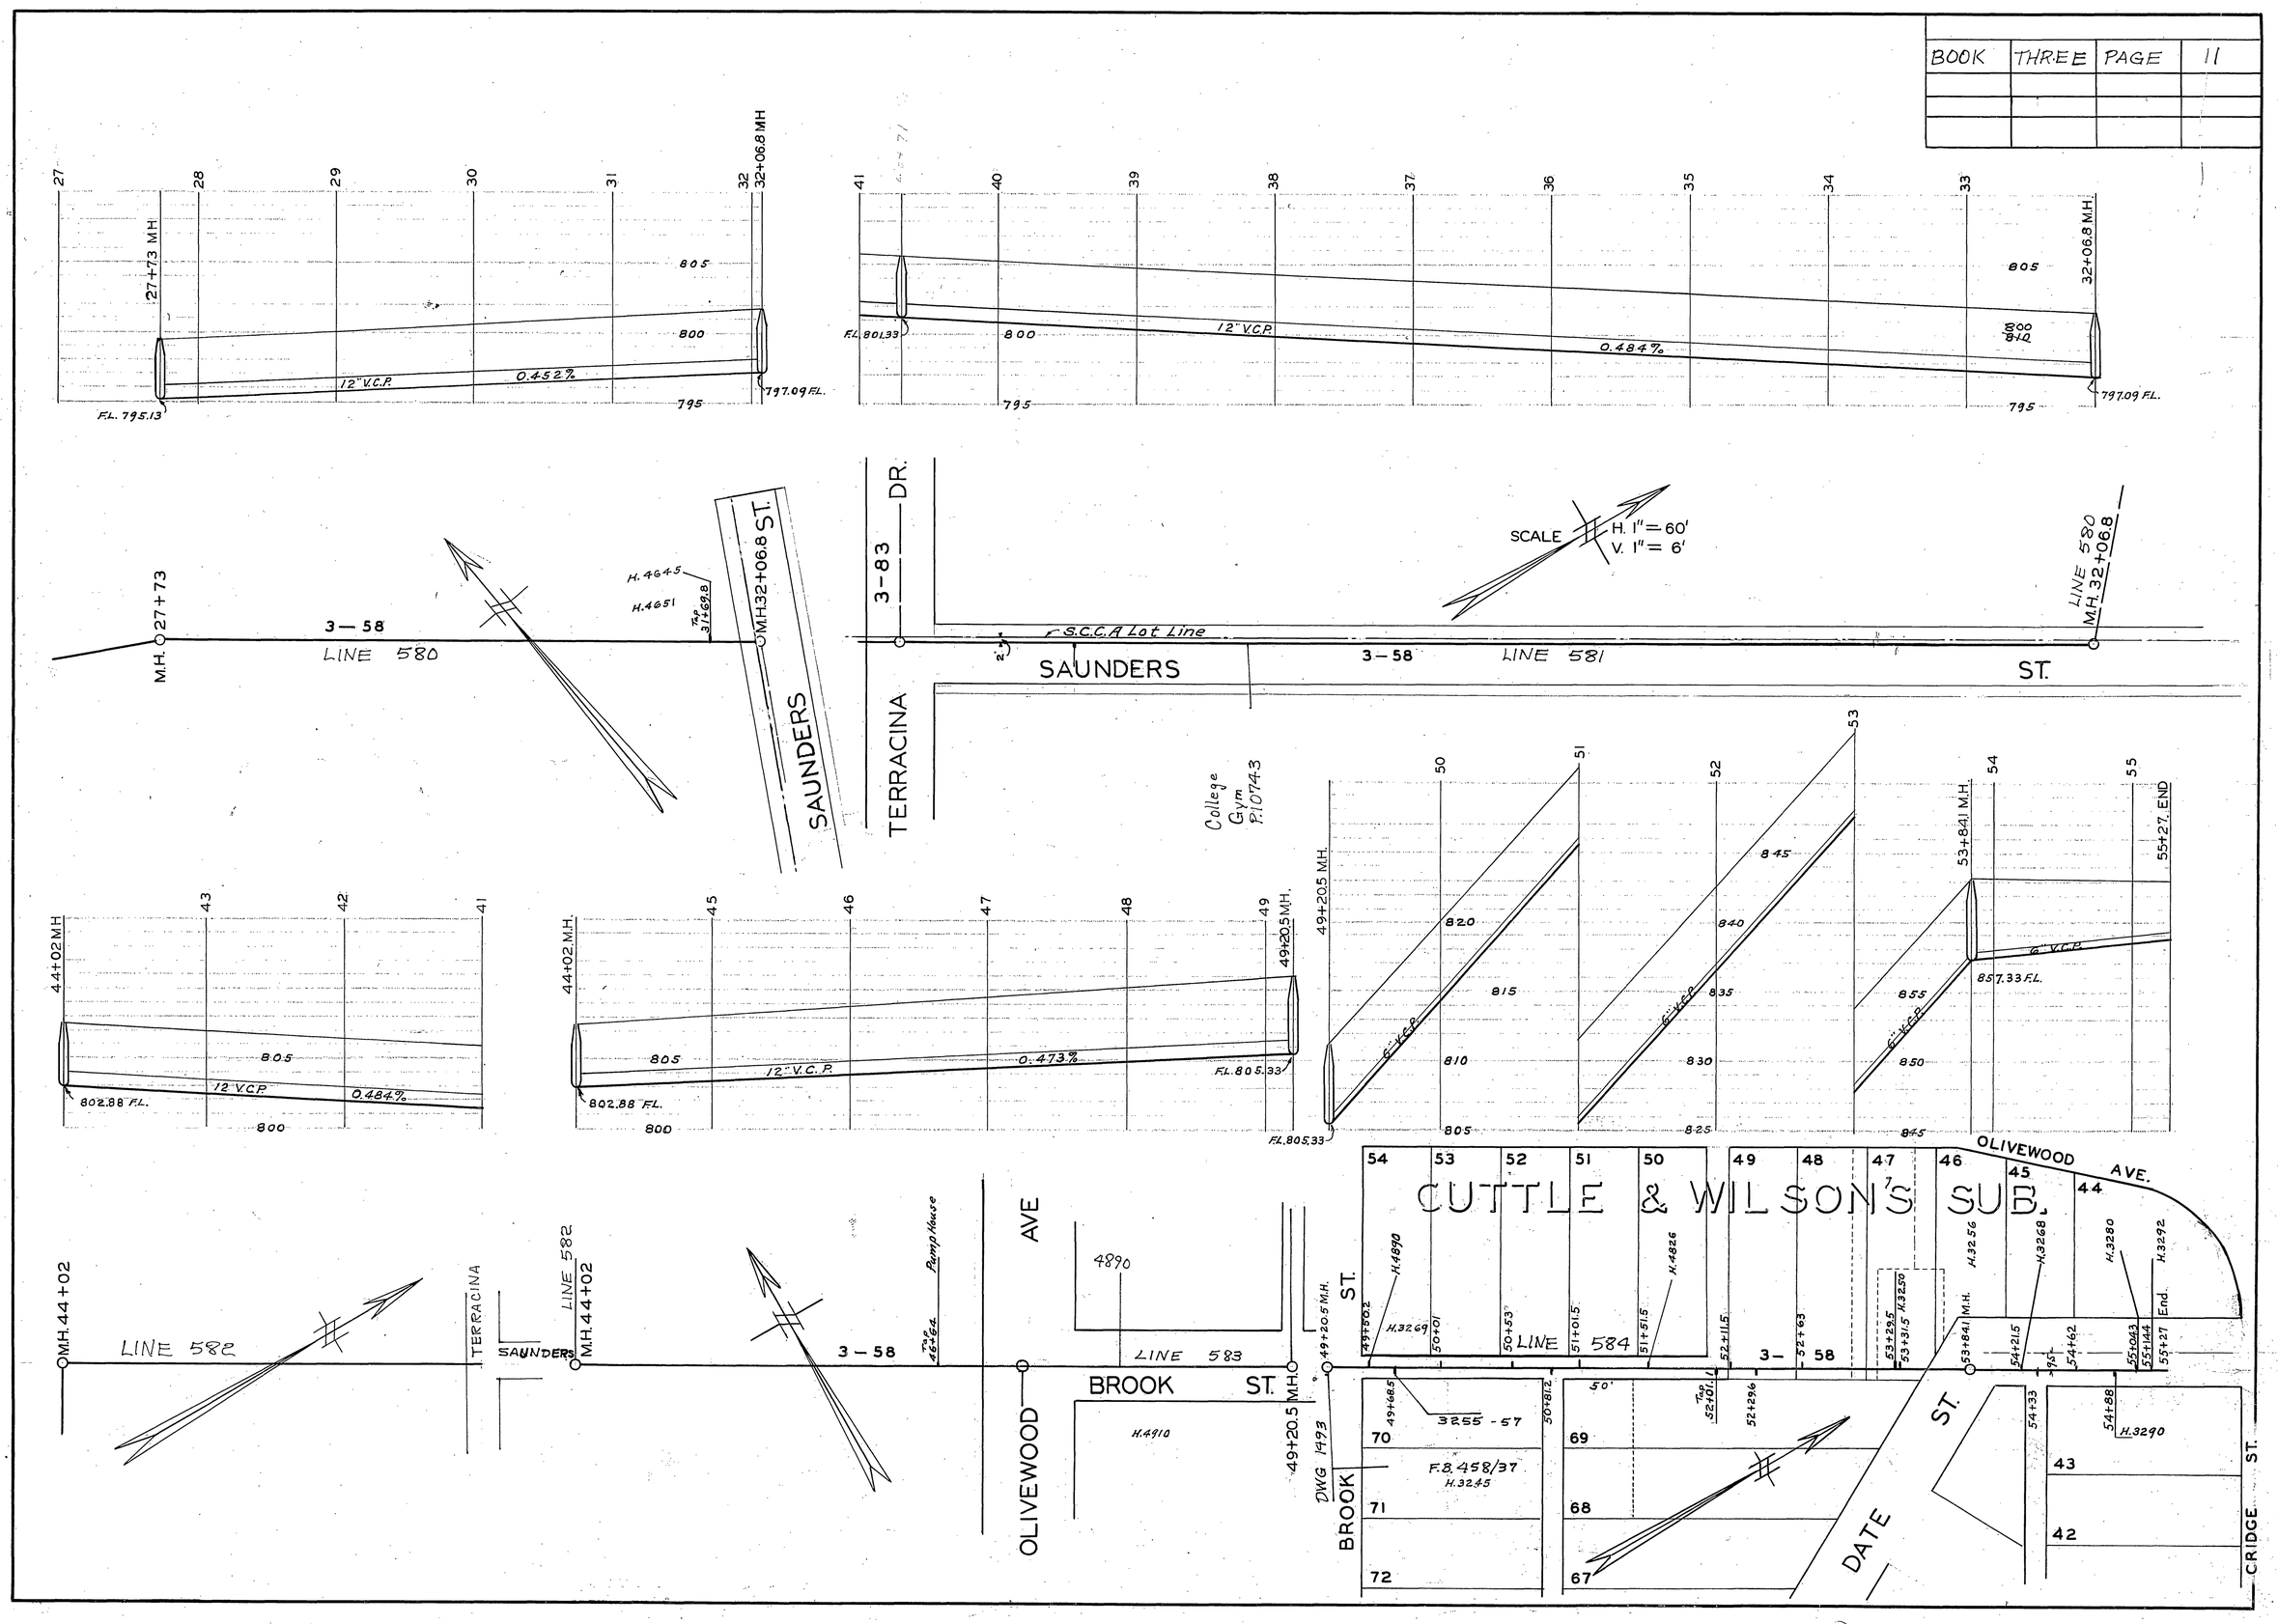BOOK	THREE	PAGE	11