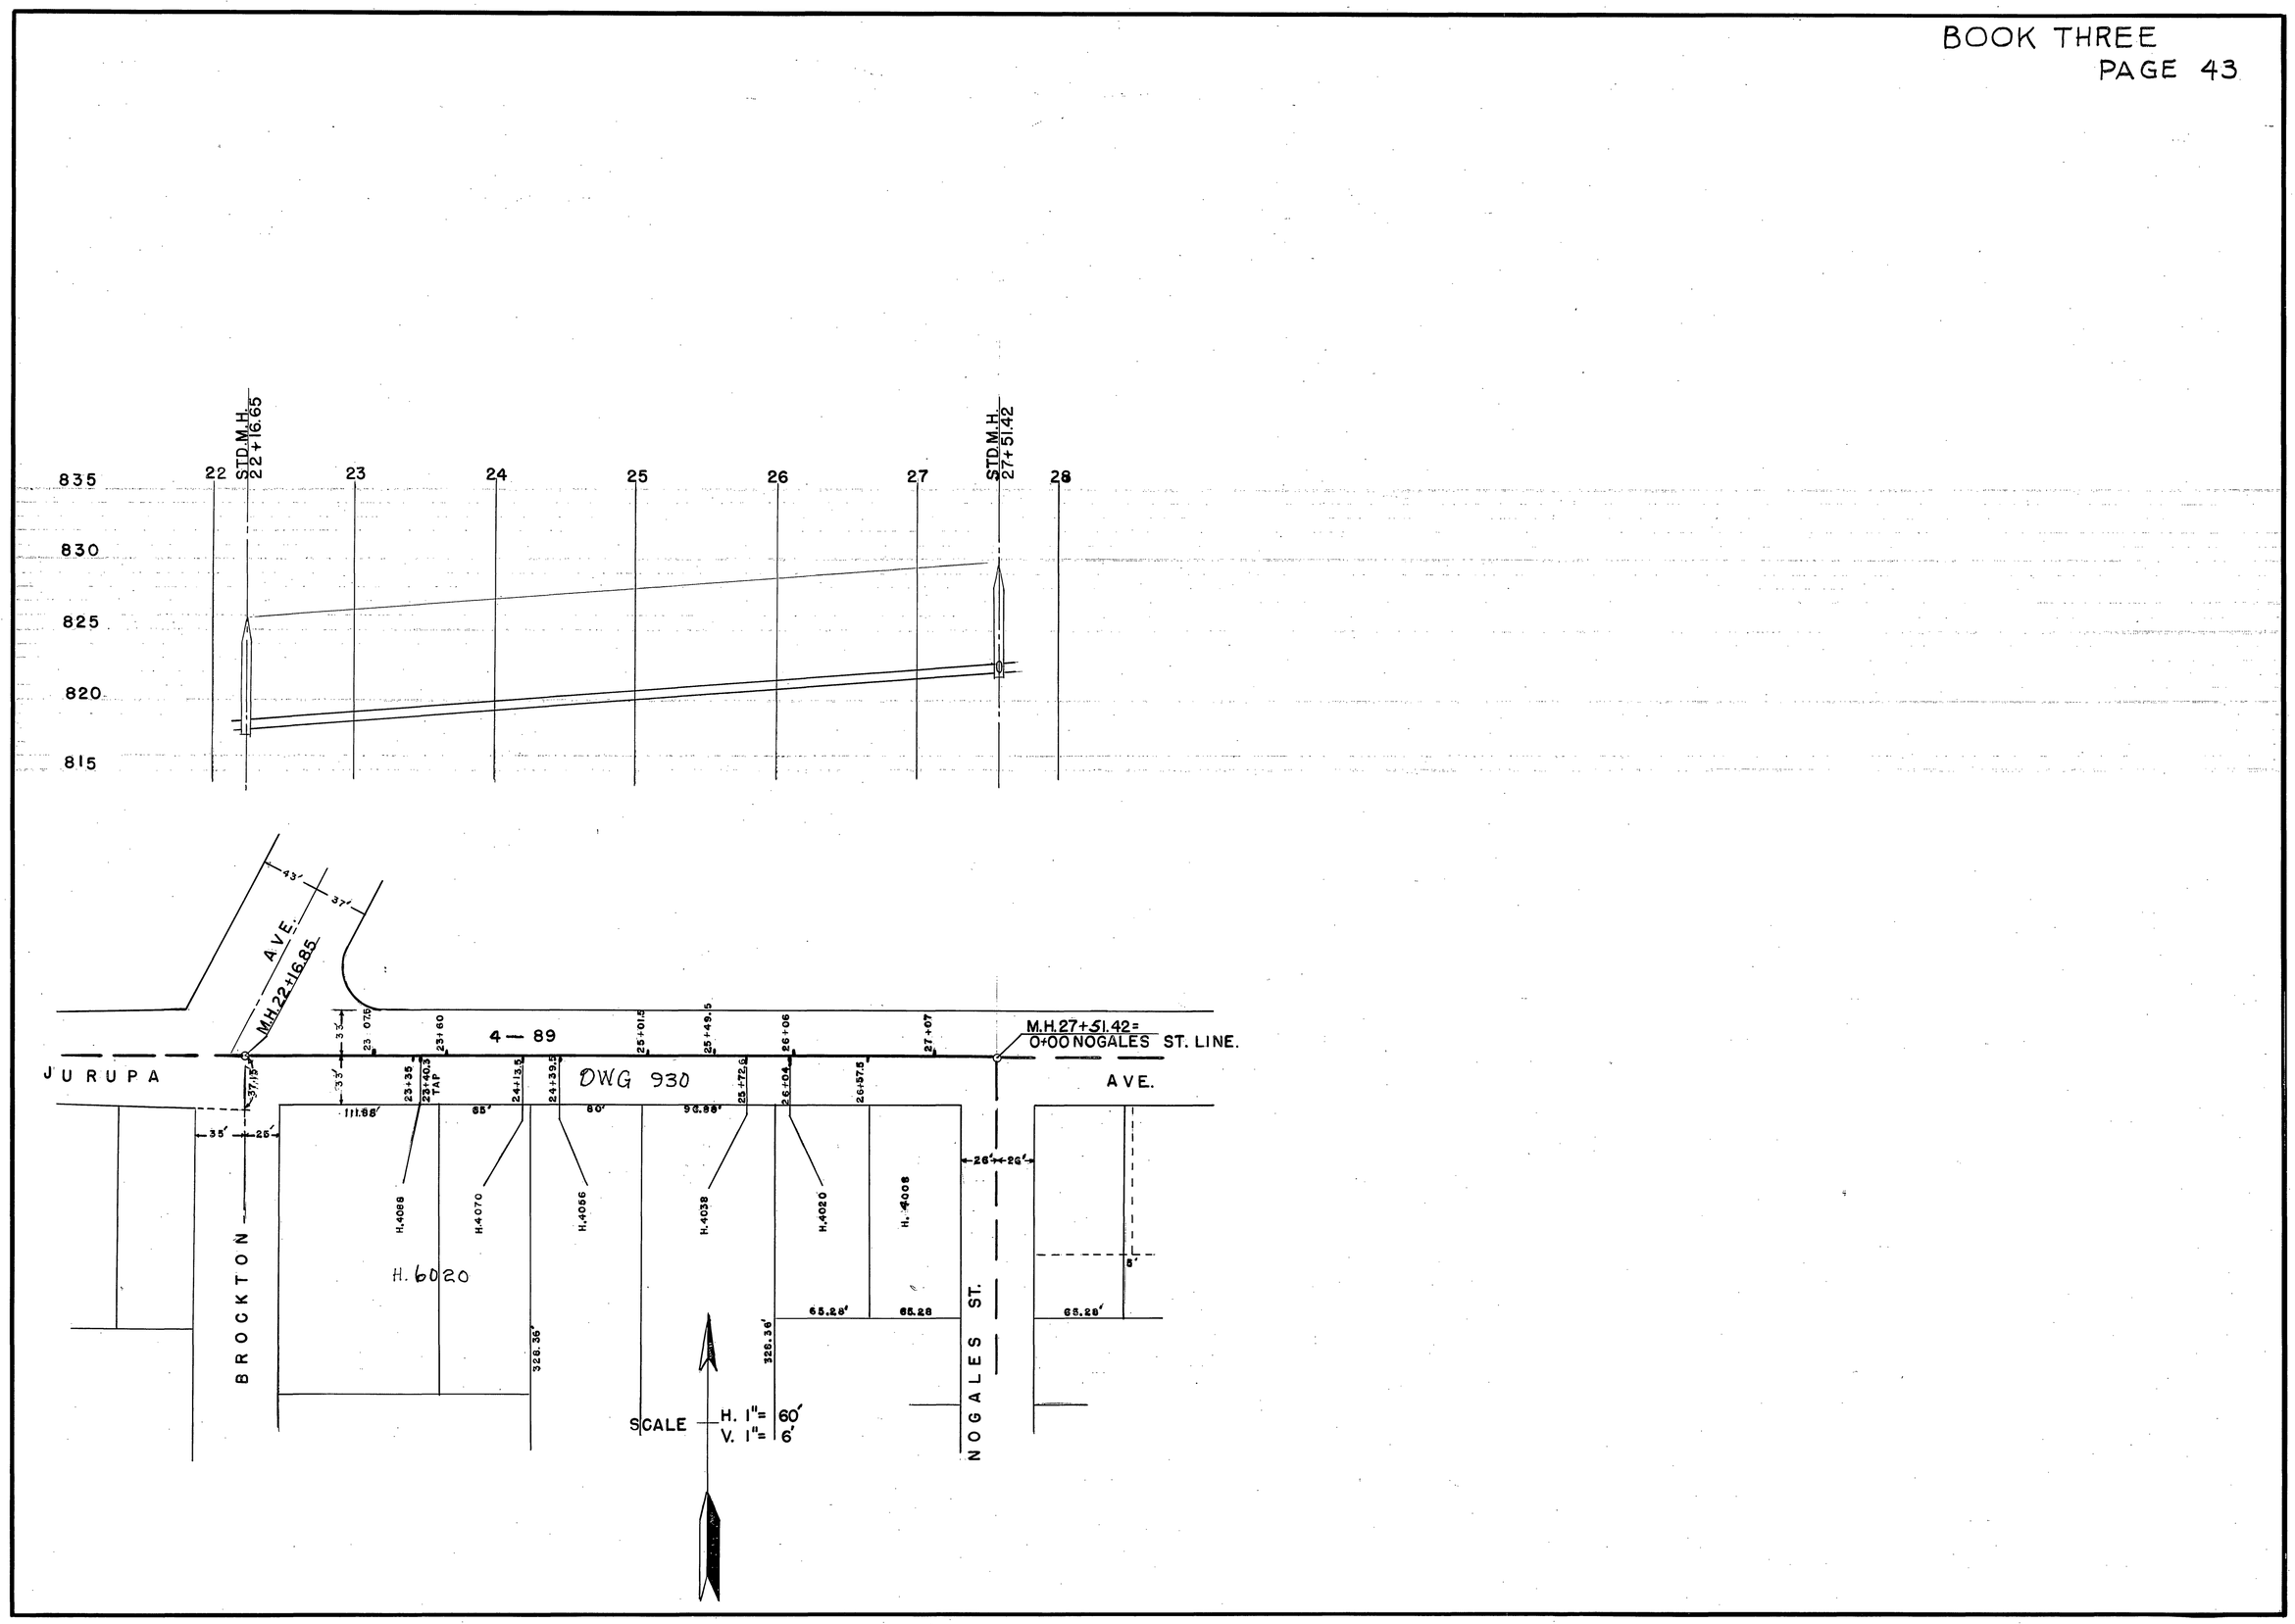
835
830
825
820
815
22
STD.M.H.
22+16.65
23
24
25
26
27
STD.M.H.
27+51.42
28
43'
37'
AVE.
M.H.22+16.85
3.5'
23 07.5
23+60
4 — 89
25+01.5
25+49.5
26+06
27+07
M.H.27+51.42=
0+00 NOGALES ST. LINE.
JURUPA
AVE.
37.15'
3.5'
23+35
23+40.3
TAP
24+13.5
24+39.5
DWG 930
25+72.6
26+04
26+37.5
111.88'
65'
60'
96.88'
35'
25'
26'
26'
H.4088
H.4070
H.4056
H.4038
H.4020
H.4008
H.6020
BROCKTON
326.36'
326.36'
65.28'
65.28
65.28'
6'
NOGALES ST.
SCALE
H. 1" = 60'
V. 1" = 6'