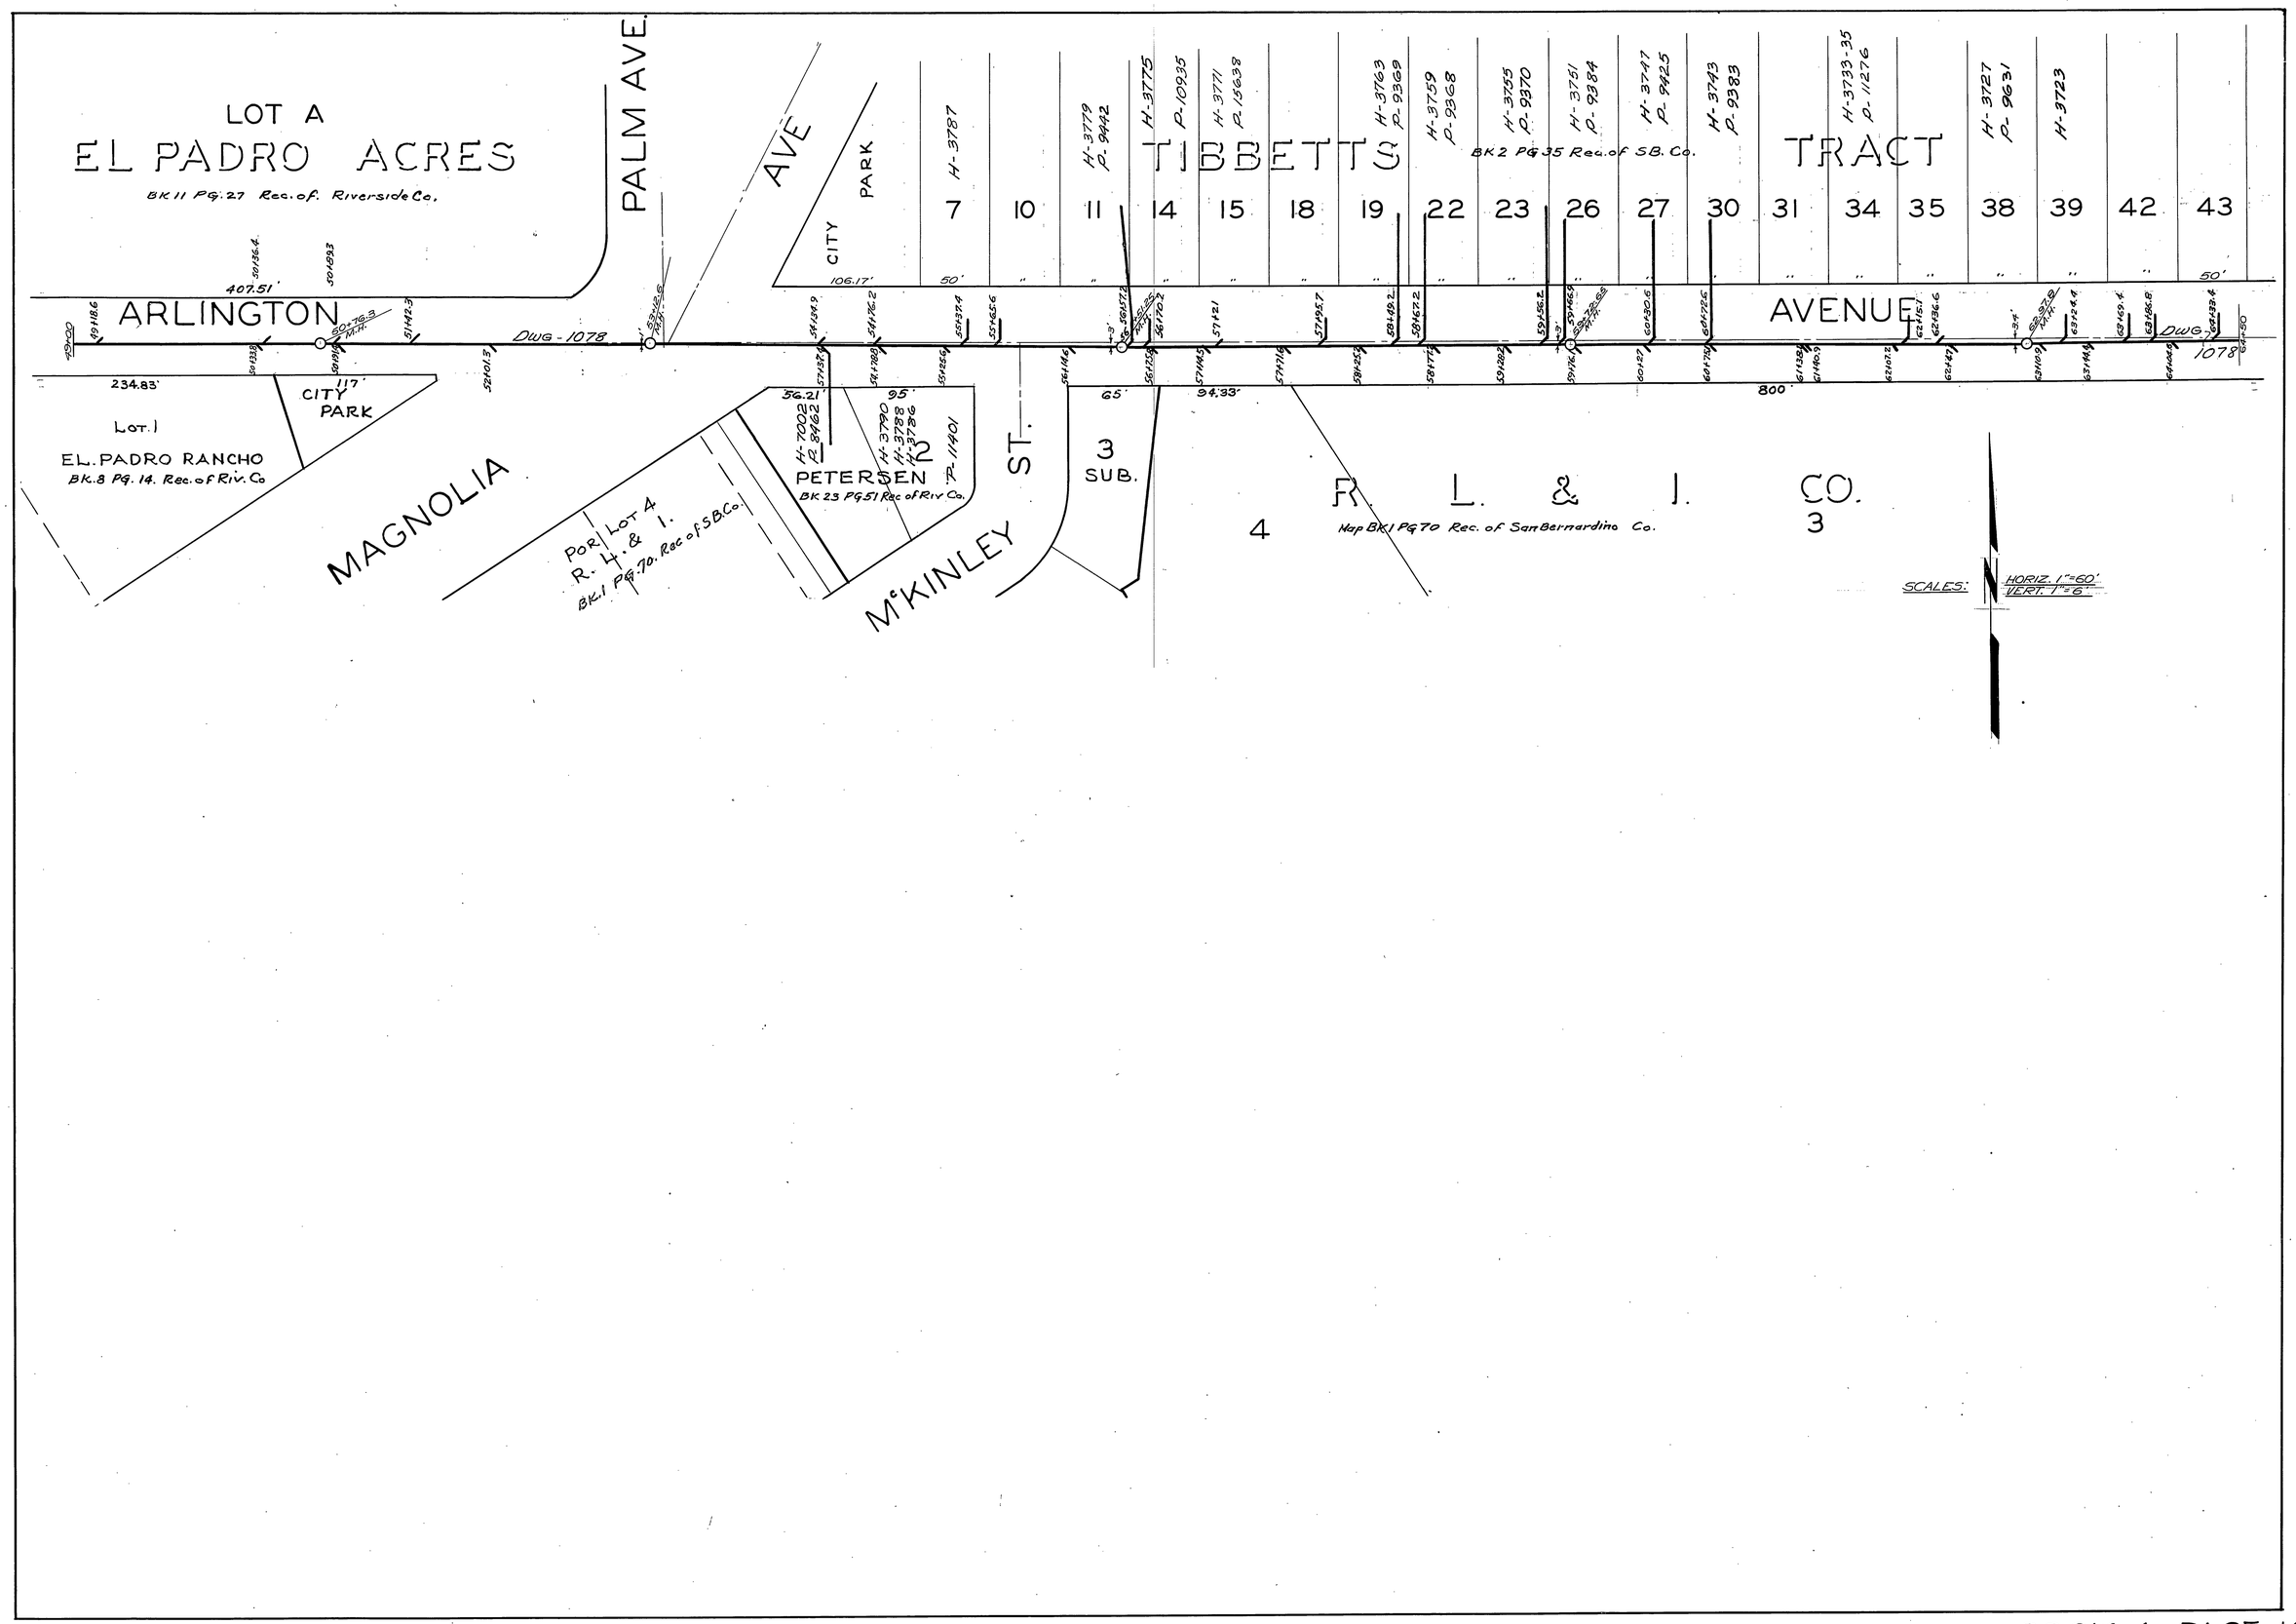
LOT A
EL PADRO ACRES
BK 11 PG. 27 Rec. of Riverside Co.
PALM AVE.
AVE
CITY PARK
TIBBETTS TRACT
BK 2 PG 35 Rec. of SB. Co.
7
10
11
14
15
18
19
22
23
26
27
30
31
34
35
38
39
42
43
ARLINGTON
AVENUE
DWG - 1078
CITY PARK
LOT 1
EL. PADRO RANCHO
BK. 8 PG. 14. Rec. of Riv. Co
MAGNOLIA
POR. LOT 4
R. L. & I.
BK. 1 PG. 70. Rec. of S.B. Co.
PETERSEN
BK 23 PG 51 Rec. of Riv. Co.
McKINLEY ST.
3
SUB.
R. L. & I. CO.
Map BK 1 PG 70 Rec. of San Bernardino Co.
4
3
SCALES:
HORIZ. 1"=60'
VERT. 1"=6'