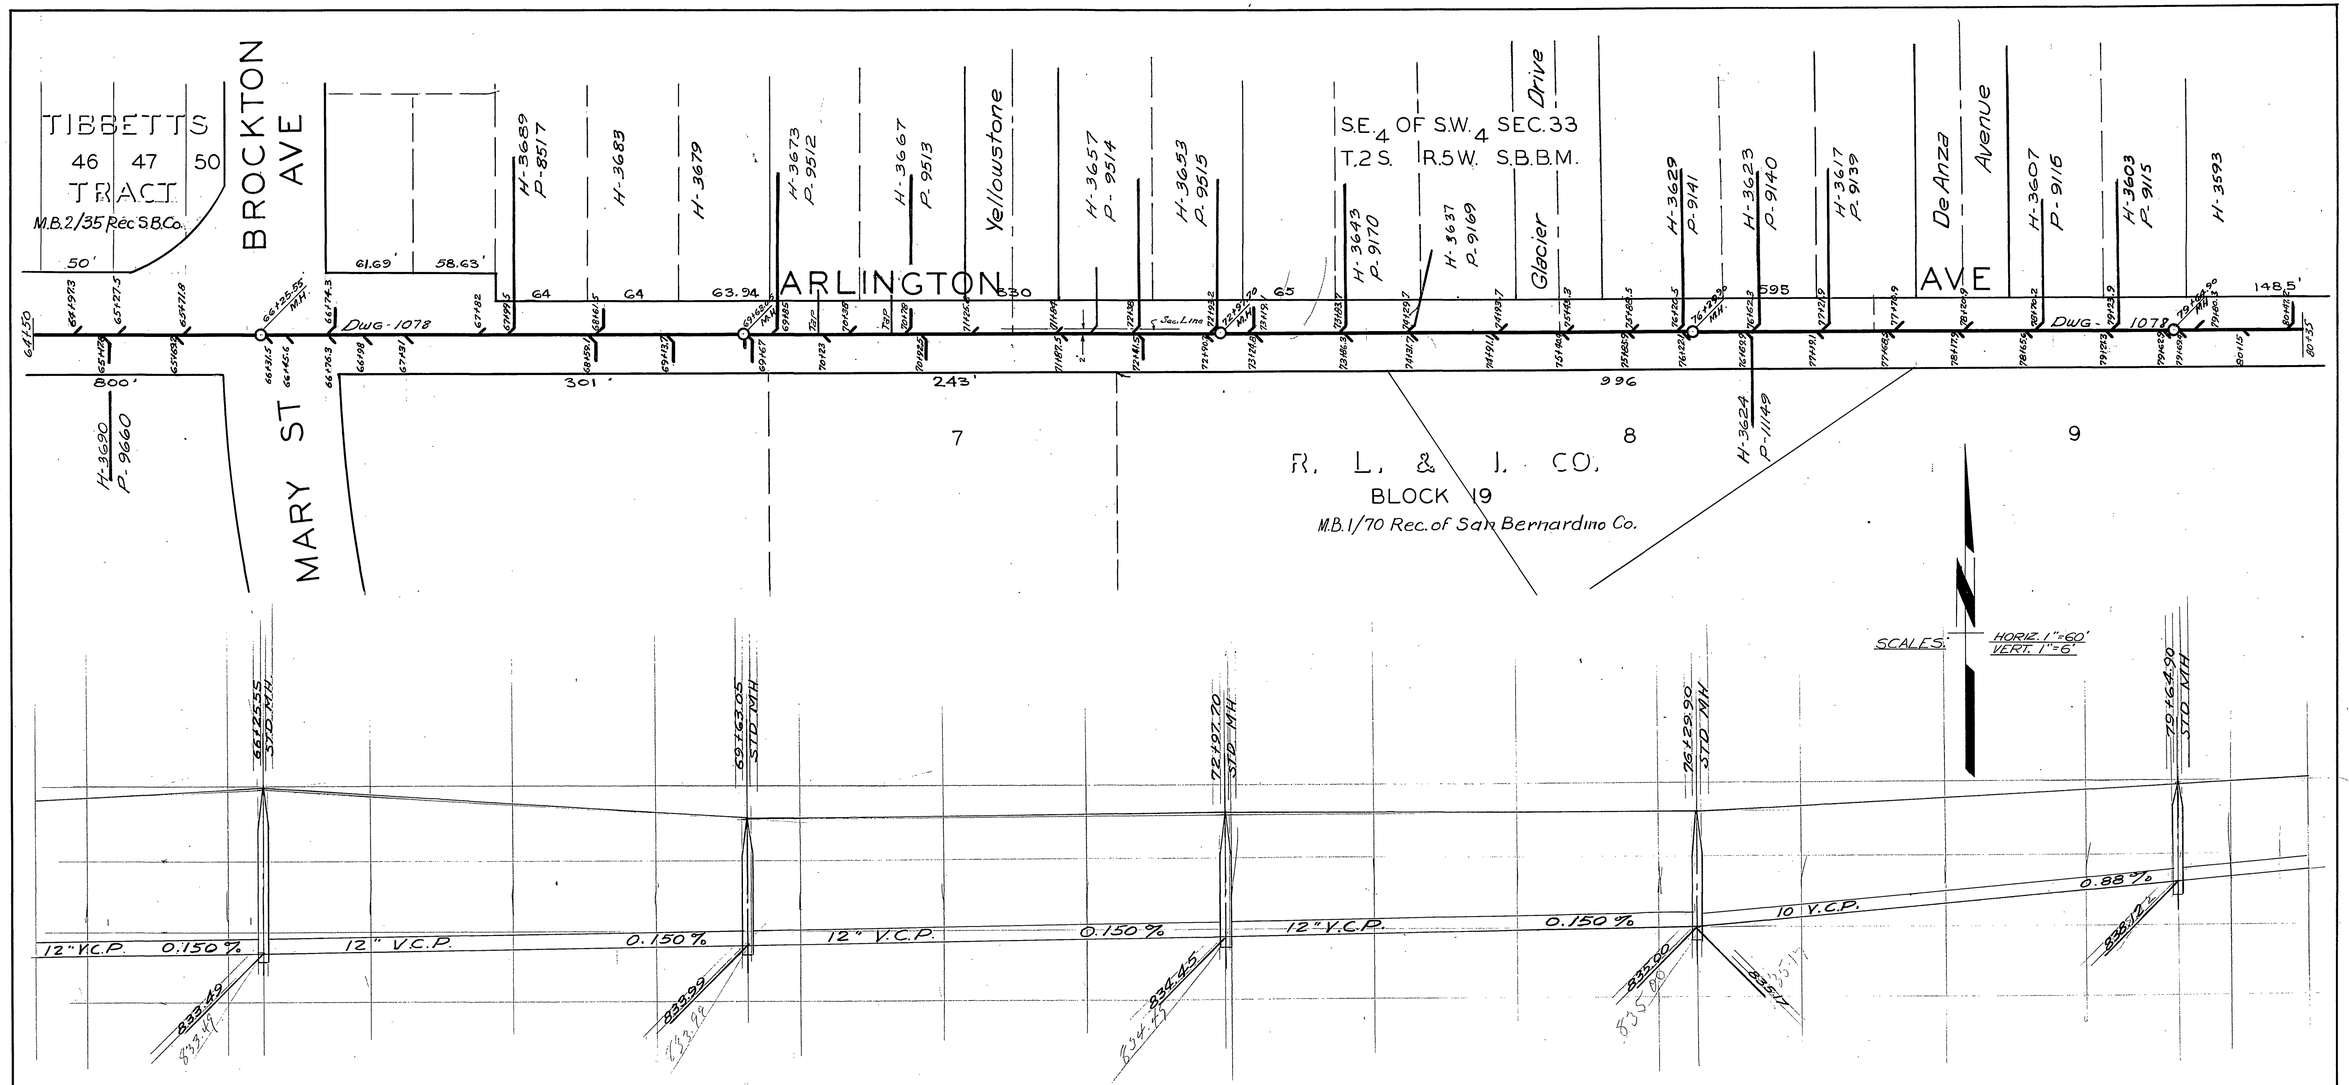
TIBBETTS TRACT
46 47 50
M.B. 2/35 Rec. S.B.Co.
BROCKTON AVE
MARY ST
ARLINGTON
Yellowstone
Glacier Drive
De Anza Avenue
AVE
S.E. 4 OF S.W. 4 SEC. 33
T.2 S. R.5 W. S.B.B.M.
R. L. & J. CO.
BLOCK 19
M.B. 1/70 Rec. of San Bernardino Co.
DWG - 1078
H-3689 P-8517
H-3683
H-3679
H-3673 P-9512
H-3667 P-9513
H-3657 P-9514
H-3653 P-9515
H-3643 P-9170
H-3637 P-9169
H-3629 P-9141
H-3623 P-9140
H-3617 P-9139
H-3607 P-9116
H-3603 P-9115
H-3593
H-3690 P-9660
H-3624 P-11149
SCALES: HORIZ. 1"=60' VERT. 1"=6'
12" V.C.P. 0.150%
12" V.C.P.
0.150%
12" V.C.P.
0.150%
12" V.C.P.
0.150%
10 V.C.P.
0.88%