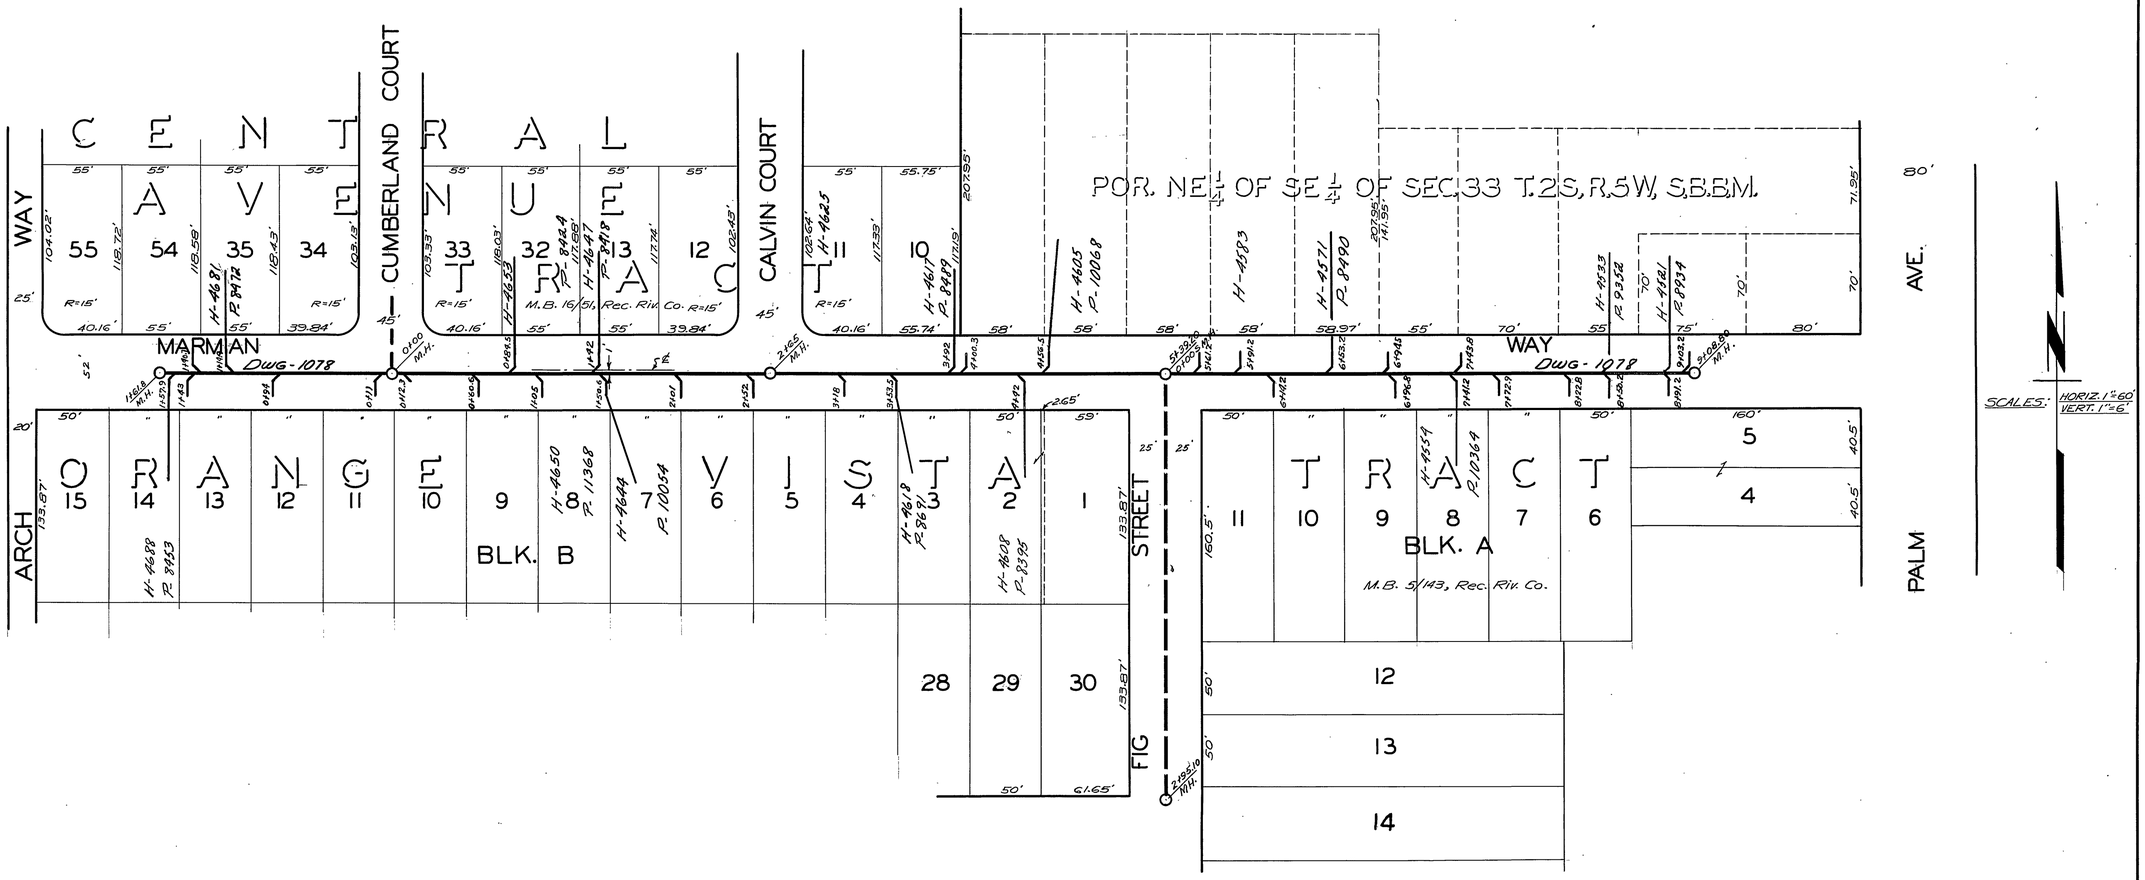
CENTRAL AVENUE
CUMBERLAND COURT
CALVIN COURT
MARMAN WAY
ARCH WAY
PALM AVE.
FIG STREET
POR. NE 1/4 OF SE 1/4 OF SEC. 33 T.2S, R.5W, S.B.B.M.
M.B. 16/51, Rec. Riv. Co.
ORANGE VISTA TRACT
BLK. B
BLK. A
M.B. 5/143, Rec. Riv. Co.
Dwg-1078
SCALES: HORIZ. 1"=60' VERT. 1"=6'