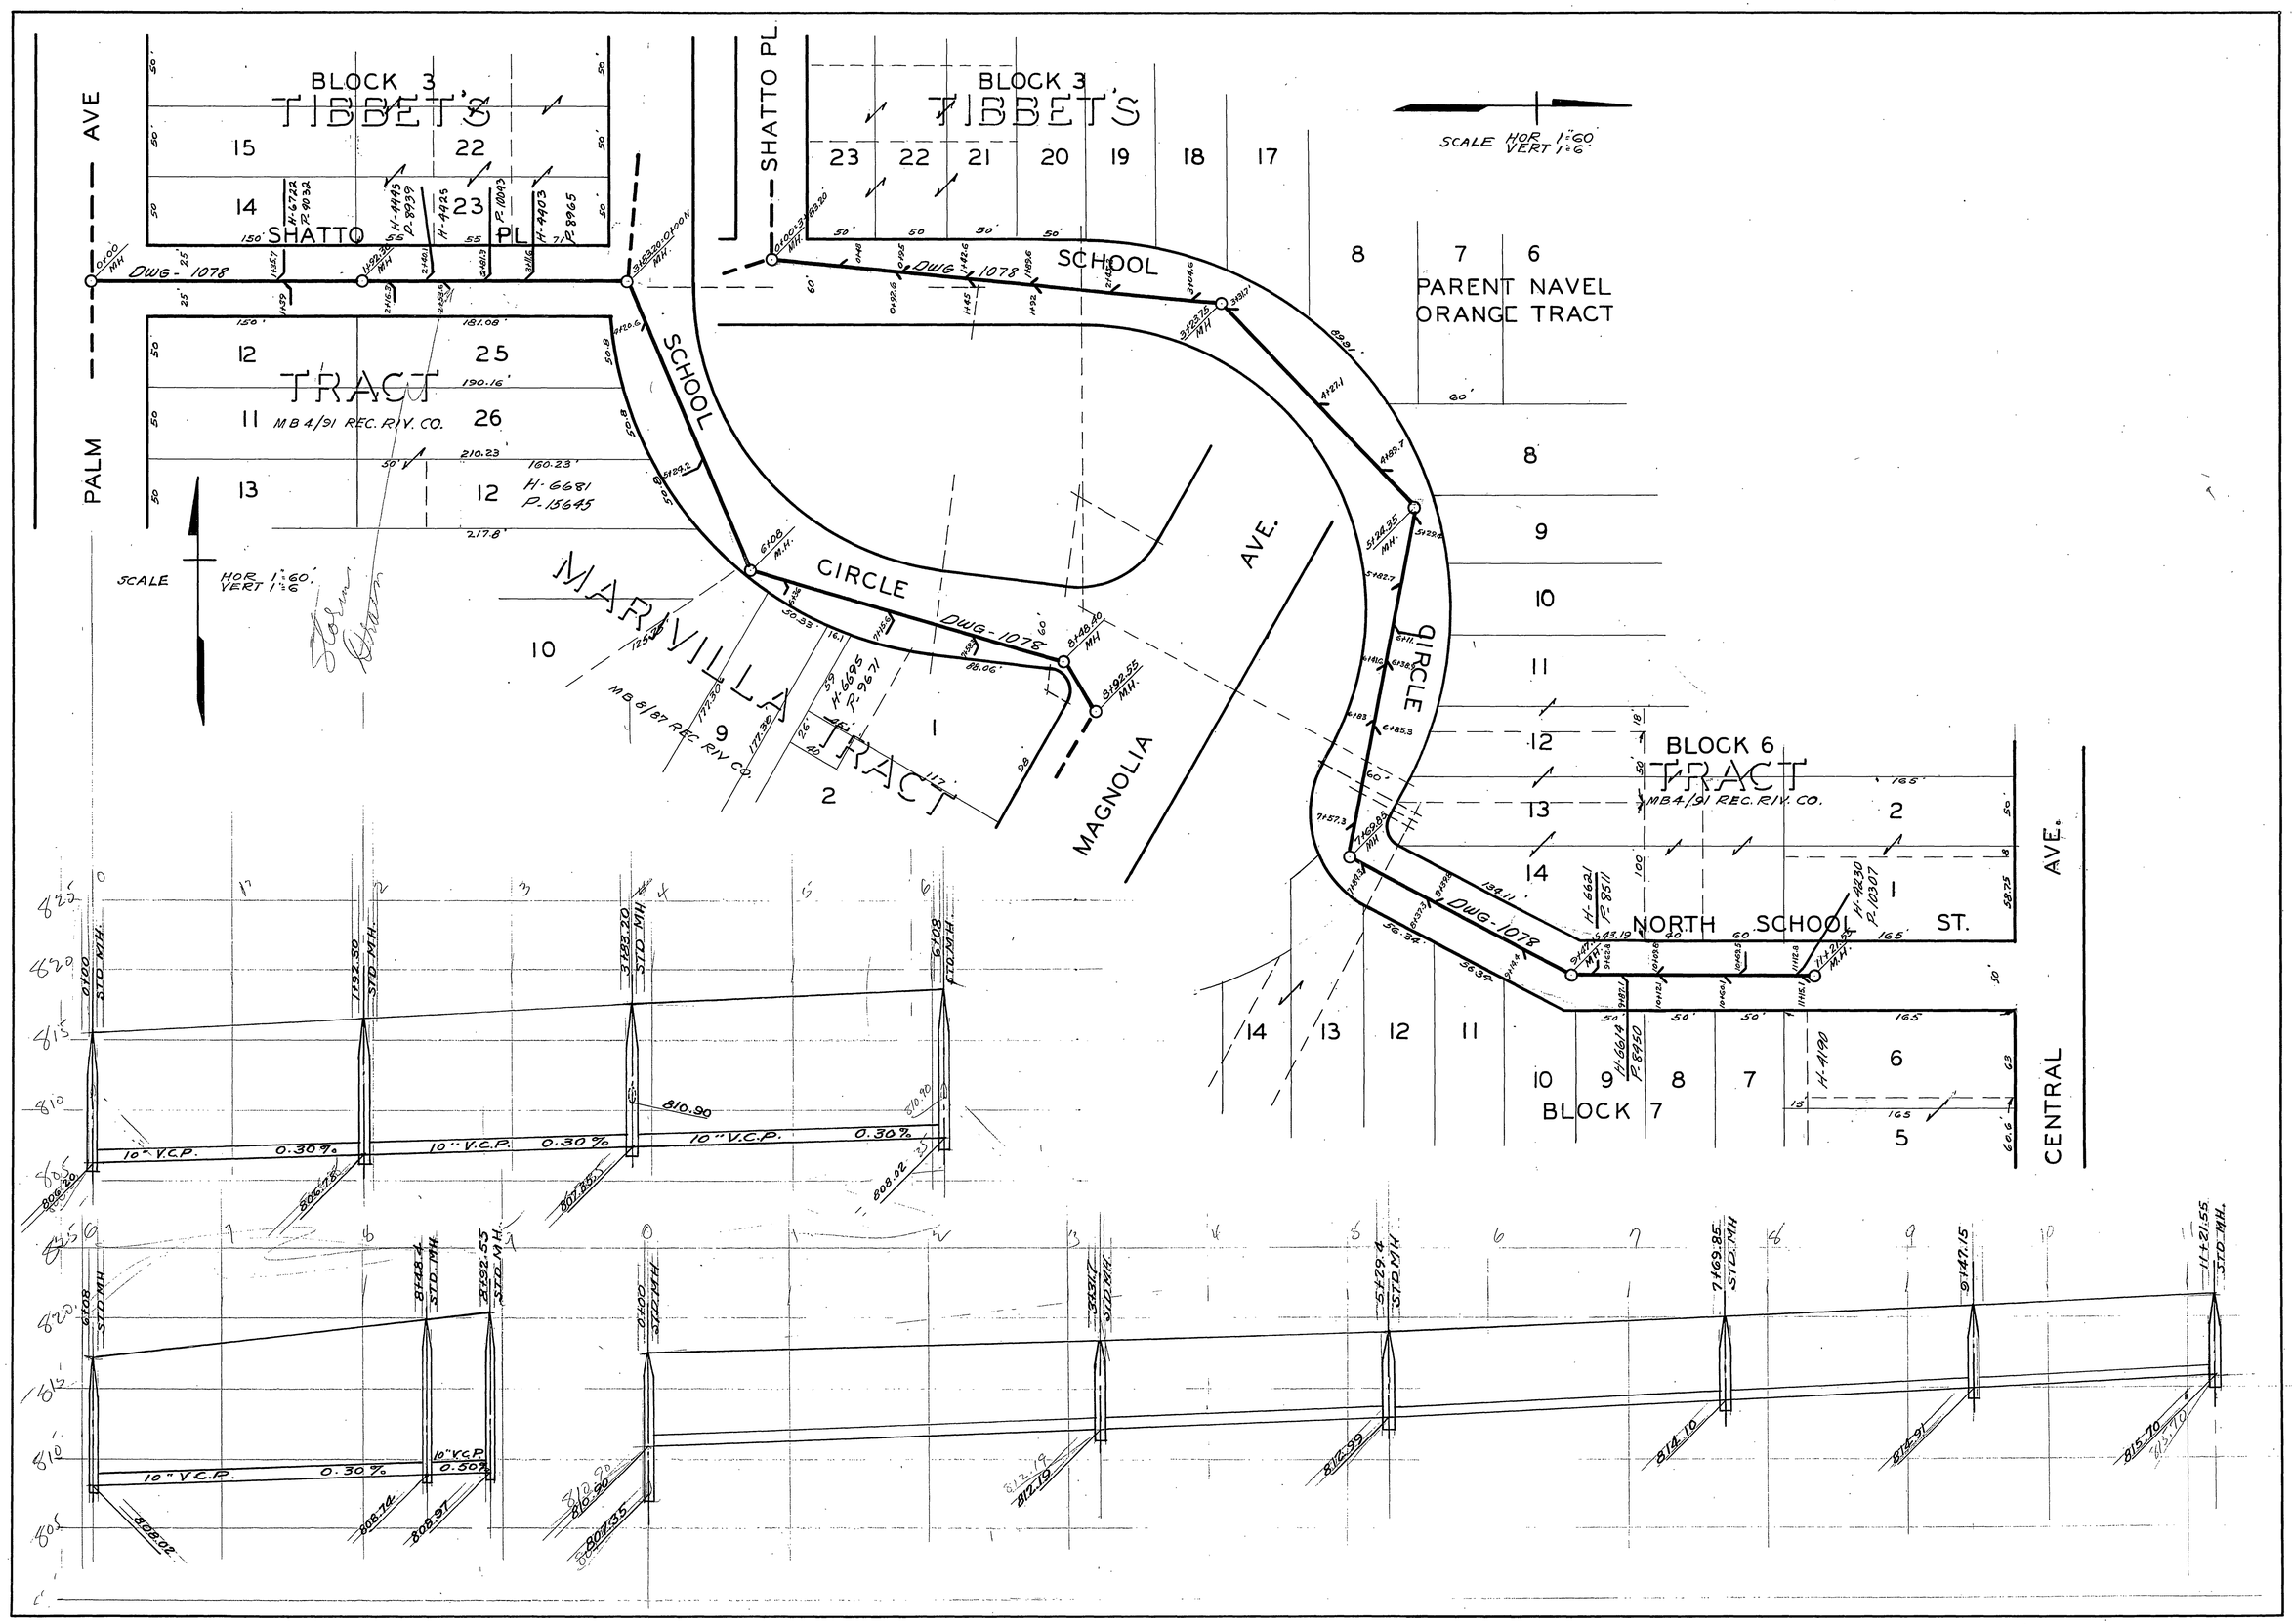

BLOCK 3
TIBBET'S
SHATTO PL.
PALM AVE
TRACT
MB 4/91 REC. RIV. CO.
SCALE HOR 1"=60' VERT 1"=6'
SCHOOL
CIRCLE
MARVILLA TRACT
MB 8/87 REC. RIV. CO.
MAGNOLIA AVE.
PARENT NAVEL ORANGE TRACT
BLOCK 6
NORTH SCHOOL ST.
BLOCK 7
CENTRAL AVE.
DWG-1078
10" V.C.P.
0.30%