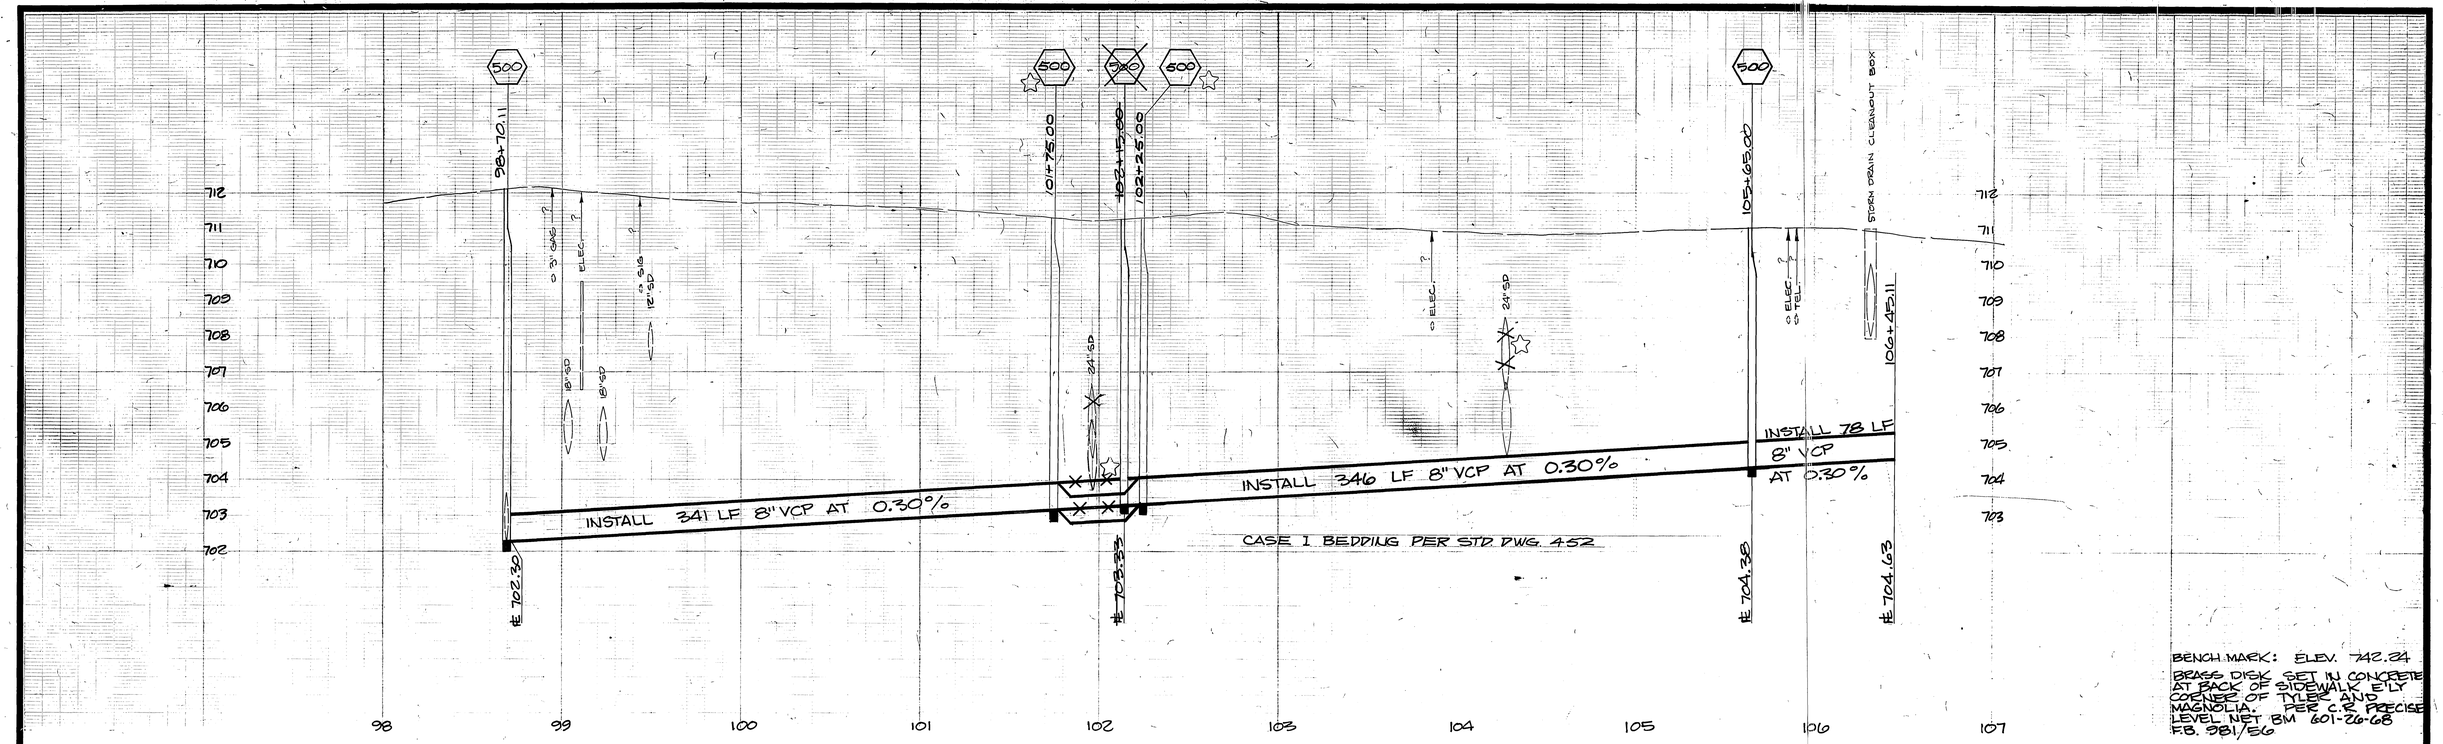


BENCH MARK: ELEV. 742.24
BRASS DISK SET IN CONCRETE AT BACK OF SIDEWALK E'LY CORNER OF TYLER AND MAGNOLIA. PER C.R. PRECISE LEVEL NET BM 601-26-68 F.B. 581/E6

## GENERAL CONSTRUCTION NOTES

500 CONSTRUCT MANHOLE PER C/R STANDARD DRAWING 500

2. STA. 106+45.11, PLUG 8" SEWER WITH BURNT CLAY DISC OR APPROVED EQUAL.

452 INSTALL PIPE BEDDING PER STD DWG 452 CASE I.

4. ⟺ ? EXACT DEPTH OF UTILITIES UNKNOWN; HOWEVER, INTERFERENCE WITH CONSTRUCTION IS NOT EXPECTED.

5. THE EXISTENCE AND LOCATION OF ANY UNDERGROUND UTILITY PIPES OR STRUCTURES SHOWN ON THESE PLANS ARE OBTAINED BY A SEARCH OF THE AVAILABLE RECORDS. TO THE BEST OF OUR KNOWLEDGE, THERE ARE NO EXISTING UTILITIES EXCEPT AS SHOWN ON THESE PLANS.

THE CONTRACTOR IS REQUIRED TO TAKE DUE PRECAUTIONARY MEASURES TO PROTECT THE UTILITY LINES SHOWN AND ANY OTHER LINES NOT OF RECORD OR NOT SHOWN ON THESE PLANS.




AS BUILT 11-30-76 GRW

-CAUTION-
PACIFIC TELEPHONE CABLES UNDERGROUND
BEFORE EXCAVATING CALL COLLECT:

| | 7:30 A.M. to 5 P.M. | After Hours & Holidays |
|---|---|---|
| Orange County | 714-633-0811 | 714-547-6606 |
| Riverside County | 714-684-0071 | 714-547-6606 |

FOR FREE CABLE LOCATING SERVICE
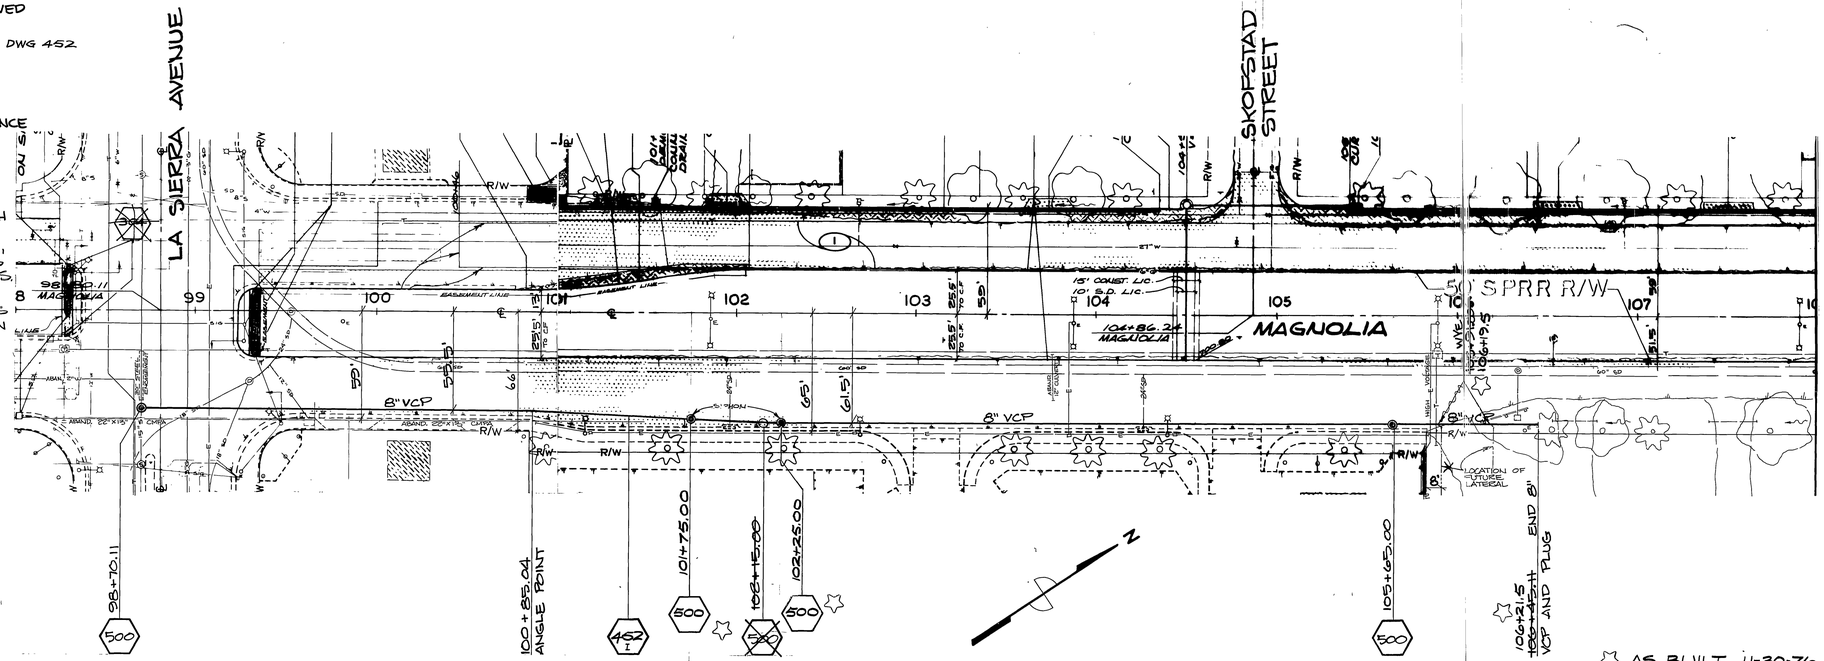
| MARK | REVISIONS | APPR. | DATE |
|---|---|---|---|

DESIGNED BY REH DRAWN BY [illegible] CHECKED BY [illegible]

CITY OF RIVERSIDE
PUBLIC WORKS DEPARTMENT

| APPROVED BY | | |
|---|---|---|
| PRINCIPAL ENGINEER | [illegible] | 7/15 |
| PARK DEPARTMENT | — | |
| TRAFFIC DIVISION | — | |
| CHIEF F. W. ENGINEER | [illegible] | 7/15 |

APPROVED [illegible] PUBLIC WORKS DIRECTOR
DATE 7-5-76

# MAGNOLIA SEWER EXTENSION AT LA SIERRA AVE.

ACCOUNT NO. 32 577 679
S-1036
SHEET 1 OF 1
FILE NO.

HORIZ. SCALE: 1" = 40' VERT. SCALE: 1" = 2'