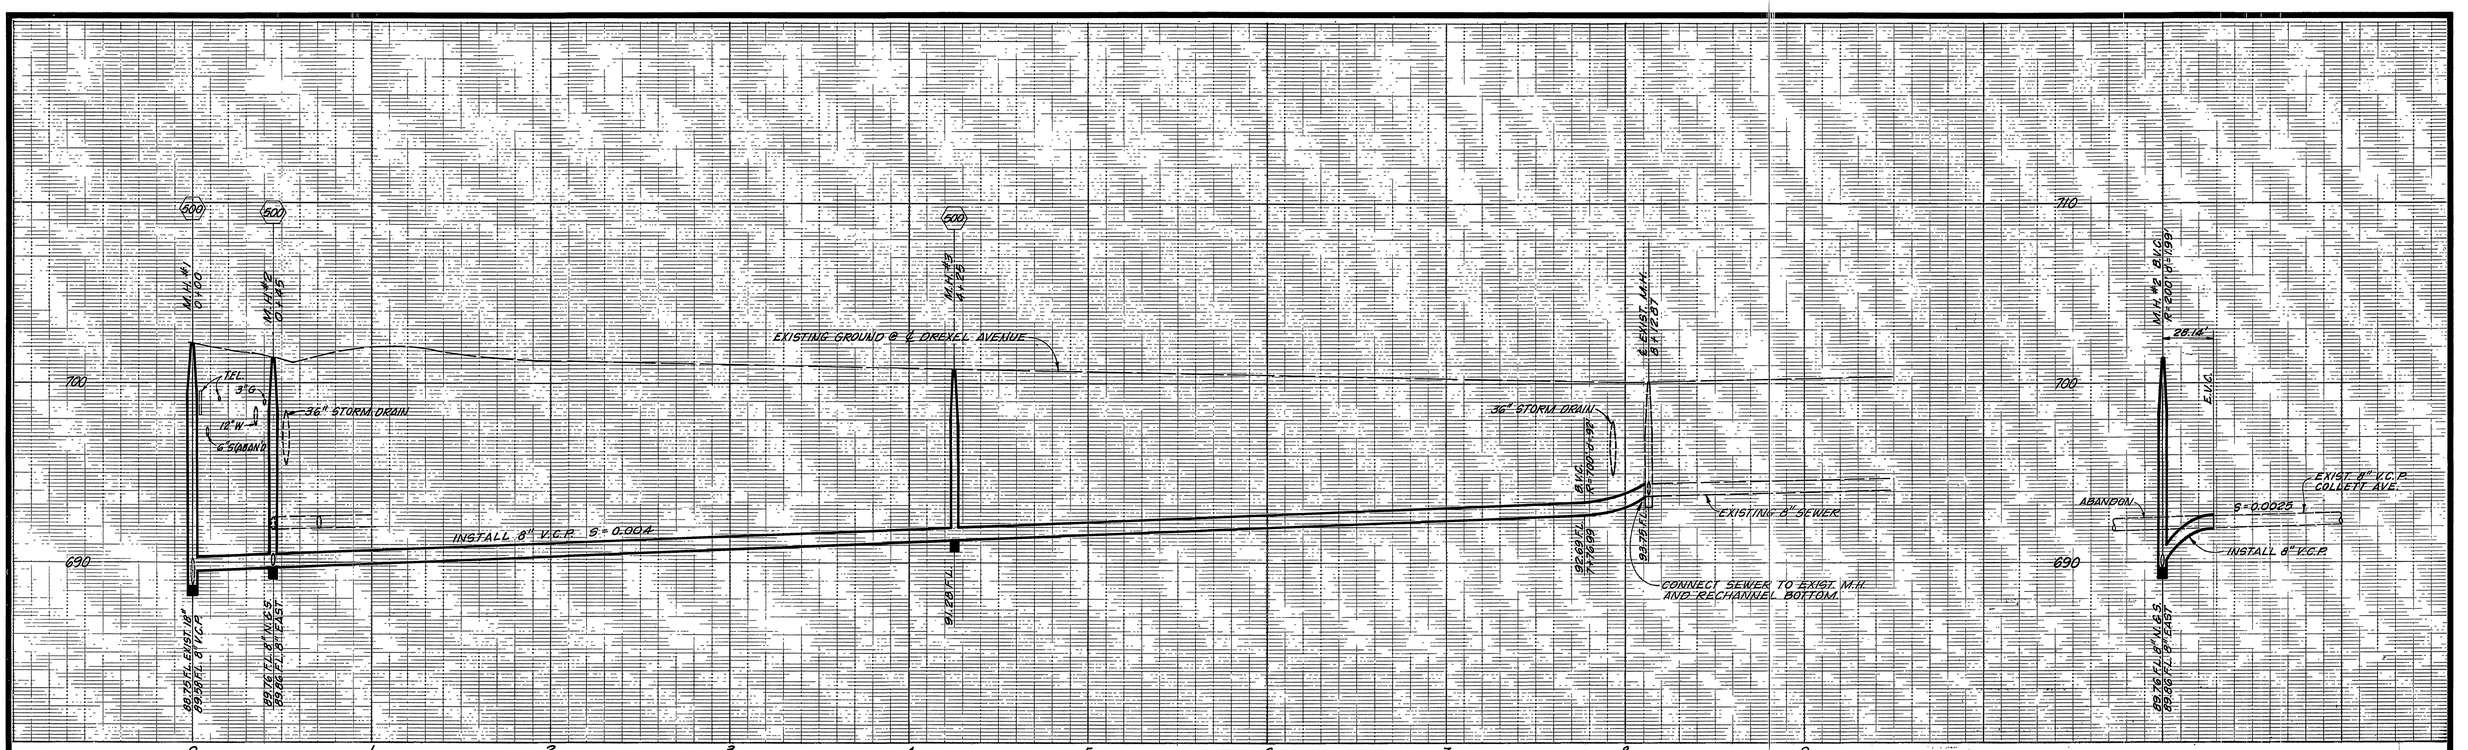

CONSTRUCTION NOTES

1. CONSTRUCTION SHALL BE IN ACCORDANCE WITH STANDARD SPECIFICATIONS FOR PUBLIC WORKS CONSTRUCTION, 1976 EDITION

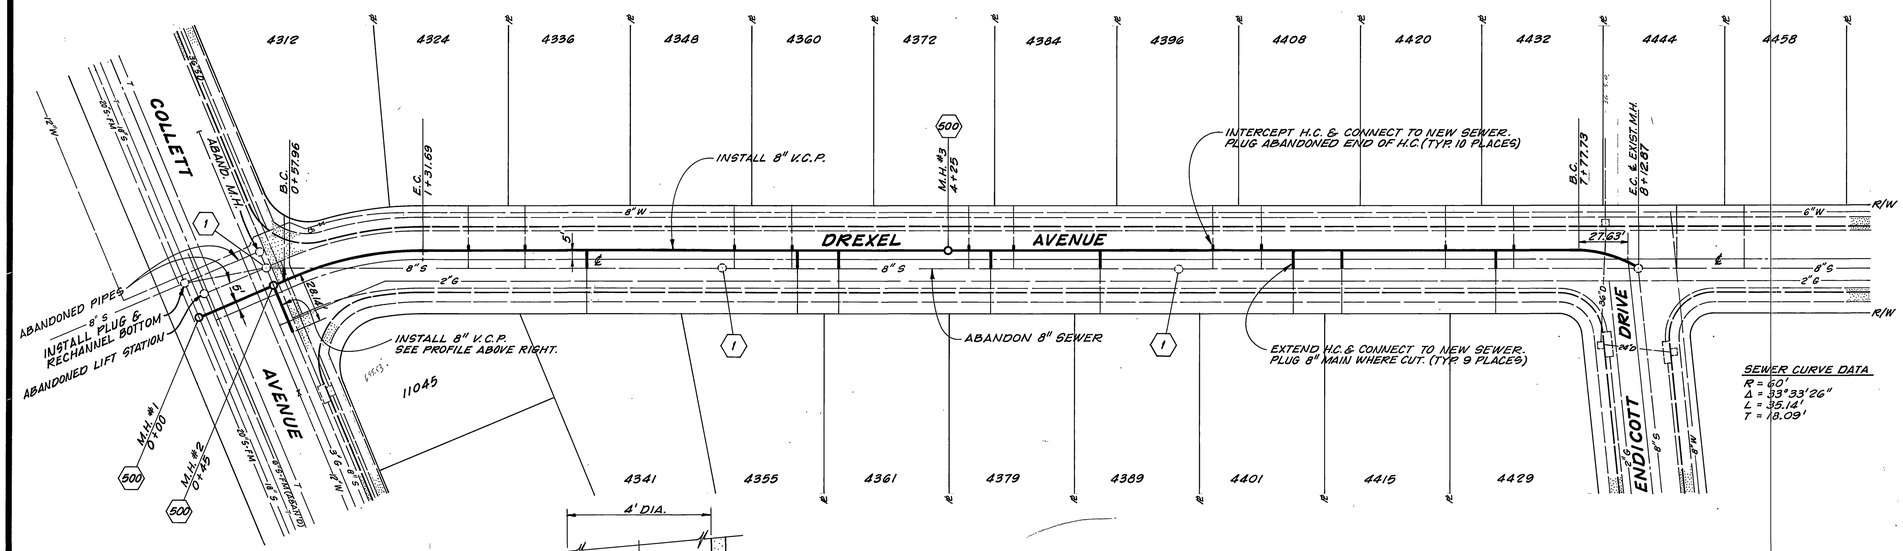

CONSTRUCTION LEGEND

(1) ABANDON EXISTING MANHOLE. FRAMES AND COVERS MAY BE USED IN NEW WORK.

(500) CONSTRUCT MANHOLE PER STANDARD DRAWING NO. 500.

SEWER CURVE DATA
R = 60'
Δ = 33°33'26"
L = 35.14'
T = 18.09'

AS BUILT
10-24-79
B.P

SEWER CURVE DATA
R = 185'
Δ = 22°50'
L = 73.73'
T = 37.36'

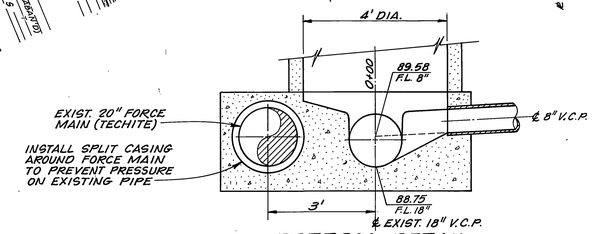

BOTTOM DETAIL MANHOLE NO. 1
Scale: 1" = 2'

CC.

CITY OF RIVERSIDE
DOMESTIC SYSTEM
APPROVED BY
CHIEF UTILITIES ENGINEER, WATER — DATE 1-9-77

MARK	REVISIONS	APPR.	DATE

DESIGNED BY KPT DRAWN BY KPT CHECKED BY

CITY OF RIVERSIDE
PUBLIC WORKS DEPARTMENT

APPROVED BY		
PRINCIPAL ENGINEER		11/10
PARK DEPARTMENT		
TRAFFIC DIVISION		
CHIEF P. W. ENGINEER		11-14

APPROVED BY
PUBLIC WORKS DIRECTOR
DATE 11-15-77

DREXEL AVENUE SEWER REPLACEMENT

COLLETT AVENUE TO ENDICOTT DRIVE

HORIZ. SCALE: 1" - 40' VERT. SCALE: 1" - 4'

INDEXED R.R
ACCOUNT NO. 32-577-583

S-1109

SHEET 1 OF 1

FILE NO.