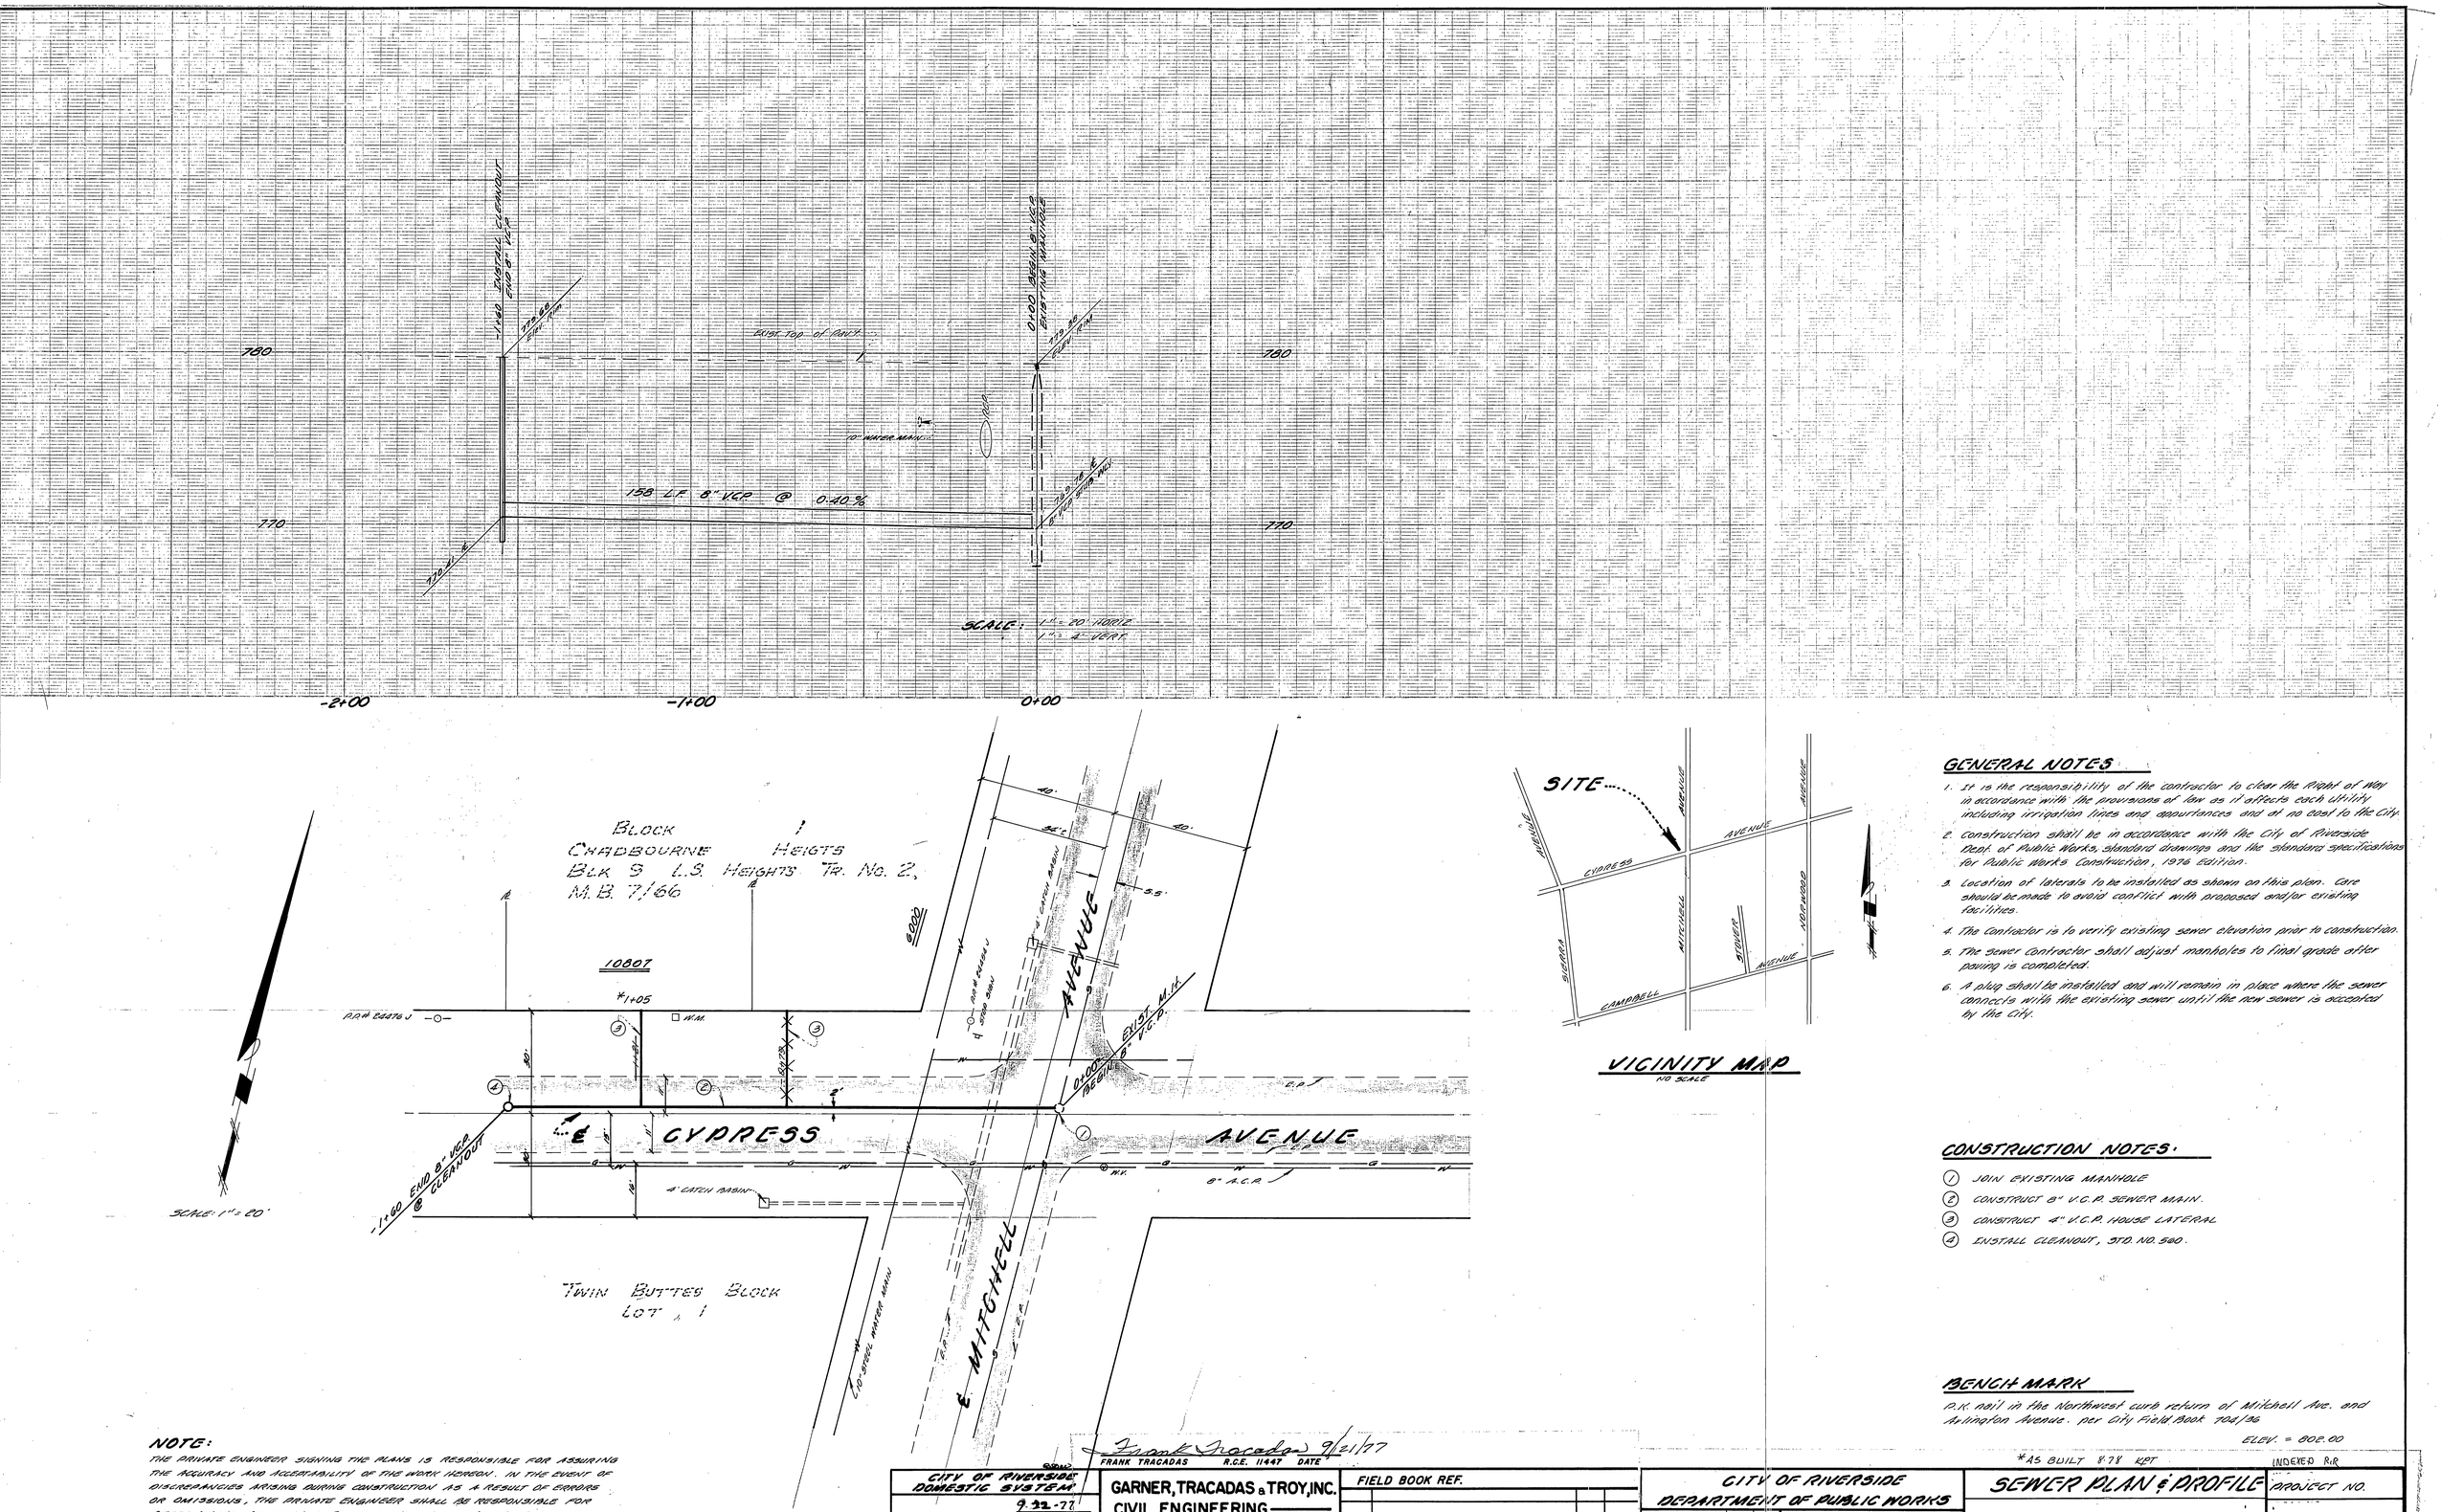
780
770
-2+00
-1+00
0+00
