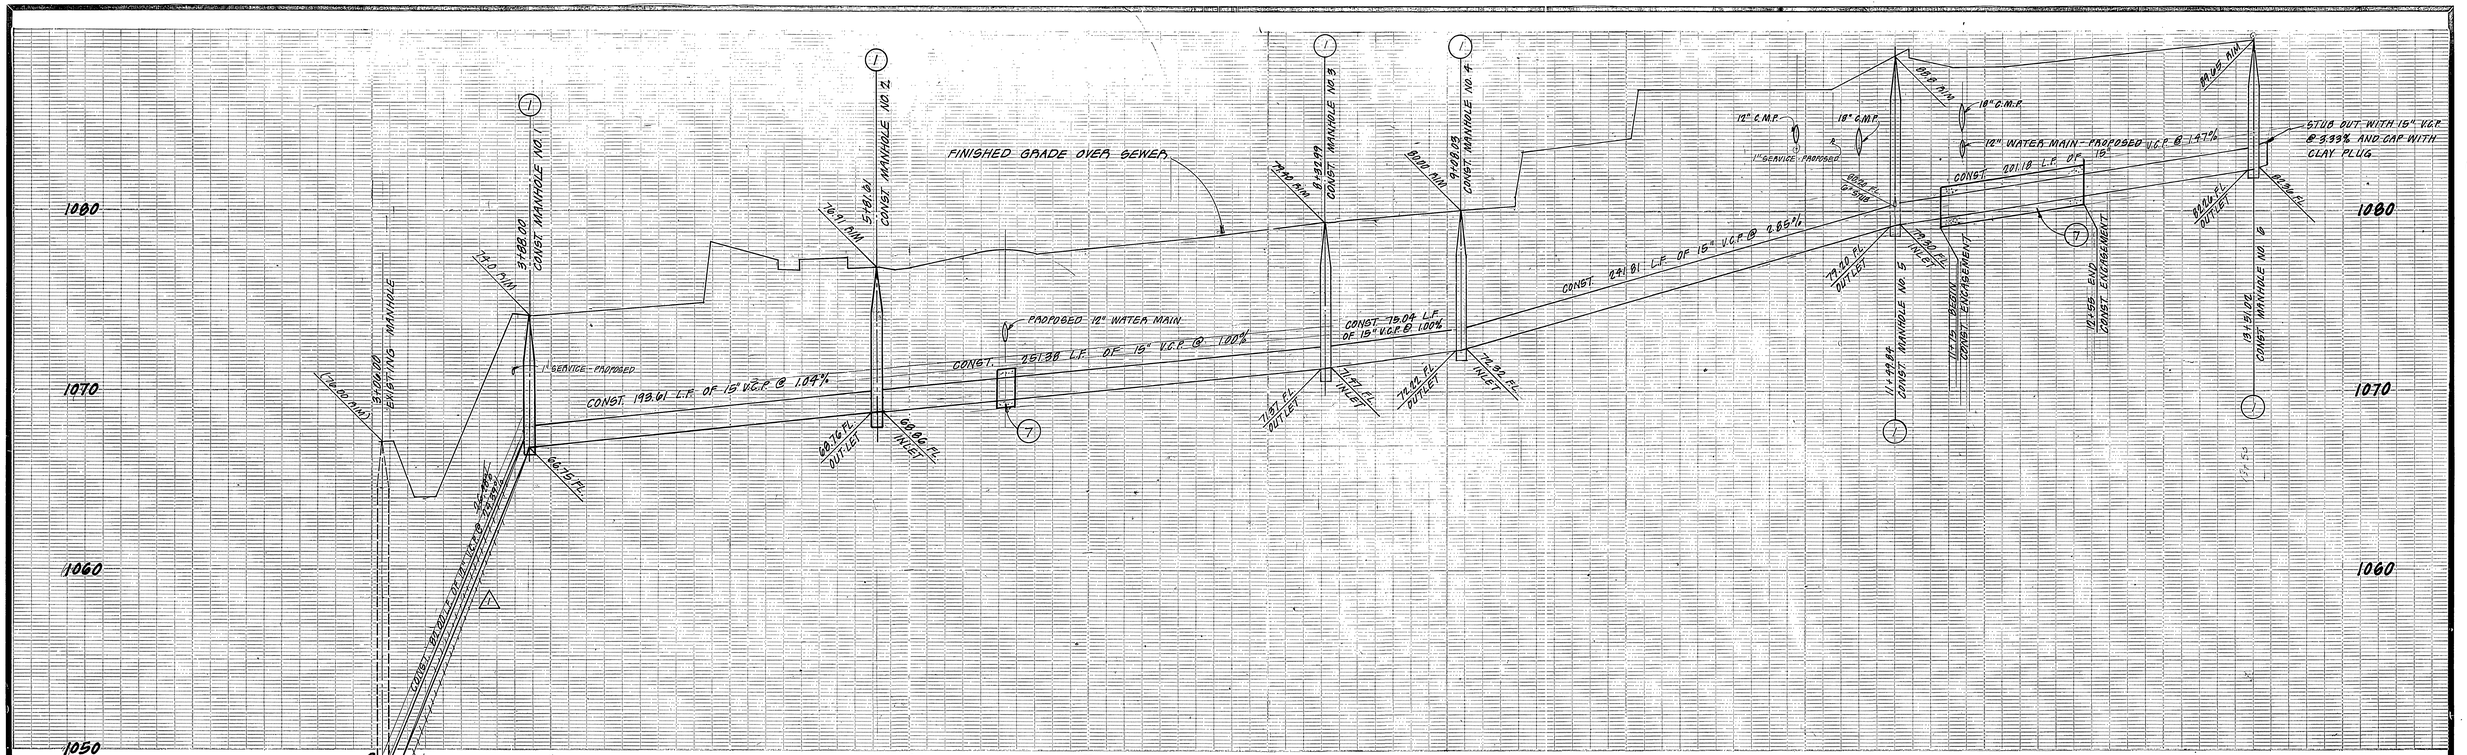

GENERAL NOTES

1. THE PRIVATE ENGINEER SIGNING THESE PLANS IS RESPONSIBLE FOR ASSURING THE ACCURACY AND ACCEPTABILITY OF THE WORK HEREON. IN THE EVENT OF DISCREPENCIES ARISING DURING CONSTRUCTION AS A RESULT OF ERRORS OR OMISSIONS, THE PRIVATE ENGINEER SIGNING THESE PLANS SHALL BE RESPONSIBLE FOR DETERMINING AN ACCEPTABLE SOLUTION AND REVISING THE PLANS FOR APPROVAL BY THE CITY.
2. LOCATION OF LATERALS TO BE DETERMINED IN THE FIELD AT THE DIRECTION OF THE OWNER. AVOID CONFLICT WITH PROPOSED AND OR EXISTING FACILITIES.
3. CONSTRUCTION SHALL BE IN ACCORDANCE WITH THE CITY OF RIVERSIDE DEPARTMENT OF PUBLIC WORKS AND THE STANDARD SPECIFICATIONS FOR PUBLIC WORKS CONSTRUCTION, 1979 EDITION.
4. IT SHALL BE THE RESPONSIBILITY OF THE CONTRACTOR TO CLEAR THE RIGHT OF WAY IN ACCORDANCE WITH THE PROVISIONS OF LAW AS IT AFFECTS EACH UTILITY INCLUDING IRRIGATION LINES AND APPURTENANCES, AND AT NO EXTRA COST TO THE CITY.
5. CONTRACTOR IS TO VERIFY EXISTING SEWER ELEVATION PRIOR TO CONSTRUCTION.
6. IT SHALL BE THE CONTRACTORS RESPONSIBILITY TO FAMILIARIZE HIMSELF WITH THE USE SITE AND ANY UNDERGROUND FACILITIES SHOWN OR NOT SHOWN ON THESE PLANS. THE ENGINEER WILL NOT BE RESPONSIBLE FOR ANY DAMAGE TO UNDERGROUND FACILITIES.
7. A PLUG SHALL BE INSTALLED AND WILL REMAIN IN PLACE WHERE THE NEW SEWER CONNECTS WITH THE EXISTING SEWER UNTIL THE NEW SEWER IS ACCEPTED BY THE CITY.
8. QUANTITIES SHOWN HEREON ARE FOR INFORMATION ONLY AND THE CITY OF RIVERSIDE IS NOT RESPONSIBLE FOR THEIR ACCURACY.

BENCH MARK

CITY OF RIVERSIDE BENCH MARK HB-G
SET P.K. NAIL AND TAG IN BASE OF LIGHT STANDARD AT THE BACK OF THE WEST CURB OF CANYON CREST DRIVE 60'± SLY OF ℄ CENTRAL AVE.
P.B. 84/1/20 12/11/78 ELEV. 1108.51

CONSTRUCTION NOTES

1. CONSTRUCT SEWER MANHOLE PER CITY OF RIVERSIDE STD. 500.
2. INSTALL 12" V.C.P. SEWER
3. INSTALL 15" V.C.P. SEWER
4. INSTALL 15"X15"X7" TEE
5. INSTALL 15"X15"X6" TEE
6. INSTALL 15"X15"X8" TEE
7. ENCASE SEWER (LATERAL) 4.5' EACH SIDE OF WATERLINE WITH TYPE 'C' CONC. ENCASEMENT PER STD. DRWG. - C.W.D. - 023.

* AS BUILT 8/11/82 FINAL! Indexed RKS LB

CITY OF RIVERSIDE DOMESTIC SYSTEM
APPROVED BY: Fred Lantz for
9/7/79 DATE
CHIEF UTILITIES ENGINEER, WATER

W. J. McKEEVER, INC.
CIVIL ENGINEERING
11-30-78 DATE
William J. McKeever
W.J. McKEEVER R.C.E. 22502
3564 CENTRAL AVENUE RIVERSIDE, CALIFORNIA
(714) 684-8300

MARK	REVISIONS	APPR.	DATE
⚠	REVISED GRADE TO FIT EXISTING ELEV. OF M.H. (2)		10/8/79
⚠	CHANGED LOCATION OF CONNECTIONS (1)		10/8/79

DESIGNED BY: BROWN DRAWN BY: BROWN CHECKED BY: R.A.

CITY OF RIVERSIDE
PUBLIC WORKS DEPARTMENT

	APPROVED	BY	DATE
PRINCIPAL ENGINEER			
PARK DEPARTMENT			
TRAFFIC DIVISION			
CHIEF P.W. ENGINEER			9-25

APPROVED BY: Public Works Director
DATE 9/25/79

SEWER PLAN AND PROFILE
TRACT NO. 10099-2
12" AND 15" SEWER MAIN

ACCOUNT NO. S-1195
SHEET 1 OF 1

HORIZ. SCALE: 1"=40' VERT. SCALE: 1"=4'