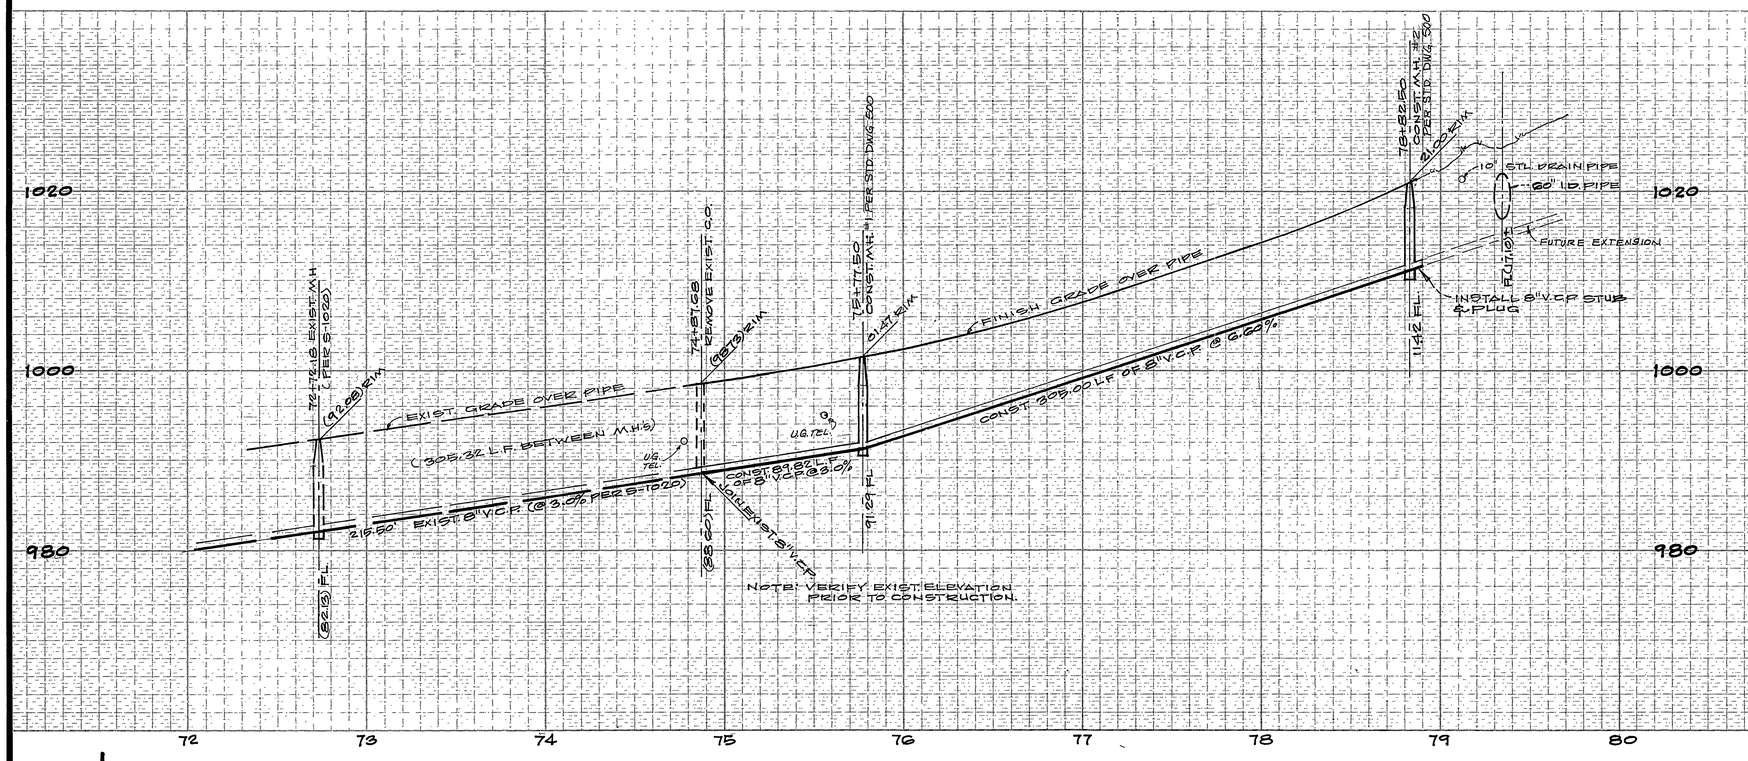

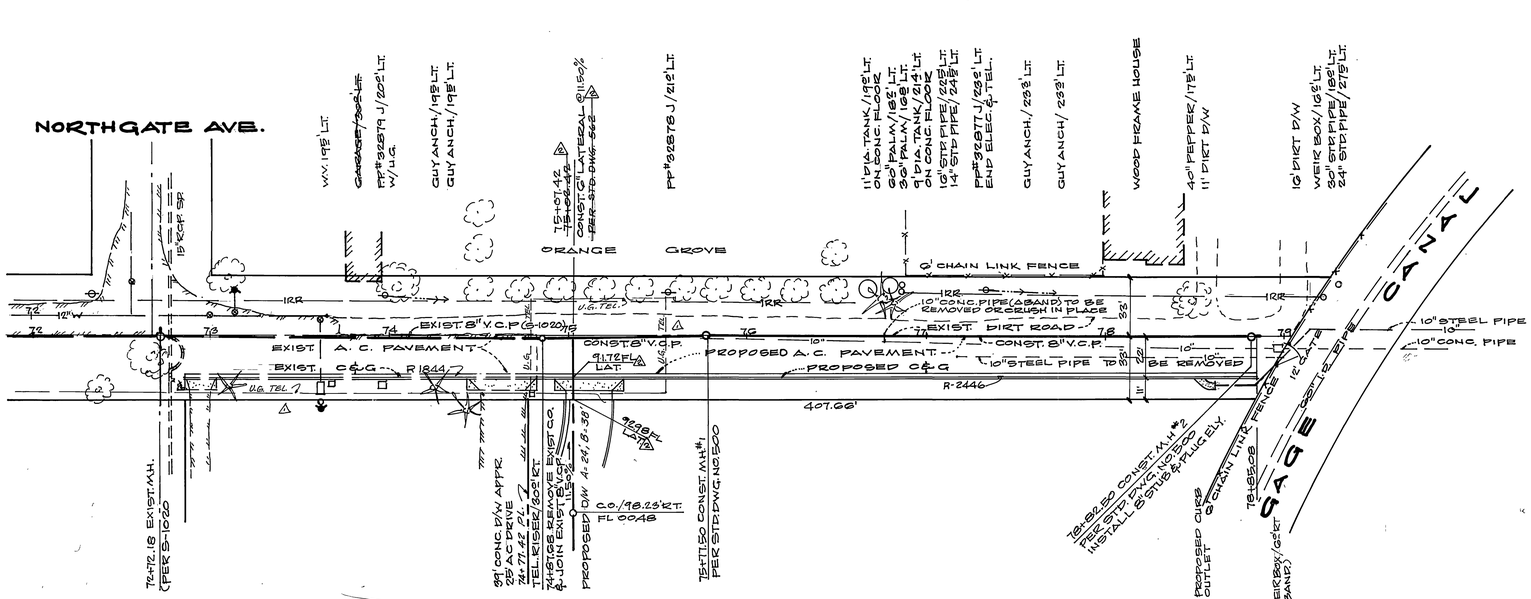

GENERAL CONSTRUCTION NOTES

1. CONSTRUCTION SHALL BE IN ACCORDANCE WITH THE CITY OF RIVERSIDE DEPARTMENT OF PUBLIC WORKS, STANDARD DRAWINGS, AND THE STANDARD SPECIFICATIONS FOR PUBLIC WORKS CONSTRUCTION, 1979 EDITION.
2. CONTRACTOR IS TO VERIFY EXISTING SEWER ELEVATION PRIOR TO CONSTRUCTION.
3. NO FINISHED FLOOR ELEVATION SHALL BE LESS THAN 4' ABOVE THE SEWER FLOW LINE AT POINT OF CONNECTION WITHOUT HAVING A PROPER BACKWATER VALVE INSTALLED IN THE LATERAL.
4. THE SEWER CONTRACTOR SHALL ADJUST MANHOLES TO FINAL GRADE AFTER PAVING IS DONE.
5. A PLUG SHALL BE INSTALLED AND WILL REMAIN IN PLACE WHERE THE NEW SEWER CONNECTS WITH THE EXISTING SEWER UNTIL THE NEW SEWER IS ACCEPTED BY THE CITY.
6. THE PRIVATE ENGINEER SIGNING THESE PLANS IS RESPONSIBLE FOR THE ACCURACY AND ACCEPTABILITY OF THE WORK HEREON, IN THE EVENT OF DISCREPANCIES ARISING DURING CONSTRUCTION, THE PRIVATE ENGINEER SIGNING THE PLANS SHALL BE RESPONSIBLE FOR DETERMINING AN ACCEPTABLE SOLUTION AND REVISING THE PLANS FOR APPROVAL BY THE CITY.
7. IT SHALL BE THE RESPONSIBILITY OF THE CONTRACTOR TO CLEAR THE RIGHT OF WAY IN ACCORDANCE WITH THE PROVISIONS OF LAW AS IT AFFECTS EACH UTILITY INCLUDING IRRIGATION LINES AND APPURTANCES AND AT NO COST TO THE CITY.

BENCH MARK

RIV. CITY B.M. GOD SPIKE IN PP#32881J (OLD#694539E)
NW COR. MALBOROUGH & CALIFORNIA
FB R-1/68; CR. PLAN S-1020.

ELEV. 991.29

AS BUILT 2.14.84 BRET!

INDEXED P.A. 4-30-82

PACIFIC TELEPHONE
APP'D BY _____ 4/30/82 DATE

CITY OF RIVERSIDE
DOMESTIC WATER SYSTEM
APPROVED BY _____ 3/26/82 DATE
Fred Lantz
WATER SYSTEMS MANAGER

HAWKINS, ROBERTSON & ASSOC.
ENGINEERS & SURVEYORS
3764 ELIZABETH STREET
RIVERSIDE, CALIF. 92506
PH. 684-9522
Charles E. Robertson 2/24/82
RCE. 15016 DATE
FOR: MALCOLM SMITH

MARK	REVISIONS	APPR.	DATE
3	REVISED C" LATERAL DUE TO CONFLICT IN CORRECT INSTALLATION BY CONTRACTOR	CEC	10-7-82
4	ADDED U.G. TEL. MANHOLE PER [illegible]	CEC	4-20-83

DESIGNED BY G.H. DRAWN BY G.H. CHECKED BY CEC

CITY OF RIVERSIDE, CALIFORNIA
PUBLIC WORKS DEPARTMENT

APPROVED BY	BY	DATE
PRINCIPAL ENGINEER	[illegible]	9/1/82
PARK DEPARTMENT		
TRAFFIC DIVISION		
CHIEF PUB. WKS. ENGR.	[illegible]	9/2/82

APPROVED BY _____
DIRECTOR OF PUBLIC WORKS
DATE 9/2/82

SEWER PLAN & PROFILE
MARLBOROUGH AVENUE SEWER EXTENSION
MP-G-812
850 MARLBOROUGH

SCALE: HORIZ. 1"=40', VERT. 1"=8'

ACCOUNT No.
DRAWING NUMBER S-1296
SHEET 1 OF 1
82-3311