


PLAN - HURON STREET

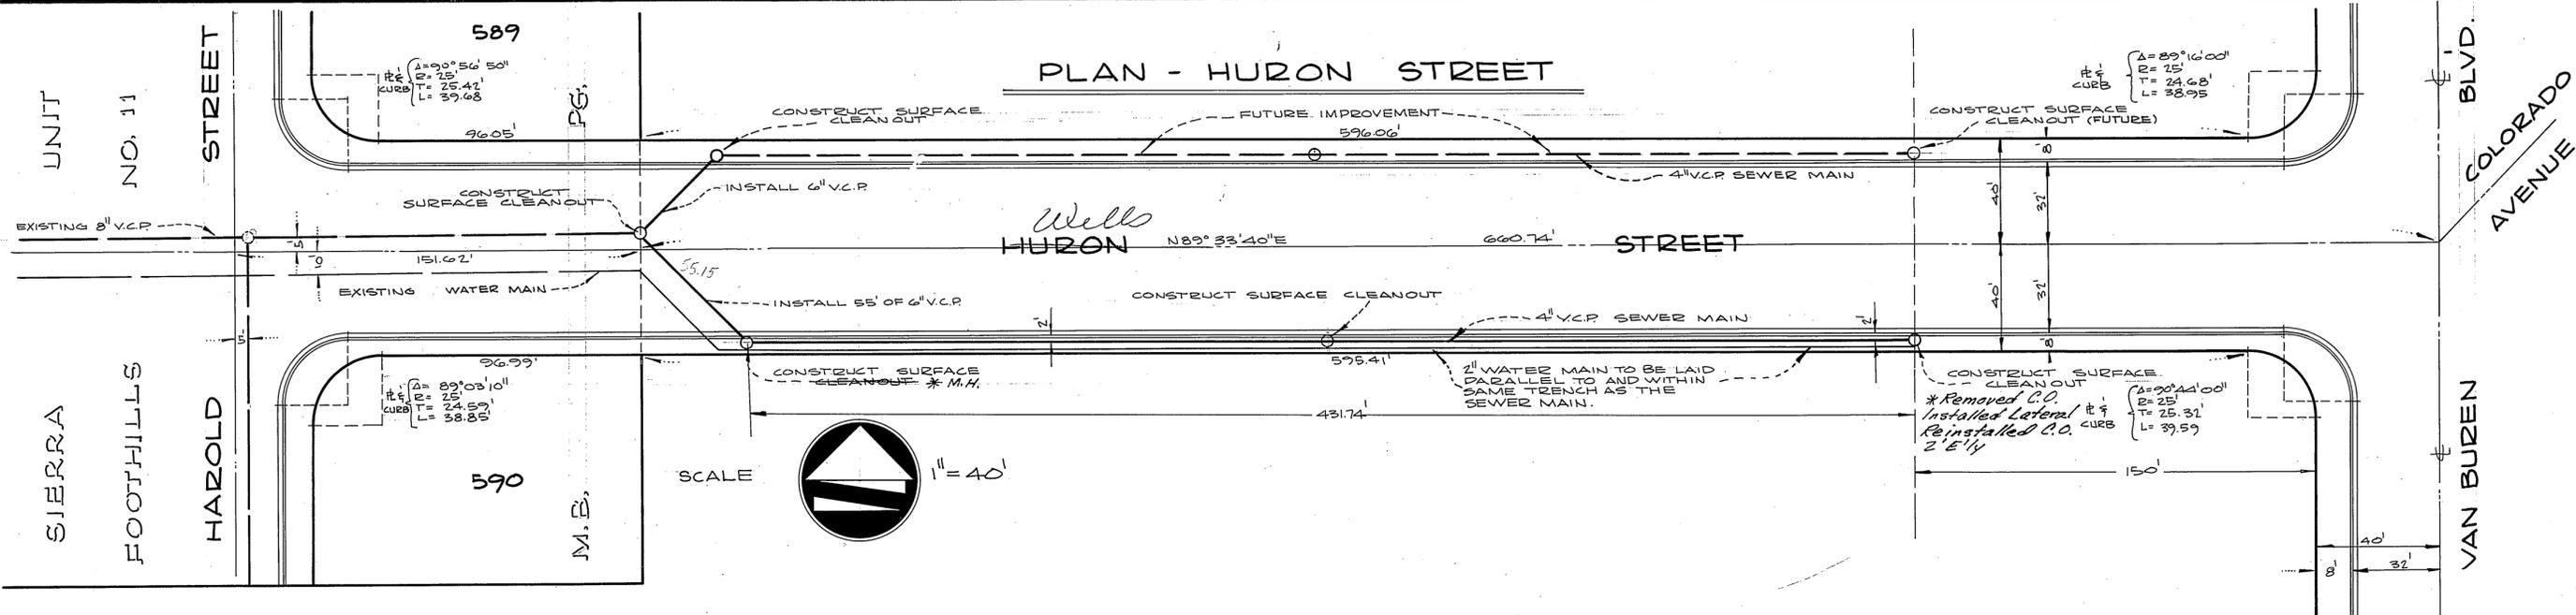


PLAN - PROFILE

OF SEWER AND WATER MAIN EXTENSION FROM THE EASTERN LINE OF SIERRA FOOTHILLS TRACT NO. 11, TO VICINITY OF VAN BUREN BLVD. June 15, 60

PREPARED FOR: ANZA REALTY COMPANY 5708 VAN BUREN BLVD. ARLINGTON, CALIFORNIA

PREPARED BY: MAXWELL SURVEYING 324 COURT STREET SAN BERNARDINO, CALIFORNIA

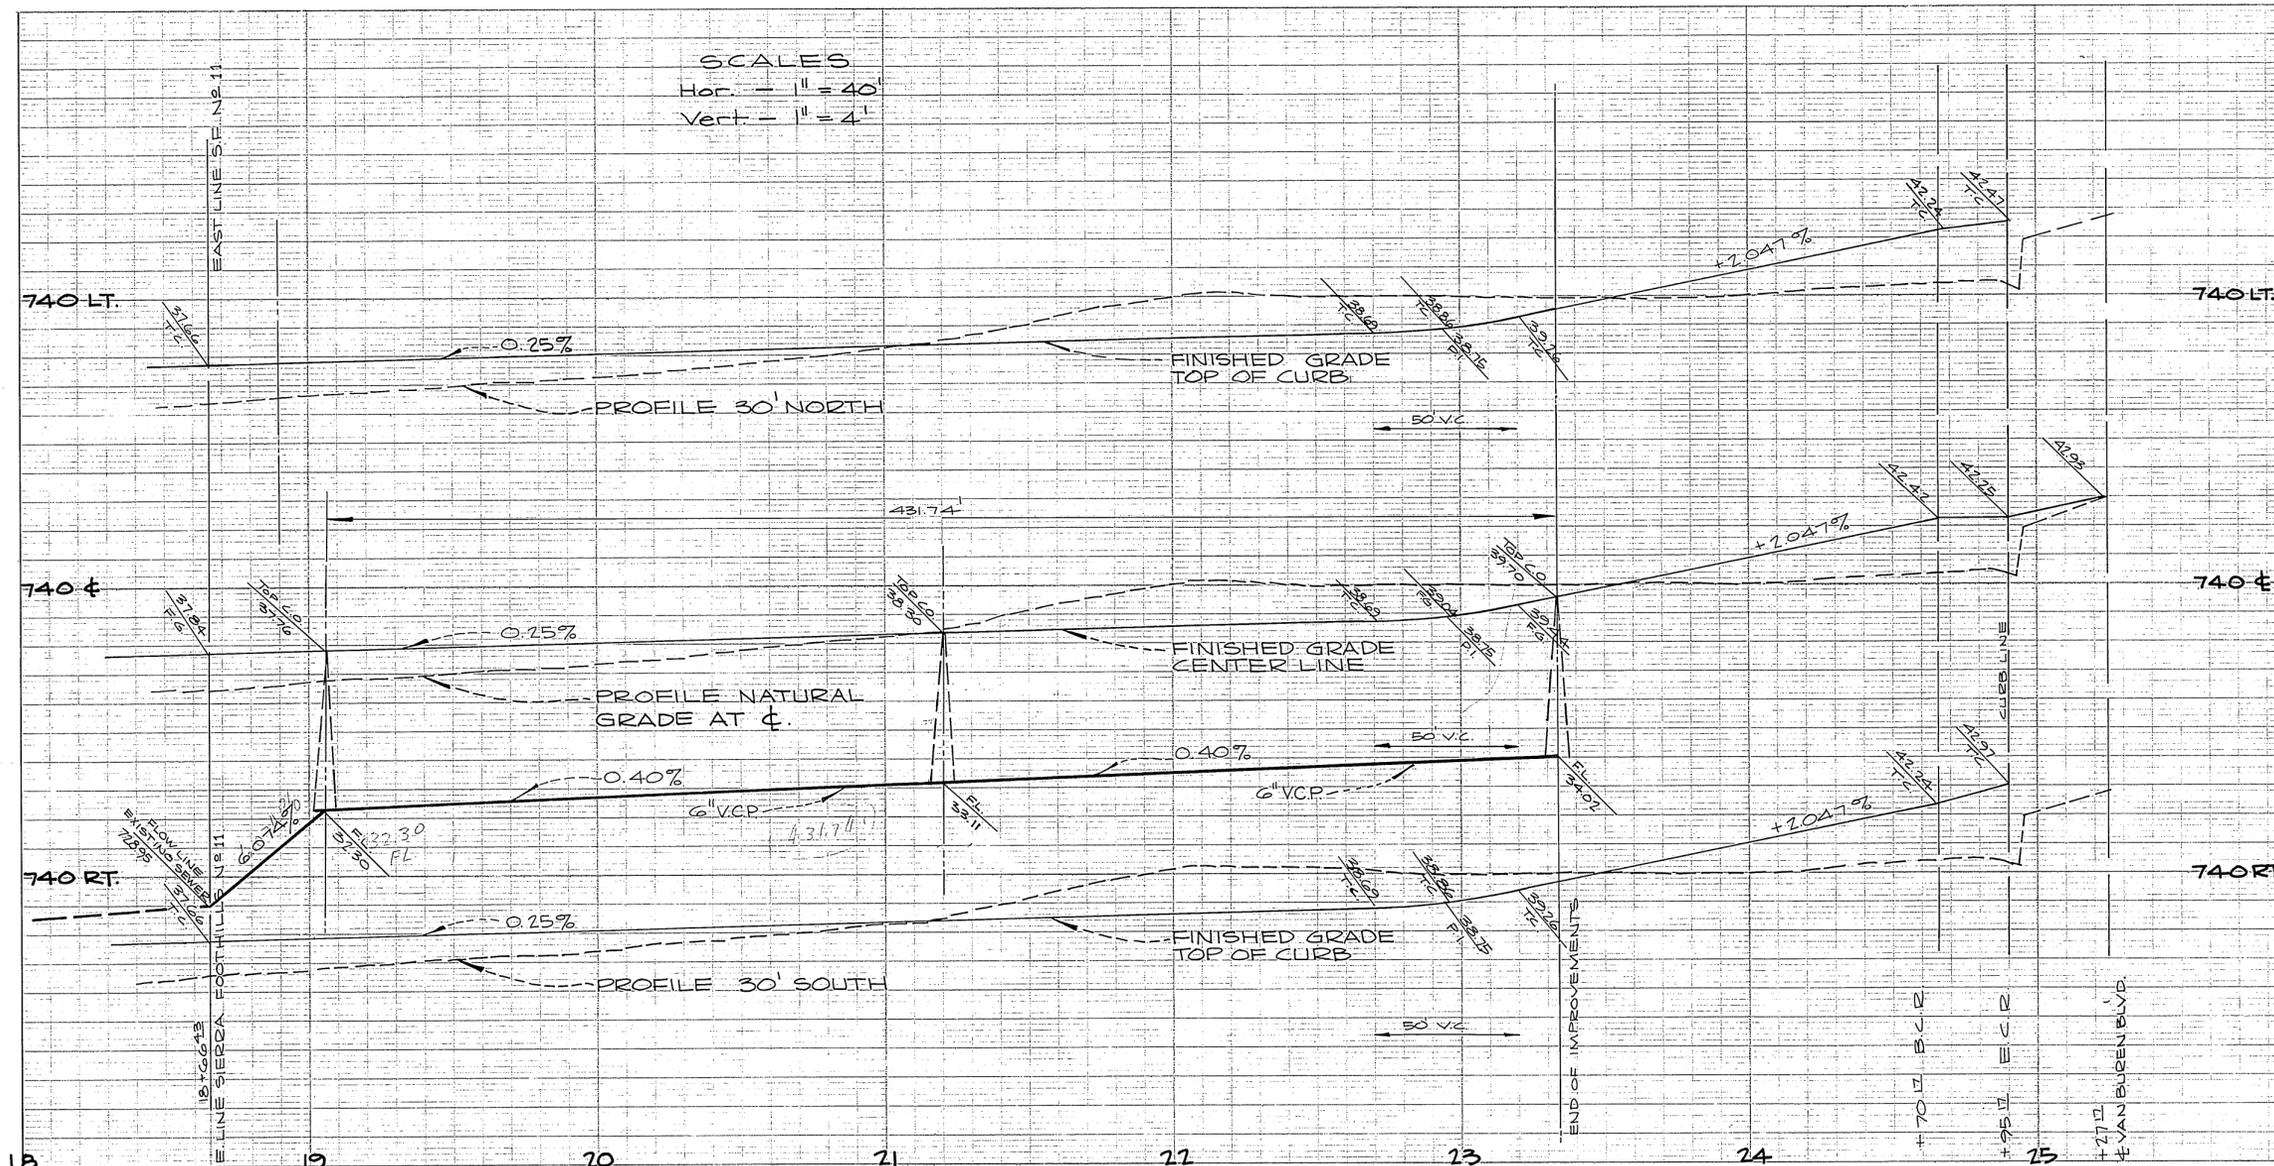

PROFILE - HURON STREET