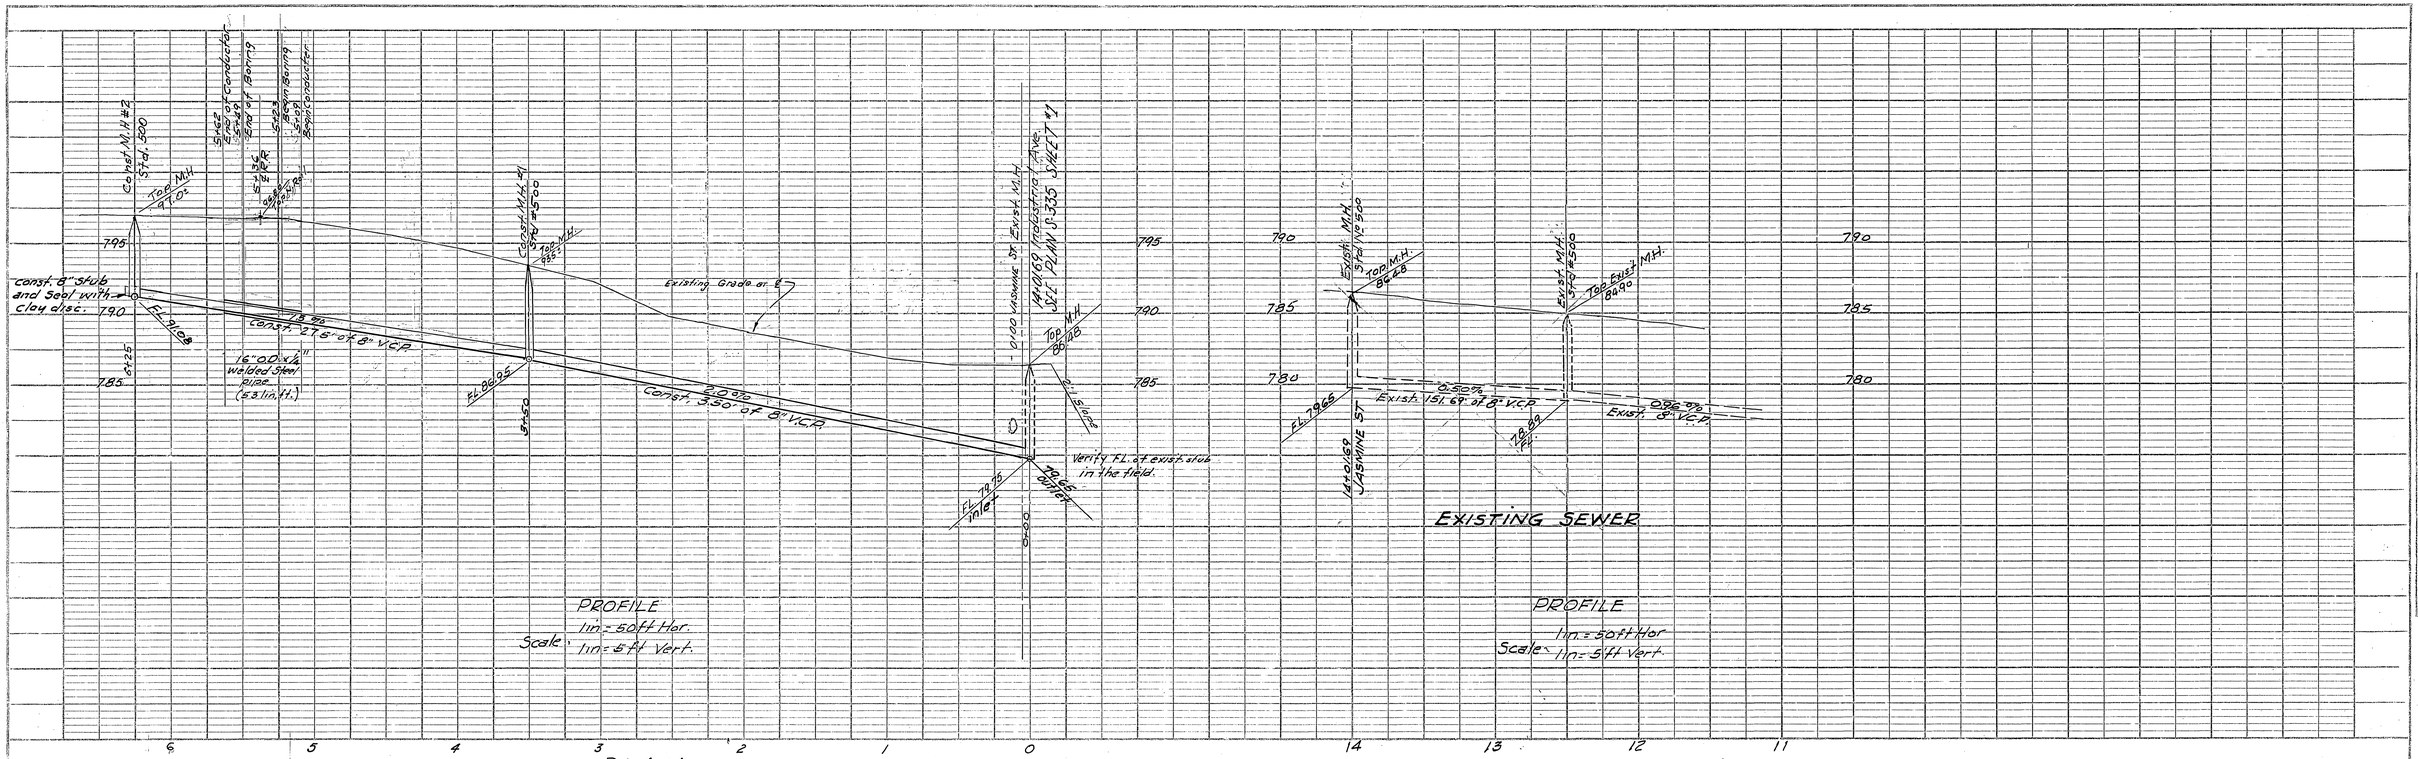

Notes:
1. Plug ends of casing
2. 1" drain in lower end of casing

NOTES

1. All M.H. covers to be set flush with pavement after pavement has been installed
2. 4" wyes to be located in the field, laterals to be installed by others.
3. All construction to be in conformance with Standard Specifications No. 461 City of Riverside
4. Where sewer trench passes under curb, gutter or sidewalk, trench shall be backfilled and tamped to 90% of rel. compaction
5. The contractor is required to take due precautionary measures to protect the utilities or structures shown and any other utilities or structures at the site. It shall be the contractors responsibility to notify the owners of the utilities or structures concerned before starting work.
6. Pipe shall be bedded per Case II, Std. Drawing No. 452
7. Joints in V.C.P. sewers shall conform to A.S.T.M. std C-425-60T, or the latest Revision thereof.

BENCH MARK: R.R. Spike in Power Pole No: 15107-J
N.E. Cor. Industrial Ave. & Fremont St.
Elev. 777.10

★ As built 2.18.64 G.S.

McKEE & CRAWLEY
SURVEYORS AND ENGINEERS
Riverside, California
Approved George O. Crawley R.E. No. 9455
Field Bk.
Date June 20-63

REVISIONS		
MARK	DATE	DESCRIPTION
1	12-6-63	Proposed 8" water main. Taken from Public Utilities Drawing # D2-4086.
2	12-12-63	Proposed underground telephone line. Taken from telephone Co. Dwg. Rec'd 12-11-63. Const. date unknown.

CITY OF RIVERSIDE, CALIFORNIA
DEPARTMENT OF PUBLIC WORKS

SEWER PLAN & PROFILE
JASMINE STREET
From Industrial Ave. to 625' Sly.

DESIGNED BY
DRAWN BY
CHECKED BY Ron
RECOMMENDED BY
APPROVED BY
DIRECTOR OF PUBLIC WORKS
Nov 6, 1963

S-424
SHEET 1 OF 1

PROFILE
NOTE BOOK
NO.
SURVEYED
PLOTTED
GRADES CHECKED
B.M. NOTED
STRUCTURE NOTATNS CH'KD
BY
DATE

PLAN
NOTE BOOK
NO.
SURVEYED
PLOTTED
ALIGNMENT CHECKED
RT. OF WAY CHECKED
BY
DATE