NOTE - INSTALL ADDITIONAL WYES AS SHOWN ON WEST SIDE POLK STREET & PLUG

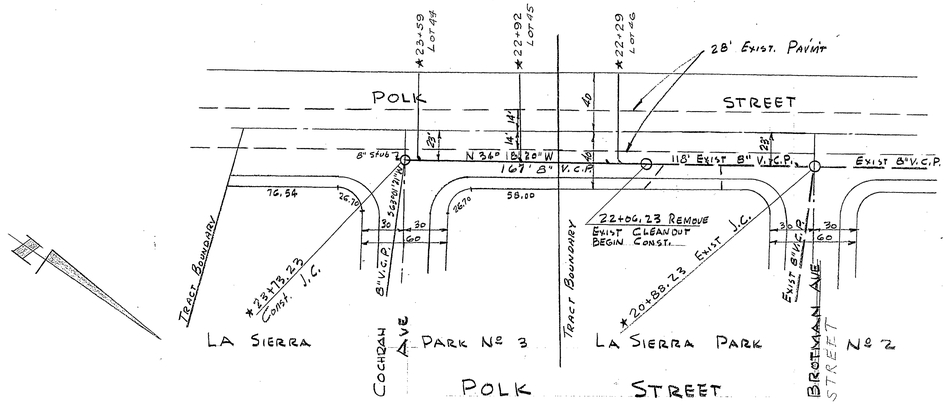

PLAN
SCALE 1" = 50'

QUANTITY ESTIMATE

MANHOLES	3 EA.
JUNCTION CHAMBERS	1 EA.
8" V.C.P. SEWER	1076 LIN. FT.
4" V.C.P. SEWER	810 LIN. FT.

GENERAL NOTES

1. USE STANDARD MANHOLE STRUCTURE No 35
2. USE 4" V.C.P. FOR HOUSE CONNECTIONS.

RIVERSIDE COUNTY HEALTH DEPARTMENT

___FOOD ESTABLISHMENT	___SEWAGE DISPOSAL
___TRAILER PARK	___GAL SEPTIC TANK
___MOTEL, APT., HOTEL	___SQ. FT. OF LEACH LINE
___DWELLING	X SEEPAGE PIT
___COMMERCIAL BUILDING	___CONNECTION TO SEWER
___WATER SOURCE	X SEWER LINE LAYOUT
___WATER LINE LAYOUT	___SWIMMING POOL

This is to Certify that the Riverside County Health Department Approves for Occupancy, Construction or Installation the Item(s) Checked Above.

Date 1-26-59 By Wm. Hawkins

RIVERSIDE COUNTY, CALIF.
APPROVED:

3-2-59 DATE — Paul L. Stout

BENCH MARK
Riverside County BM No 7 - Chiseled "X" on Step of Church NW Cor Hole Ave & Jones Ave
Elev. 703.93

★=As built G.S. 4.13.64.

PLAN | SURVEYED. | PLOTTED. | NOTE BOOK | BOUNDARY & CONTROL CHECKED. | NO. | R/W & EASEMENT CHECKED. | RT. OF WAY CHECKED. | BY | DATE

PROFILE | SURVEYED. | PLOTTED. | NOTE BOOK | GRADES CHECKED. | NO. | B. M.'s NOTED. | STRUCTURE NOTATIONS CHECKED. | BY | DATE

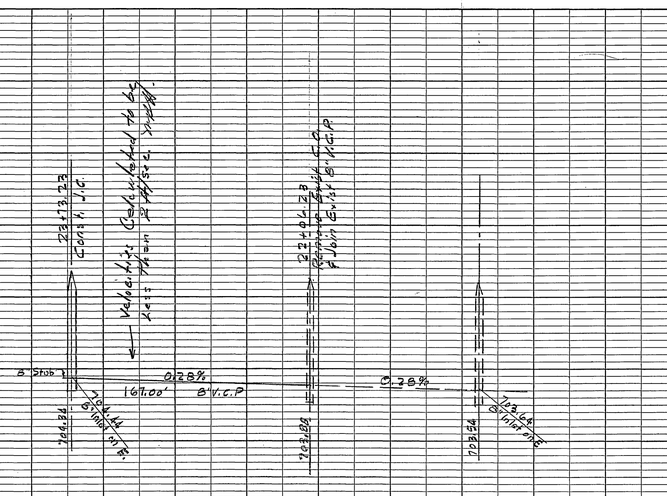

PROFILE
SCALE VERT 1"=5'
HORIZ 1"=50'

PROPERTY OF COUNTY OF RIVERSIDE
Office of the Road Commissioner

REVISION:
3-18-59 - CHANGE STREET NAME FROM BUTLER TO CODDEN AVENUE

SEWER PLANS
FOR
LA SIERRA PARK No. 3
POLK STREET

H.R. LOVETT & ASSOCIATES, INC.
4921 DURFEE AVE.
PICO RIVERA, CALIF.
R.E. 10610

1-6-59

SHEET 1 OF 2

S-487

PLATE 1 - PLAN - PROFILE O.P.R. & R.E. STANDARD
KEUFFEL & ESSER CO., NEW YORK.
K & E CO. NO. 345-1 MADE IN U.S.A. 21408

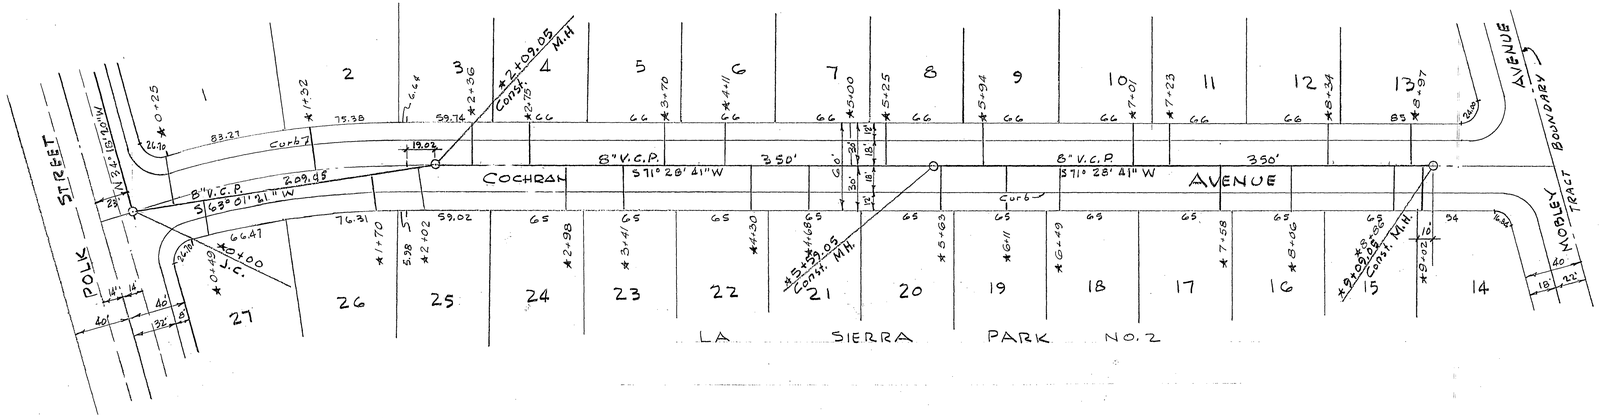

COCHRAN AVENUE

PLAN
SCALE 1"=50'

★ = As built G.S. 4.13.64.

RIVERSIDE COUNTY HEALTH DEPARTMENT

___FOOD ESTABLISHMENT	___SEWAGE DISPOSAL
___TRAILER PARK	___GAL SEPTIC TANK
___MOTEL, APT., HOTEL	___SQ. FT. OF LEACH LINE
___DWELLING	___X___SEEPAGE PIT
___COMMERCIAL BUILDING	___CONNECTION TO SEWER
___WATER SOURCE	X SEWER LINE LAYOUT
___WATER LINE LAYOUT	___SWIMMING POOL

This is to Certify that the Riverside County Health Department Approves for Occupancy, Construction or Installation the Item(s) Checked Above.

Date 1-26-59 By [signature]

BENCH MARK -
Riverside County B.M. No. 7
Chiseled "X" on step of Church
NW Corner Hole Ave. & Jones Ave.
Elev. 703.93

PLAN
SURVEYED
PLOTTED
GRADES CHECKED
AS BUILT CHECKED
NOTE BOOK
NO.
RT. OF WAY CHECKED
STRUCTURE NOTATNS CHKD
BY
DATE

PROFILE
SURVEYED
PLOTTED
GRADES CHECKED
AS BUILT CHECKED
NOTE BOOK
NO.
STRUCTURE NOTATNS CHKD
BY
DATE

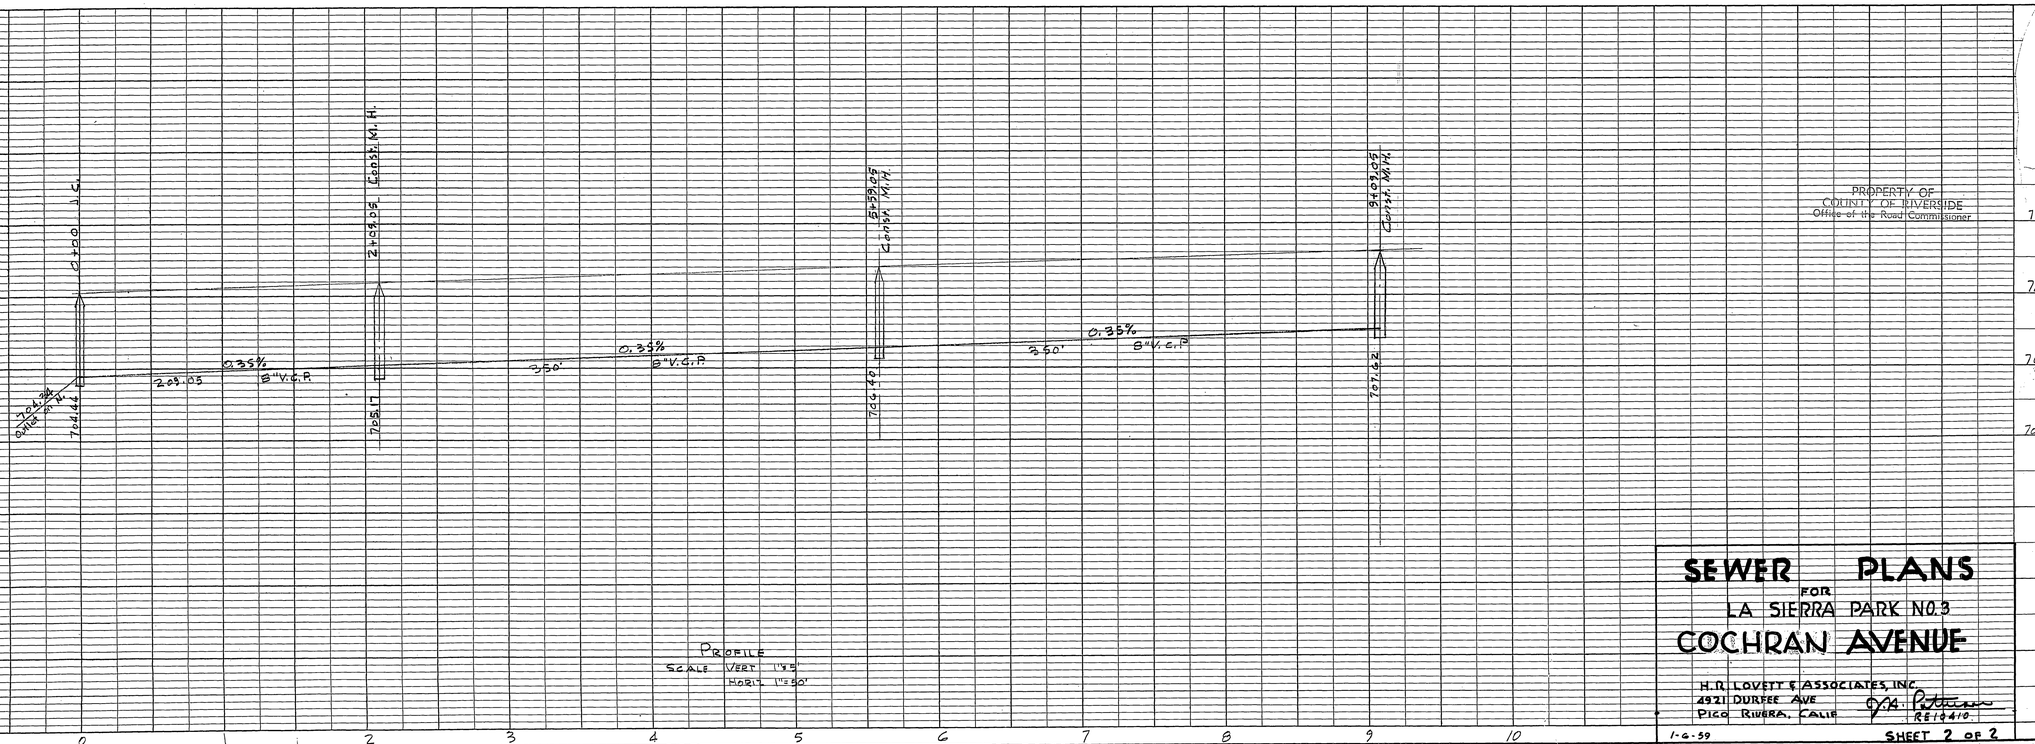

PROFILE
SCALE VERT. 1"=5'
HORIZ. 1"=50'

PROPERTY OF
COUNTY OF RIVERSIDE
Office of the Road Commissioner

SEWER PLANS
FOR
LA SIERRA PARK NO. 3
COCHRAN AVENUE

H. R. LOVETT & ASSOCIATES, INC.
4921 DURFEE AVE
PICO RIVERA, CALIF.
RE 18410

1-6-59

SHEET 2 OF 2

S-487

PLATE 1 - PLAN - PROFILE O.P.R. & R.E. STANDARD
KEUFFEL & ESSER CO., NEW YORK.
K & E CO. NO. 345-1 MADE IN U.S.A. 21408