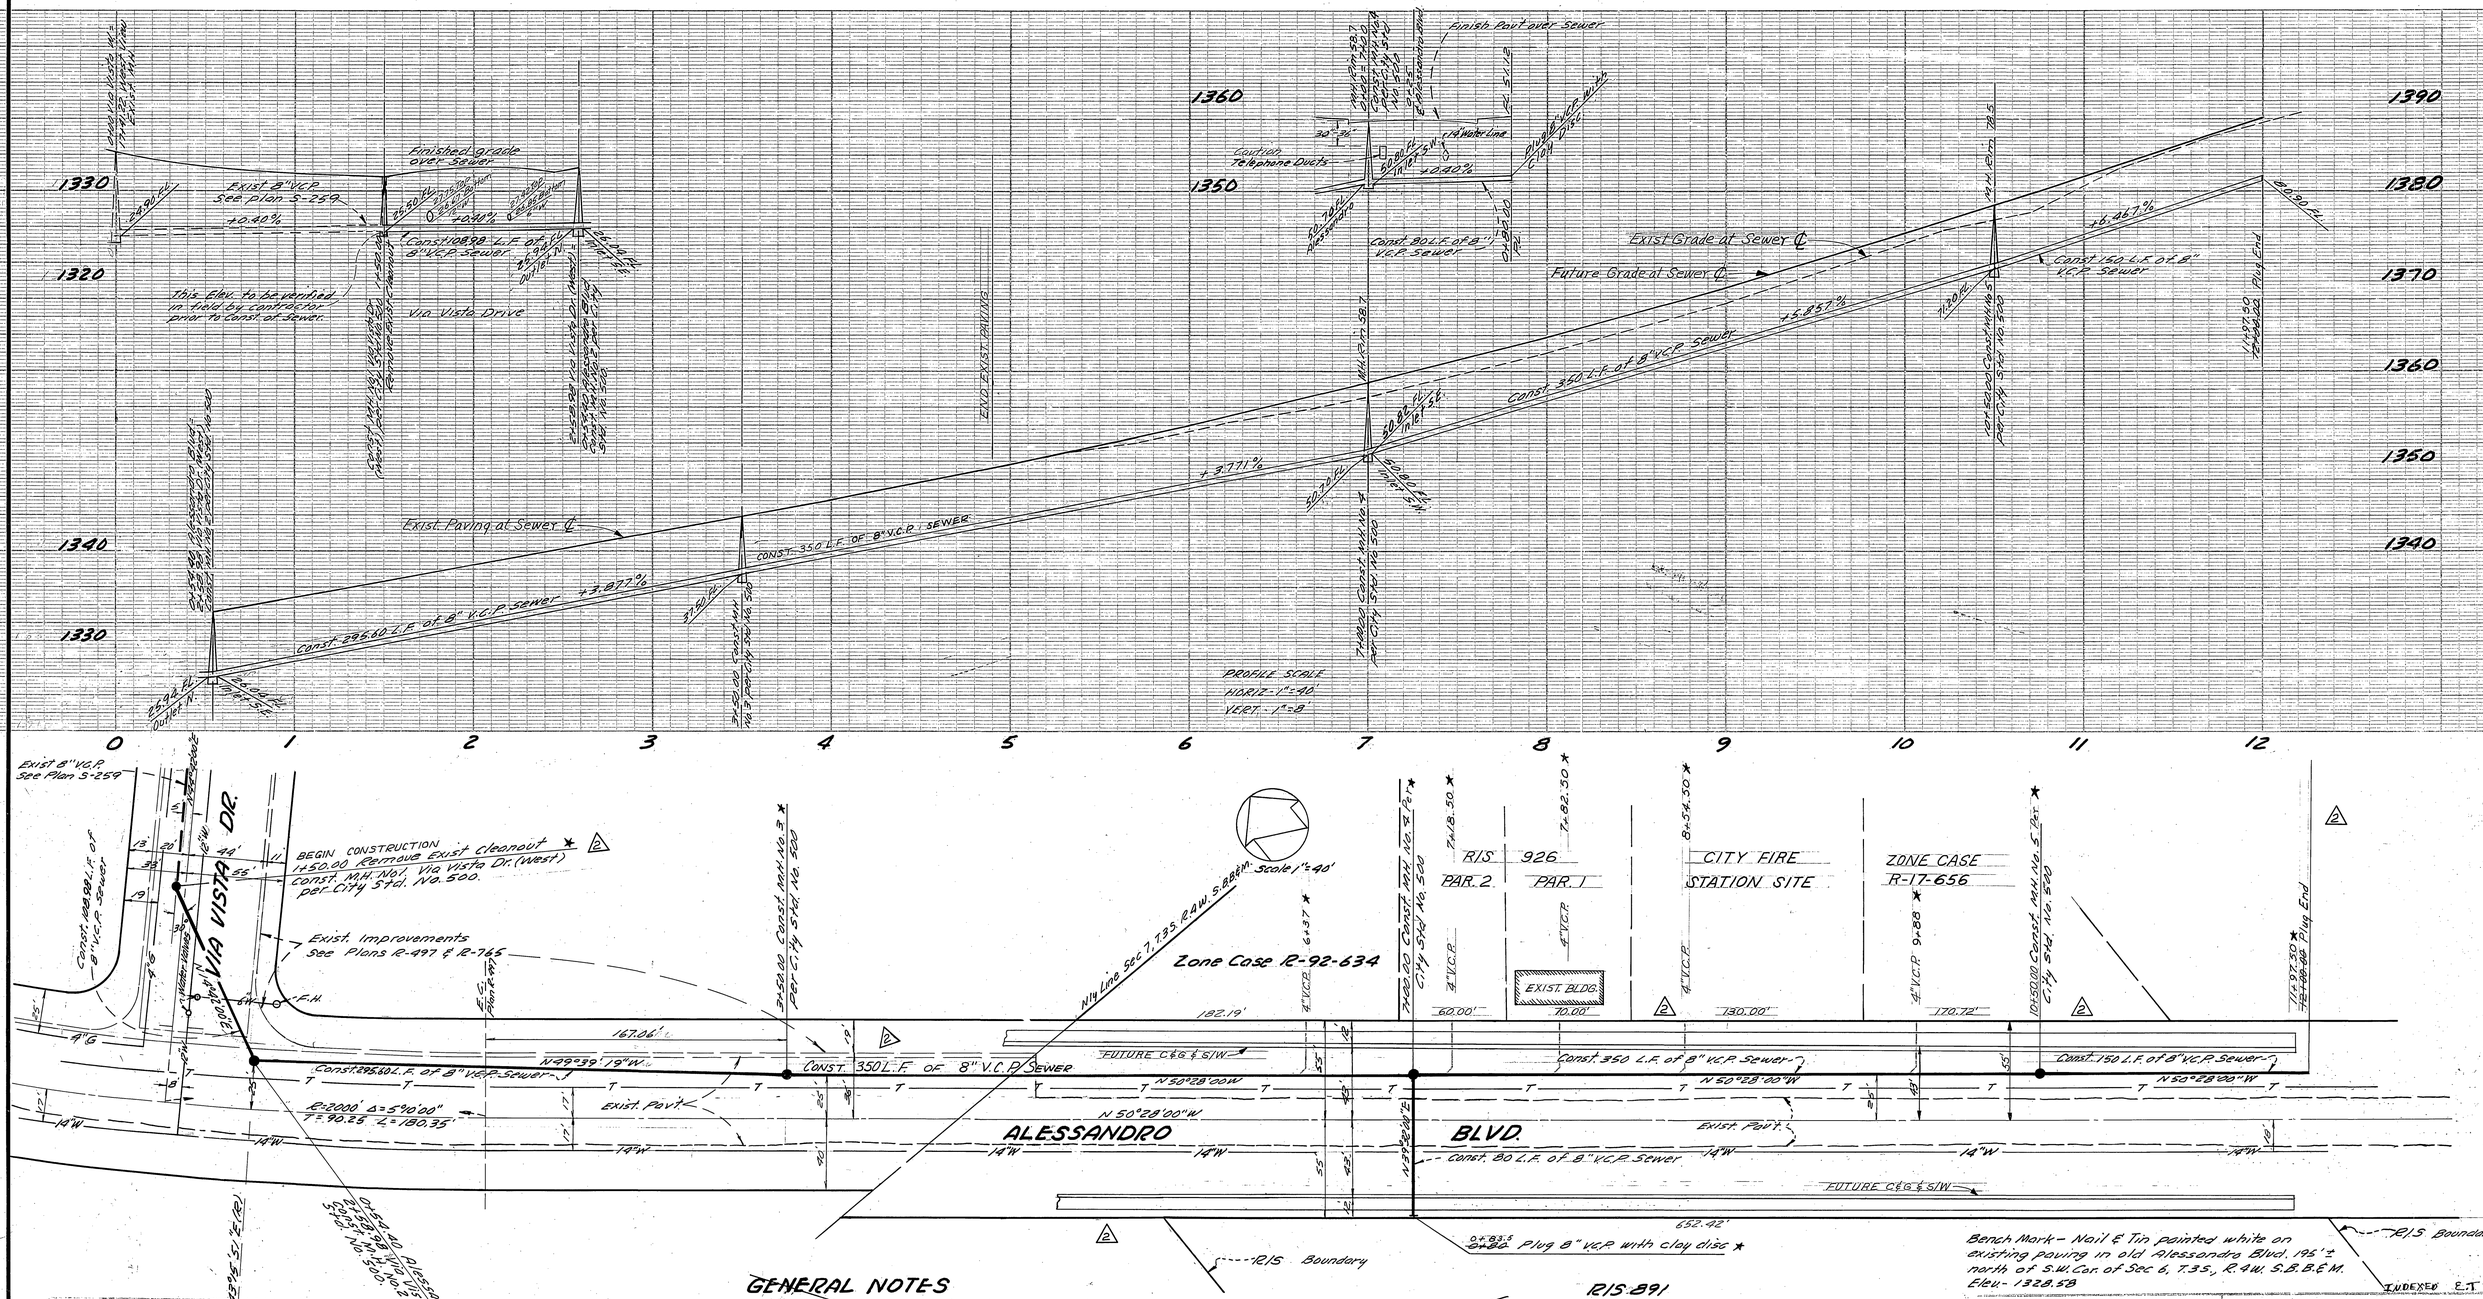

GENERAL NOTES

1. Construction shall be in accordance with the City of Riverside, Department of Public Works, Standard Specifications No. 461 and Standard Drawings.
2. It shall be the responsibility of the contractor to clear the right of way in accordance with the provisions of the law as it affects each utility including irrigation lines and appurtenances and at no cost to the City.
3. Joints in vitrified clay pipe sewers shall conform to A.S.T.M. Standard C-425-607, or the latest revision thereof.
4. Pipe shall be bedded per Case II, Standard Drawing No. 452, unless otherwise specified on plan.
5. Location of wyes and laterals to be determined in the field.
6. All stubs and laterals to be constructed in accordance with standard Drawing No. 562. Stubs shall be plugged and capped.

Bench Mark – Nail & Tin painted white on existing paving in old Alessandro Blvd. 195'± north of S.W. Cor. of Sec 6, T.3S., R.4W. S.B.B.&M. Elev. – 1328.58

INDEXED E.T.

—CAUTION—
PACIFIC TELEPHONE
CABLES UNDERGROUND
BEFORE EXCAVATING
CALL COLLECT:

	7:30 A.M. to 5 P.M.	After Hours & Holidays
Orange County	714-633-0811	714-547-6606
Riverside County	714-684-0071	714-547-6606
Inyo County	714-684-0071	714-547-6606
San Bernardino County	714-684-0071	714-547-6606
Los Angeles County	213-621-3111	24 HOUR SERVICE
Ventura County	213-621-3111	
San Diego County	714-298-0595	714-232-0027

FOR FREE CABLE LOCATING SERVICE

CRAWLEY & HAWKINS
ENGINEERS & SURVEYORS
RIVERSIDE, CALIFORNIA
Approved George O. Crawley R.C.E. 6911 Date 9-1-66
RE. NO. 9455
10.160

REVISIONS		
MARK	DATE	DESCRIPTION
1	9-21-65	SHOWN CONST. BY CITY OF RIVERSIDE Ref. W.O. 7175
2	4-20-66	LIMITS OF CITY CONTRACT CHANGED. LATERALS ADDED. REVISED PAVT. & PROP. LINES. AS BUILT

CITY OF RIVERSIDE, CALIFORNIA
DEPARTMENT OF PUBLIC WORKS
R-92-634 & R15 891
SEWER PLAN & PROFILE
Alessandro Blvd – Via Vista Dr. to 1200' E'ly
Via Vista Drive – Alessandro Blvd. To 150 N'ly
Scale: 1"=40' Horiz; 1"=8' Vert.

DESIGNED E.T. | DRAWN B.C. | CHECKED | TRACED | TRAFFIC Div. | APPROVED BY William D. Gardner, DIRECTOR OF PUBLIC WORKS | 5076
PUBLIC UTILITIES | RECOMMENDED BY | DATE 4-19-65 | S-574 | 1 | 1