PROPERTY OF
CITY OF RIVERSIDE
DEPT OF PUBLIC WORKS
ENGINEERING DIVISION

K+E STANDARD © PROFILE PLATE A 4X20
PRINTED IN U.S.A. ON IMPERIAL TRACING CLOTH

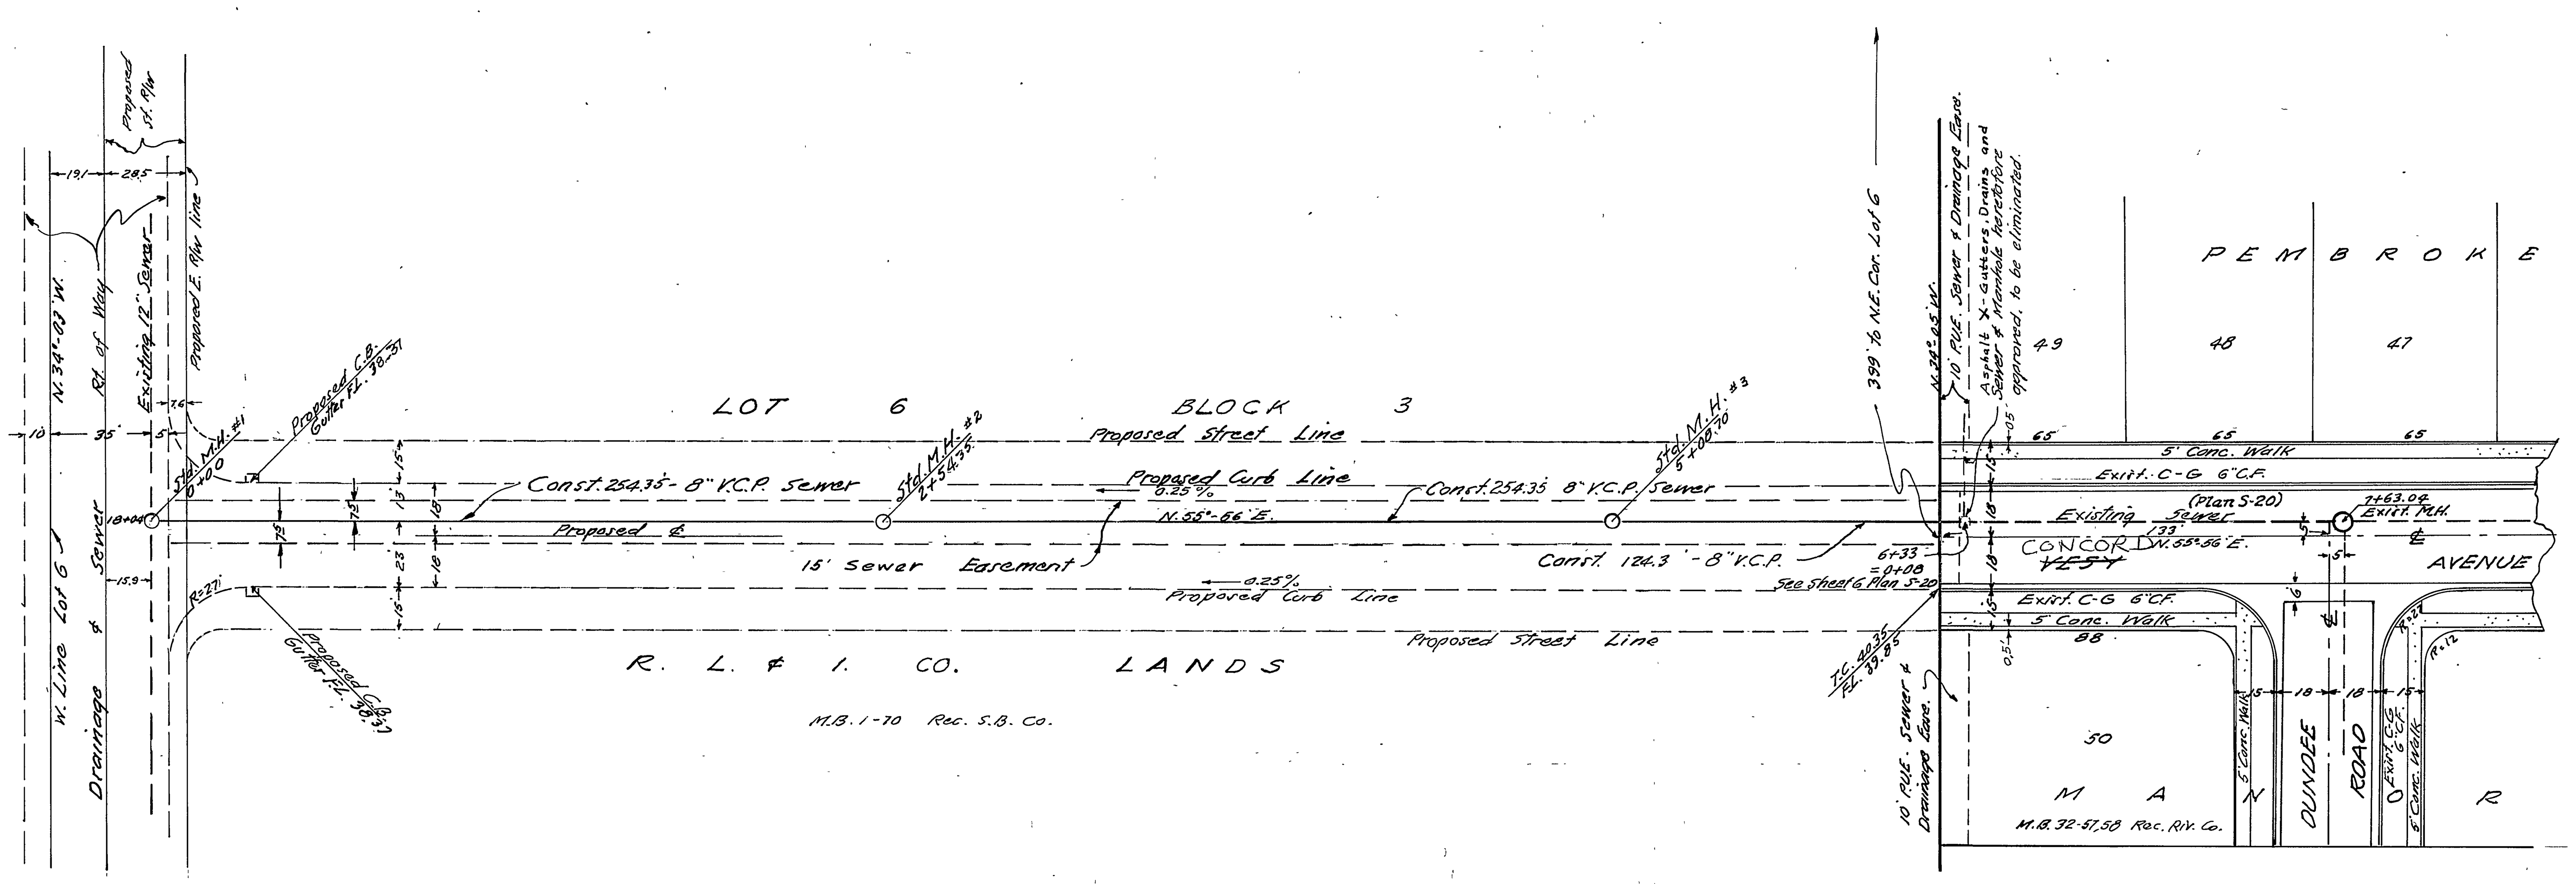

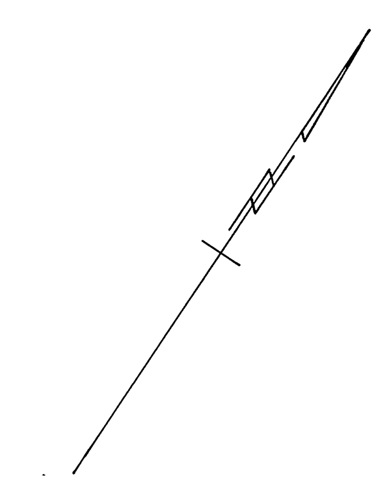

J. F. DAVIDSON - CIVIL ENGINEER
R.E. No 862
RIVERSIDE, CALIFORNIA
APPROVED BY L. S. Whidden DATE 4-10-57

CITY OF RIVERSIDE, CALIFORNIA
DEPARTMENT OF PUBLIC WORKS

SEWER PLAN & PROFILE
EASEMENT
WESTERLY FROM VESY AVENUE
PEMBROKE MANOR
HORIZ. SCALE 1 IN. = 40 FT. VERT. SCALE 1 IN. = 4 FT.

APPROVED BY
J. Martinez
Director of Public Works
DATE 4/30/57

NO. S-82
SHEET 1 OF 1