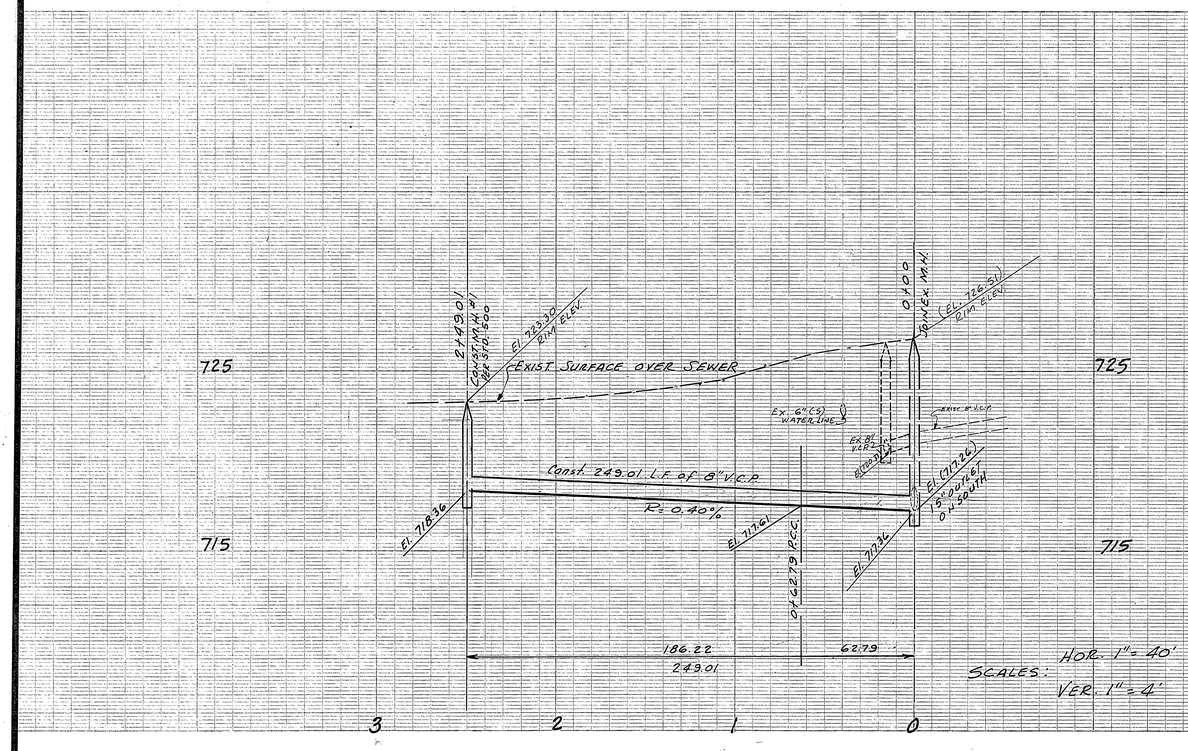

SCALES: HOR. 1" = 40'
VER. 1" = 4'

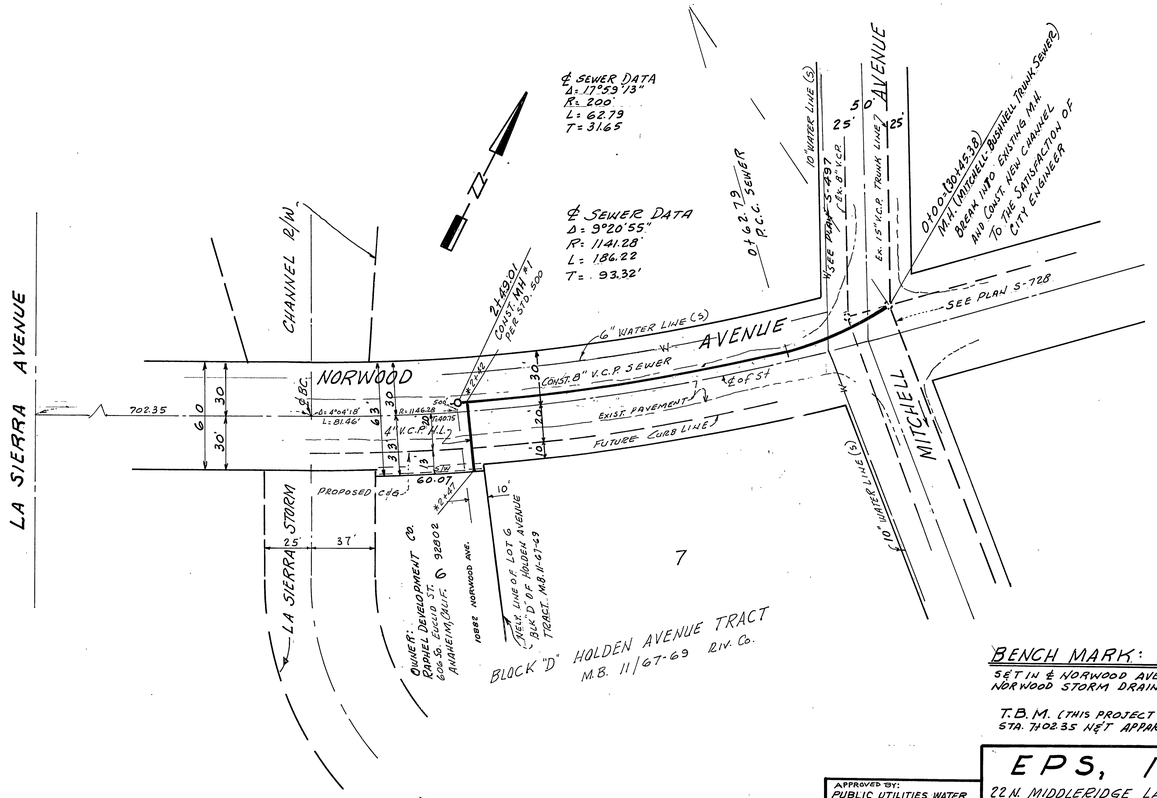

GENERAL NOTES

1. IT SHALL BE THE RESPONSIBILITY OF THE CONTRACTOR TO CLEAR THE RIGHT OF WAY IN ACCORDANCE WITH THE PROVISIONS OF LAW, AS IT AFFECTS EACH UTILITY INCLUDING IRRIGATION LINES AND APPURTENANCES, AND AT NO COST TO THE CITY.
2. CONSTRUCTION SHALL BE ACCORDANCE WITH THE CITY OF RIVERSIDE, DEPARTMENT OF PUBLIC WORKS, STANDARD DRAWINGS AND THE STANDARD SPECIFICATIONS, FOR PUBLIC WORKS CONSTRUCTION, 1973 EDITION.
3. LOCATION OF LATERAL TO BE DETERMINED IN THE FIELD AT THE DIRECTION OF THE OWNER AVOID CONFLICT WITH PROPOSED AND / OR EXISTING FACILITIES.
4. CONTRACTOR TO VERIFY EXISTING SEWER ELEVATION PRIOR TO CONSTRUCTION.
5. ALL LATERALS EXTENDING NORTH BETWEEN STA. 1+50 AND STA. 2+50 SHALL BE ENCASED 4½' EACH SIDE OF WATER MAIN.

BENCH MARK: (THIS PROJECT ONLY)
SET IN ℄ NORWOOD AVE. AT STA. 6100 PER NORWOOD STORM DRAIN PROFILES JUNE 23 1972
ELEV. 723.53

T.B.M. (THIS PROJECT ONLY) ON NORWOOD AVE AT STA. 702.35 NET APPARENT ℄ R.C.F.C.D. CHANNEL
ELEV. 728.82

APPROVED BY: PUBLIC UTILITIES, WATER
H.R. Creamer 7-12-74

EPS, INC.
22 N. MIDDLERIDGE LANE, ROLLING HILLS
CALIFORNIA, 90274, (213) 377-2824
APPROVED BY:
George C. Bach 12-73
GEORGE C. BACH JR. RCE No. 11092 DATE

MARK	REVISIONS	APPR.	DATE

DESIGNED BY ____ DRAWN BY ____ CHECKED BY ____

CITY OF RIVERSIDE, CALIFORNIA
DEPARTMENT OF PUBLIC WORKS

APPROVED BY	BY	DATE
OFFICE ENGINEER		
PARK DEPARTMENT		
TRAFFIC DIVISION		
ASSISTANT CITY ENG.		

APPROVED BY
William D. Gardner
DIRECTOR OF PUBLIC WORKS
DATE 4/17/75

*AS BUILT 12-75 KPT

SEWER PLAN AND PROFILE
NORWOOD AVENUE
FROM MITCHELL AVENUE
TO 249 FT. WEST / MITCHELL AVENUE
BUILDING PERMIT @ 10882 NORWOOD AVE.

PROJECT NO. S-998
SHEET 1 OF 1
HORIZ. SCALE: 1" = 40' VERT. SCALE: 1" = 4'
FILE NO.