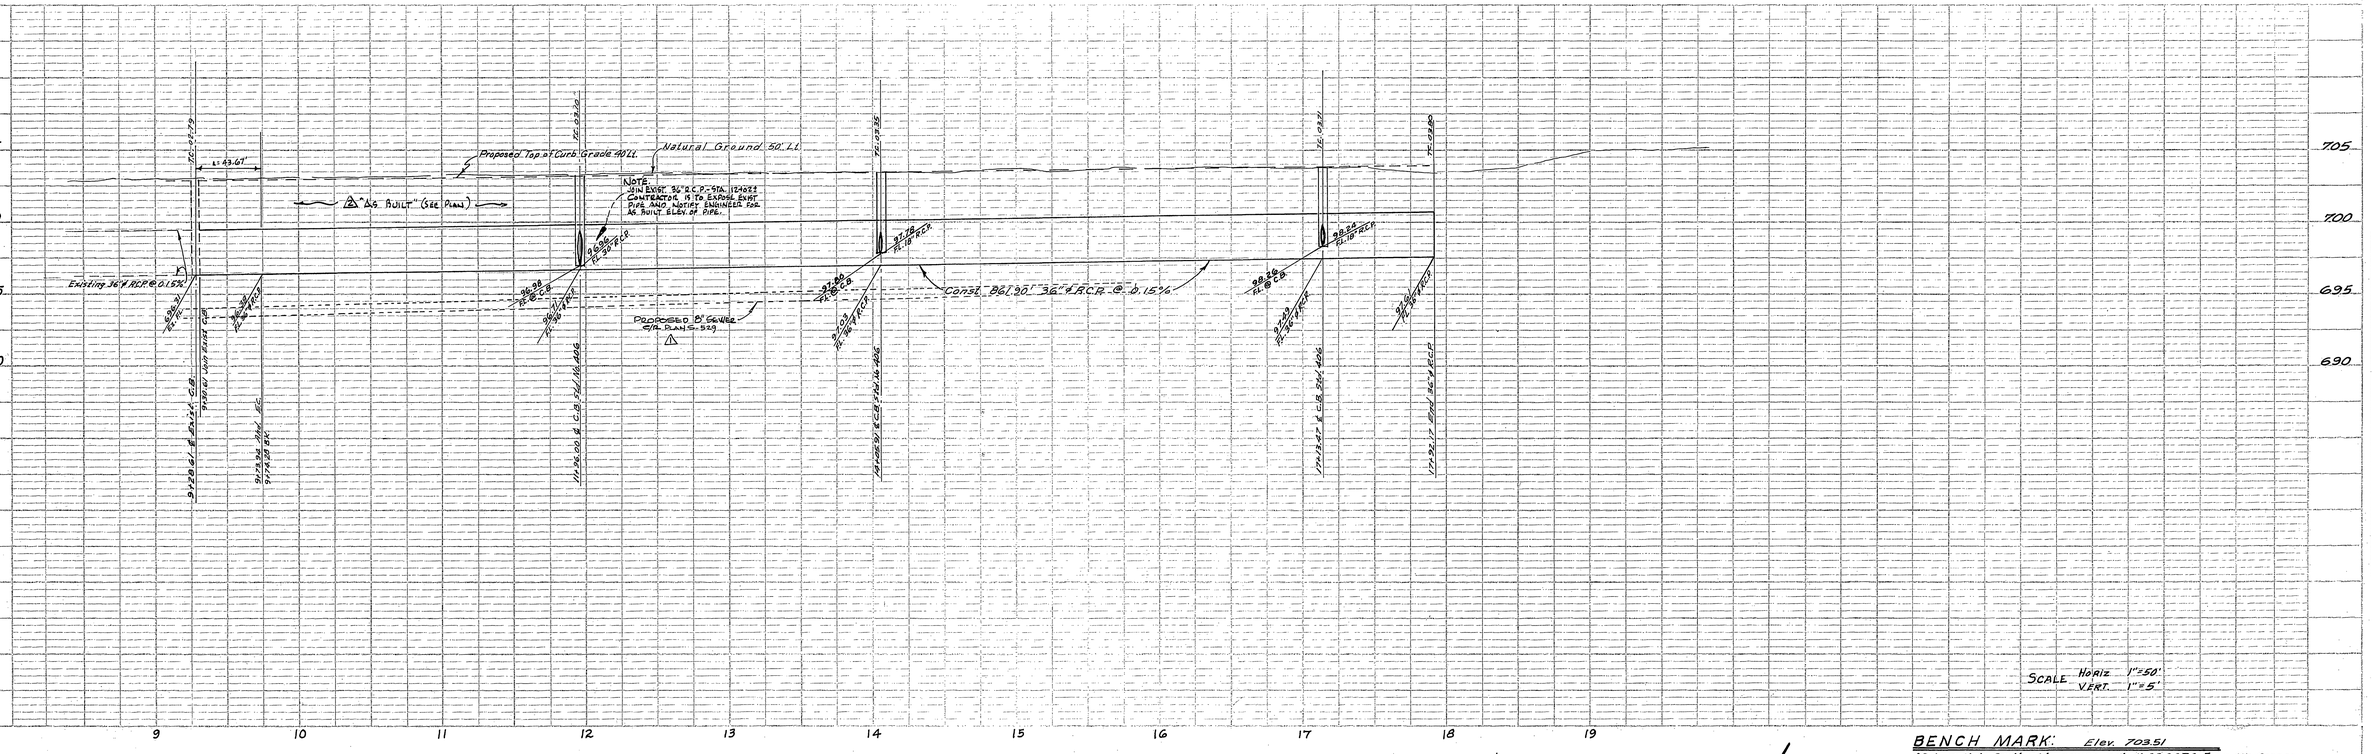

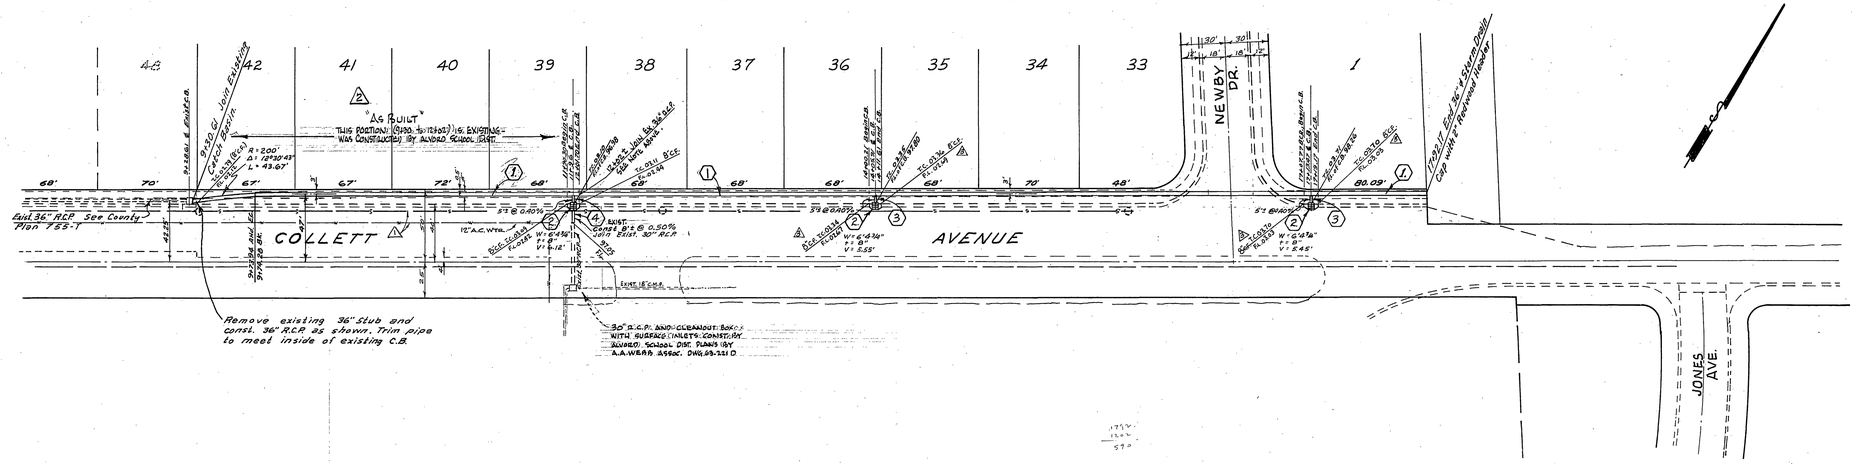

BENCH MARK: Elev. 703.51

40d nail in South side power pole # 320674-E on NW Corner Collett and La Sierra (Taken from Co. plan No. 728-2.)

GENERAL NOTES:

1. It shall be the responsibility of the contractor to clear the right of way in accordance with the provisions of law as it affects each utility including irrigation lines and appurtenances and at no cost to the City.
2. Construction shall be in accordance with the City of Riverside, Department of Public Works, Specifications No. 461 and Standard Drawings.
3. NOTICE TO CONTRACTOR: The existence and location of any underground utility pipes or structures shown on these plans are obtained by a search of the available records. To the best of our knowledge, there are no existing utilities except as shown on these plans. The Contractor is required to take due precautionary measures to protect the utility lines shown and any other lines not of record or not shown on these plans.

QUANTITY ESTIMATE

As built 36" R.C.P. ~~Alternate - no joint pipe~~	862 L.F.
36"ø R.C.P. (Alternate - no joint pipe)	862 L.F.
Catch Basin Type 4 Standard No. 406 (with 2 grates) (8"C.F. / 9½" AT OPENING)	2 3 Ea.
18"ø R.C.P.	10 L.F.
30"ø R.C.P.	13 L.F.

CONSTRUCTION NOTES:

1. As built ~~Const.~~ 36"ø R.C.P. (~~Alternate - no joint pipe~~) 2000 D, Bedding Class II
2. Const. Catch Basin Type 4 Standard No. 406 (TO MEET 8"C.F. — 9½" EAGE AT OPENING)
3. Const. 18"ø R.C.P., 2000 D, Bedding Class II
4. Const. 30"ø R.C.P., 2000 D, Bedding Class II

SCALE HORIZ 1"=50'
VERT. 1"=5'

PROFILE — SURVEYED — PLOTTED — DESIGNED — DRAWN — CHECKED — QUANTITIES — STRUCTURE DETAILS — CHECKED — WORK BOOK — NO. — BY — DATE

ALBERT A. WEBB ASSOCIATES
CIVIL ENGINEERS - RIVERSIDE, CALIFORNIA
APPROVED [signature] DATE 3/6/64
R.E. 9076

REVISION			CITY OF RIVERSIDE, CALIFORNIA
MARK	DATE	DESCRIPTION	DEPARTMENT OF PUBLIC WORKS
1	10-29-64	ADDED 12" WATER LINE, ENID. AND SEWERS. Bob S. [signature] AKD	STORM DRAIN PLAN & PROFILE
2	3-19-65	REVISED TO SHOW SCHOOL EXTENSION "AS BUILT" & VARIATION NOTE - ENID. Bob S. [signature] AKD	COLLETT AVENUE TRACT No. 2551
3	3-31-65	ADDED 8"C.F. @ CATCH BASIN & ENID. Bob S. [signature] AKD	

DATE Mar. 1964	SCALE 1" = 50'	APPROVED BY [signature] DIRECTOR OF PUBLIC WORKS	NO. D-111
DRAWN B.E.L.	W.O. 62-229		
CHECKED [signature] AKD	F.B. 495	DATE 9-2-64	SHEET 1 OF 1

DWG. No. 62-229-D