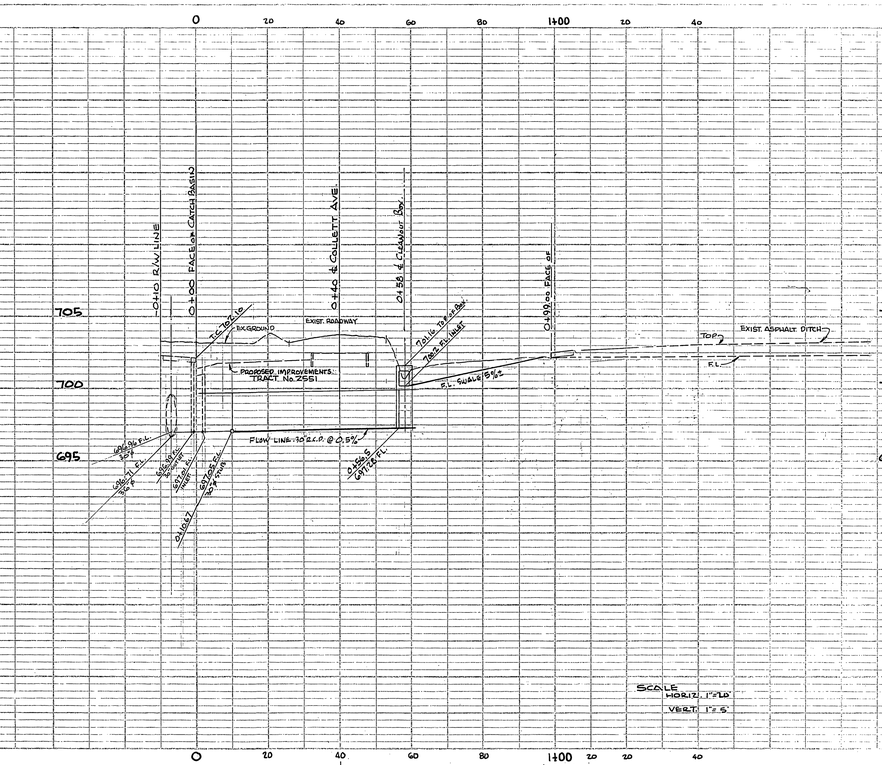

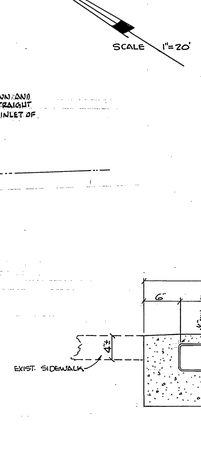

SECTION "B-B"
1" = 1'-0"

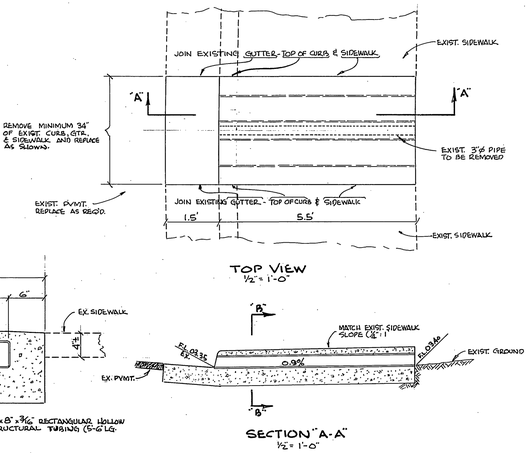

TOP VIEW
½" = 1'-0"

SECTION "A-A"
½" = 1'-0"

REVISIONS	DATE	BY
ADDED TITLE BLOCK / DELETED STD. 606 CATCH BASIN & 48" of 32 R.C.P. - ADDED STD. 425 & SWALE	1-28-65	dw

COLLETT AVENUE SCHOOL

30" R.C.P. STORM DRAIN AND SIDEWALK OUTLETS

SCALE	NOTED	JOB NO.	63.221
DESIGN		SHEET NO.	1
DRAWN	dw	OF SHEETS	1 SHEETS
TRACED			
CHECKED			
495		DWG. NO.	63.221 D

ALBERT A. WEBB ASSOCIATES
CIVIL ENGINEERS
R.E. 9876

PROFILE
NOTE BOOK NO. ____
SURVEYED
PLOTTED
DESIGNED
CHECKED
QUANTITIES
STRUCTURE INITIALS CHK'D.
BY
DATE

D-131