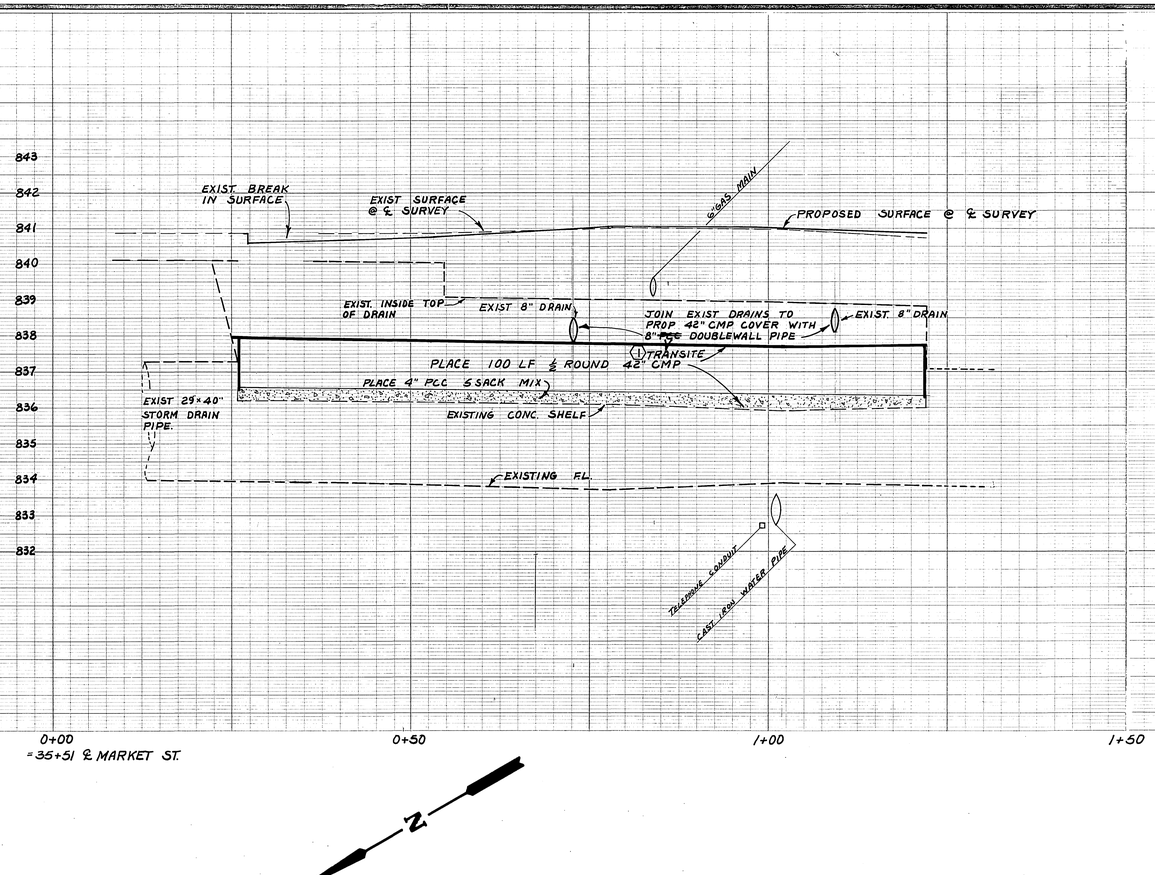

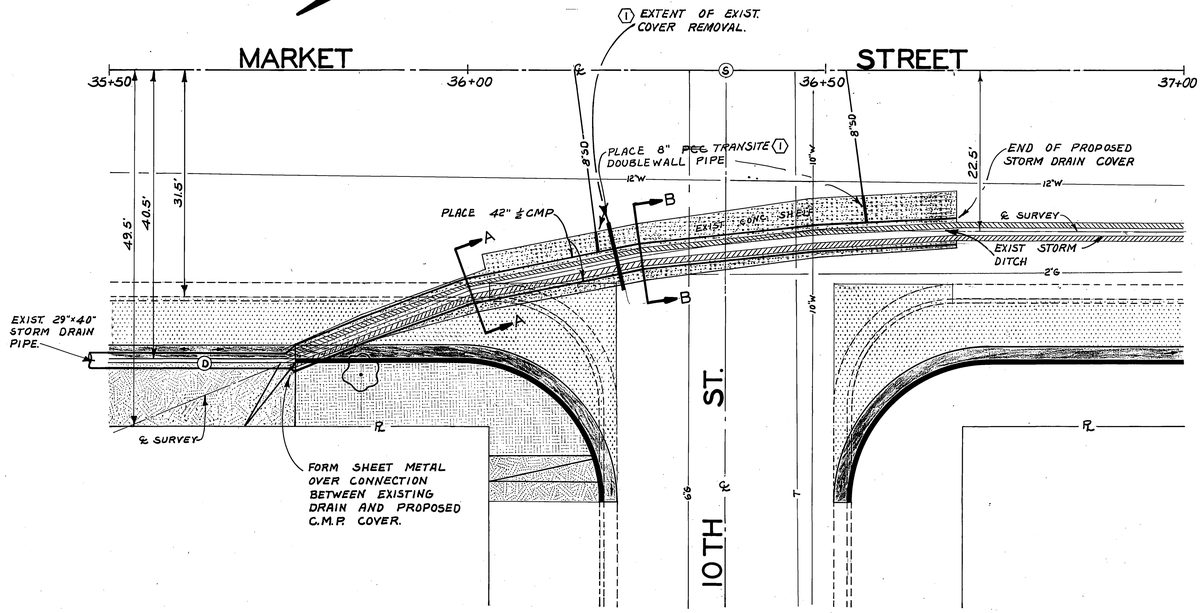

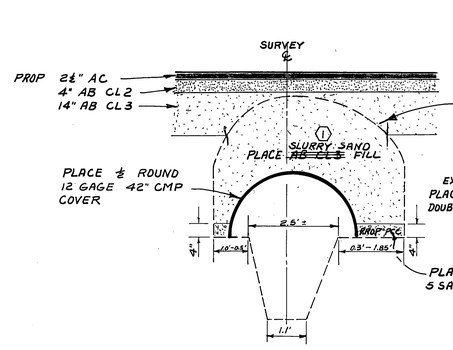

SECTION A—A

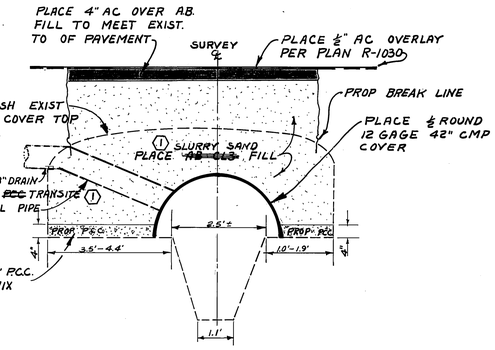

SECTION B—B

SCALE 1" = 2'

ESTIMATED QUANTITIES

1.	EXCAVATION	50 C.Y.
2.	½ ROUND 42" CMP	100 L.F.
3.	PCC	6 C.Y.
4.	AB CLASS 3	90 C.Y.
5.	8" PCC DOUBLE WALL PIPE	8 L.F.
6.	A.C.	12 TONS

NOTE: PAYMENT FOR THIS CHANGE ORDER INCLUDES ALL CONSTRUCTION BELOW LIMITS OF ORIGINAL DESIGN AS SHOWN ON CITY OF RIVERSIDE PLAN R-1030, SHEETS 2 AND 5.

FOR STREET CONSTRUCTION SEE PLAN R-1030

MARK	REVISIONS	APPR.	DATE
1	AS BUILT BE		6-27-66

DESIGNED BY GHK DRAWN BY BE CHECKED BY GHK

CITY OF RIVERSIDE, CALIFORNIA
DEPARTMENT OF PUBLIC WORKS

	BY	DATE
APPROVED BY OFFICE ENGINEER	GHK	2-15-66
PARK DEPARTMENT		
TRAFFIC DIVISION		
ASSISTANT CITY ENG.	GHK	7-6

APPROVED BY
DIRECTOR OF PUBLIC WORKS
DATE 2-17-66

MARKET STREET WIDENING

COVER FOR EXISTING STORM DRAIN AT 10TH STREET. CHANGE ORDER Nº 2

PROJECT NO. 3089

D-139

SHEET 1 OF 1

HORIZ. SCALE: 1" = 10' VERT. SCALE: 1" = 2'

FILE NO.