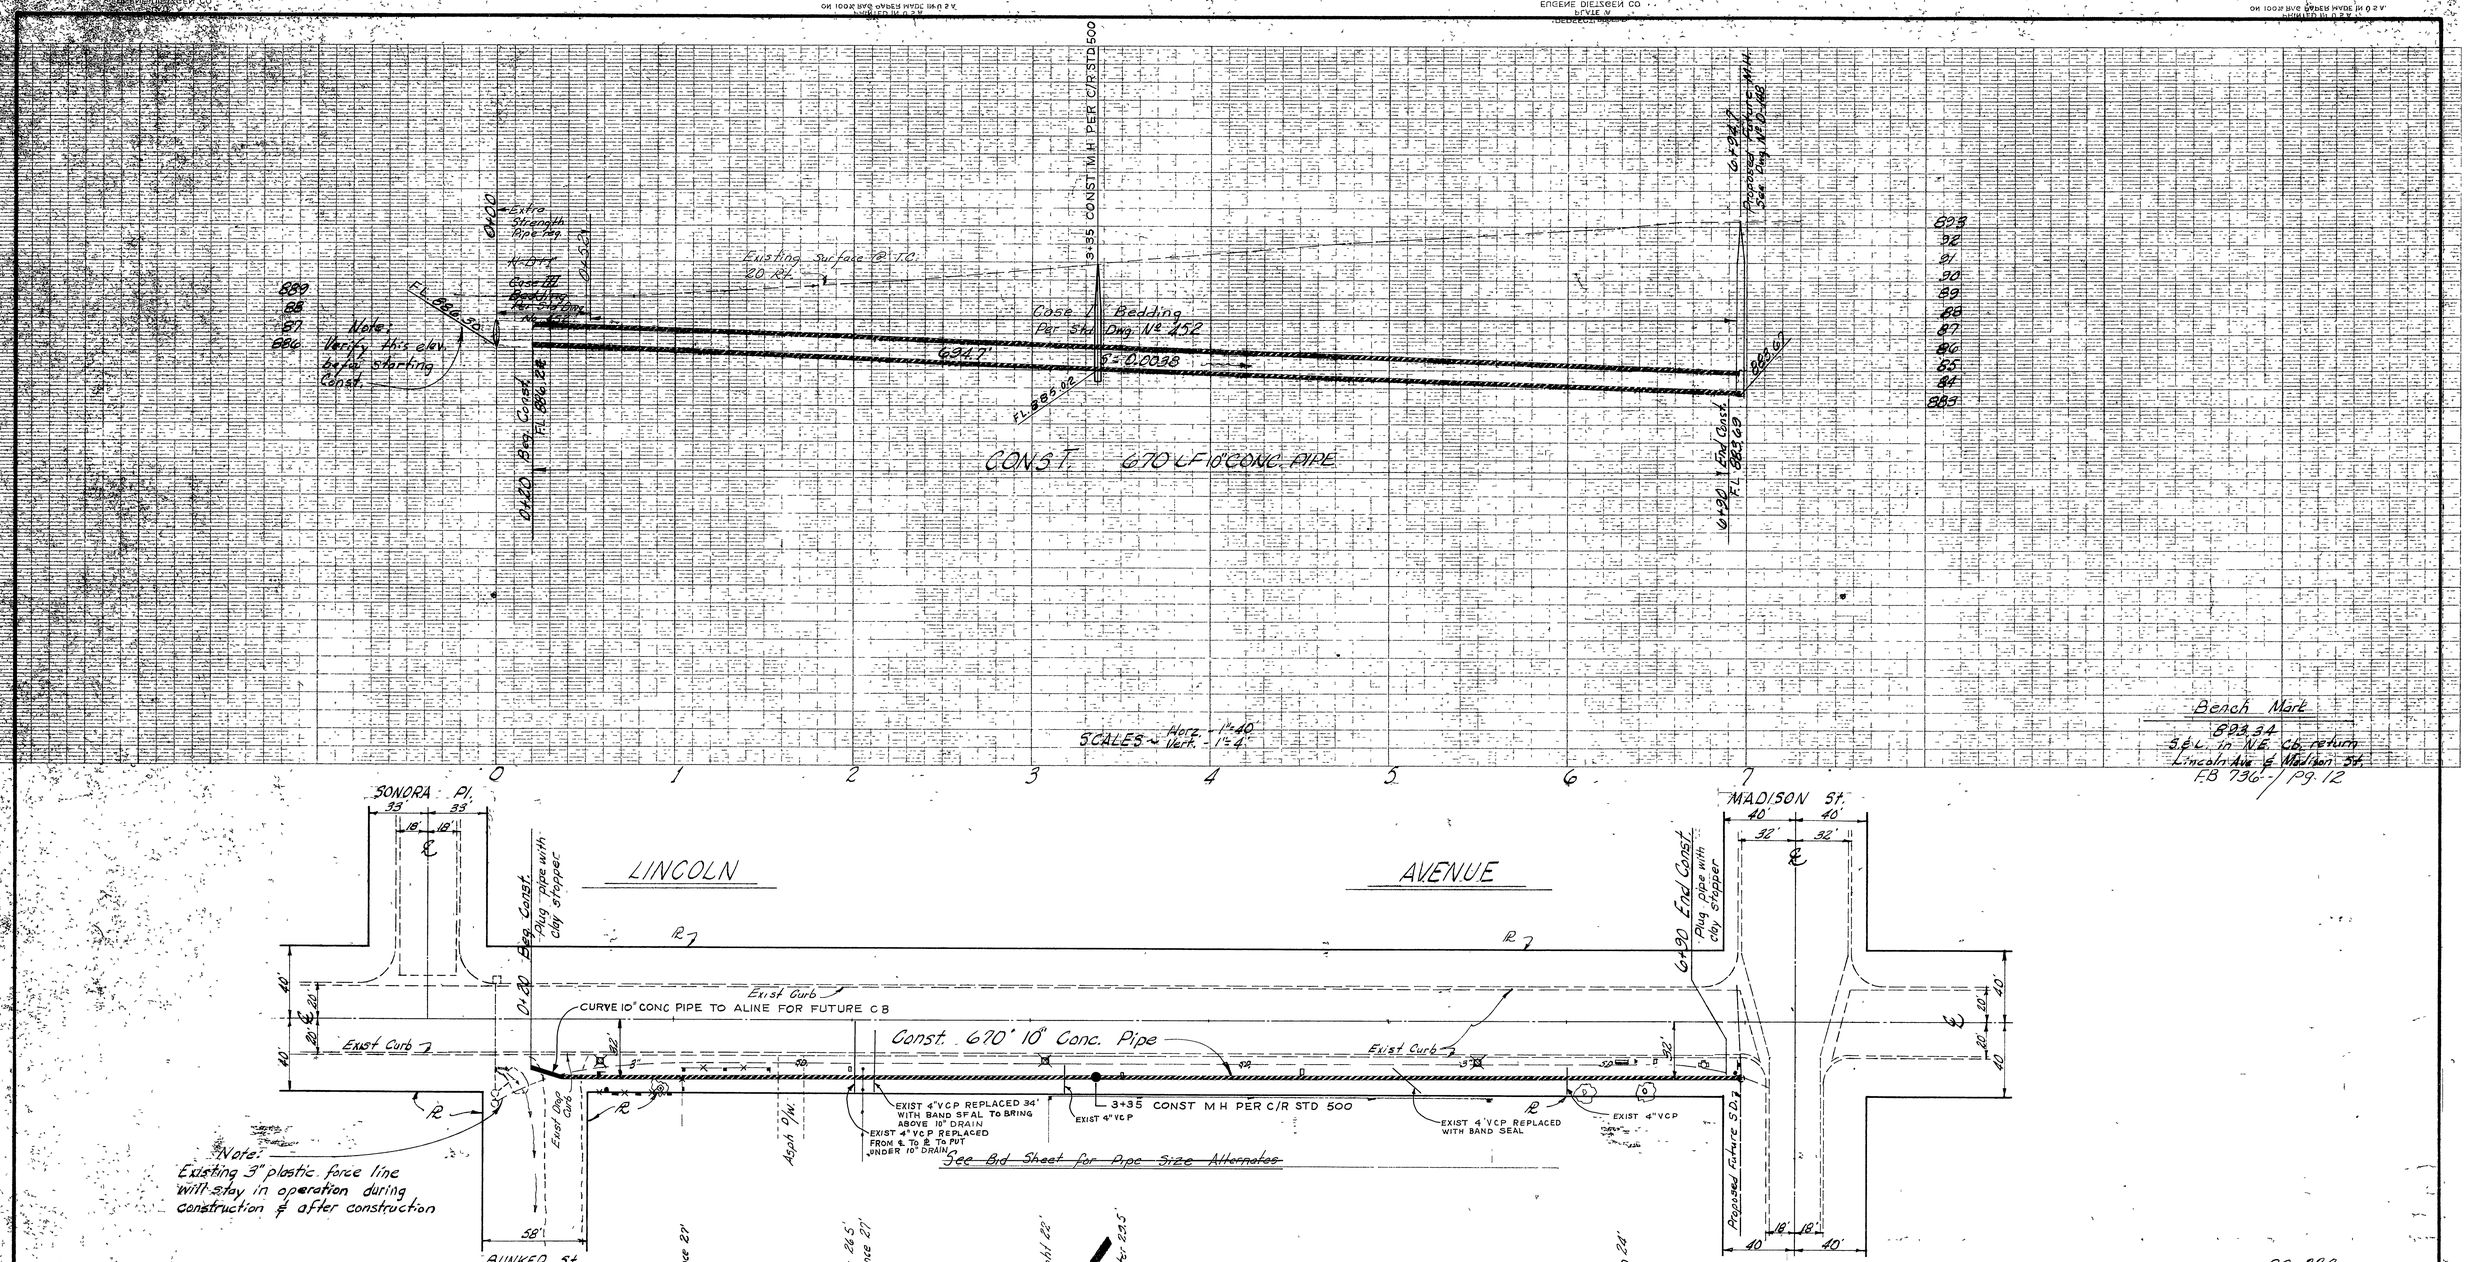

SS-323

REVISIONS		
MARK	DATE	DESCRIPTION
*	2-6-68	AS BUILT.

CITY OF RIVERSIDE, CALIFORNIA
DEPARTMENT OF PUBLIC WORKS

STORM DRAIN
LINCOLN AVENUE
Bunker St. to Madison St.

DESIGNED BY Bob S.
DRAWN BY Bob S.
CHECKED BY Bob K
SUBMITTED BY
PARK DEPT
TRAFFIC DIV.
RECOMMENDED BY
ASSISTANT CITY ENGINEER
APPROVED BY
DIRECTOR OF PUBLIC WORKS
DATE
PROJ. NO. 3770
D-148-A
SHEET 1 OF 1