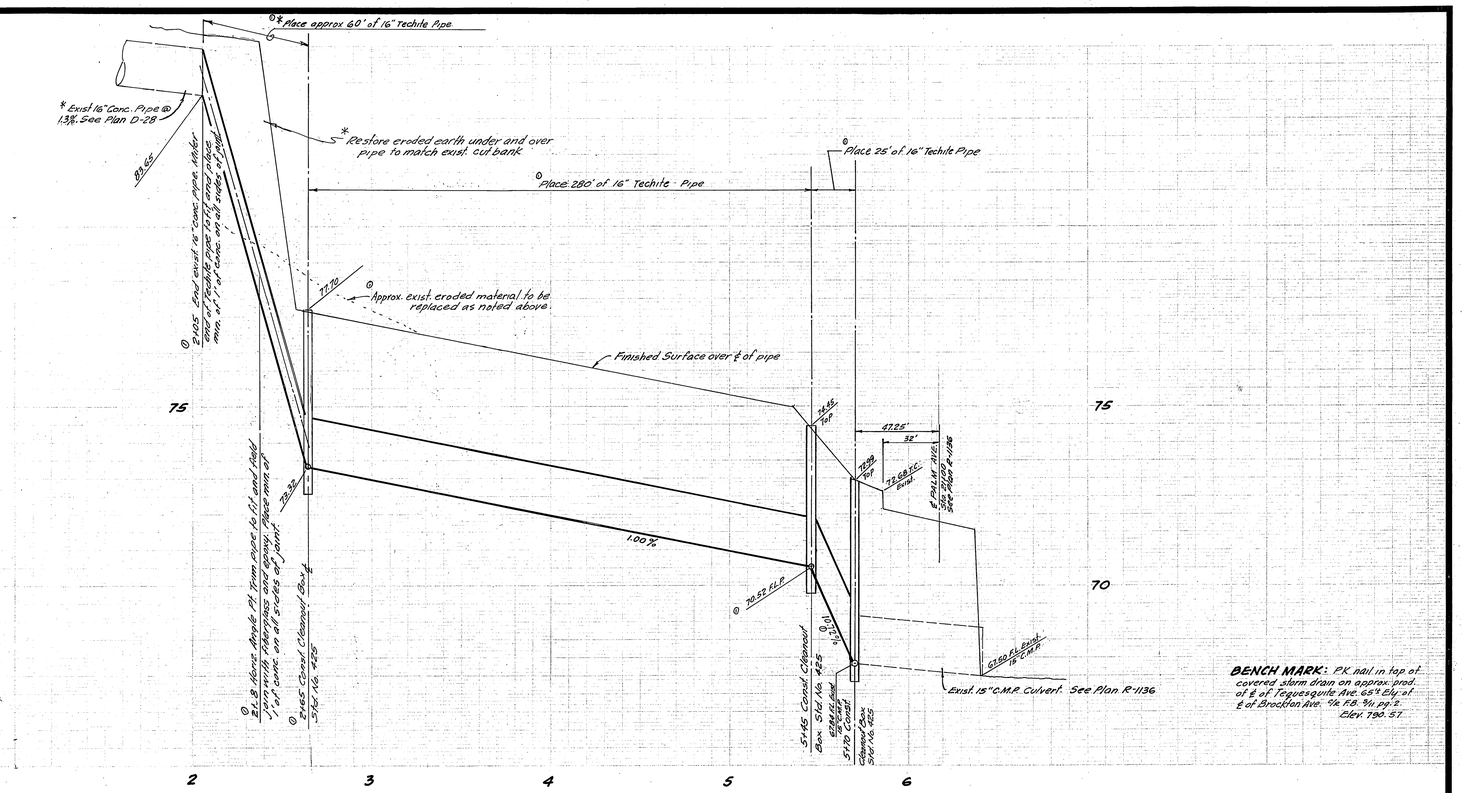

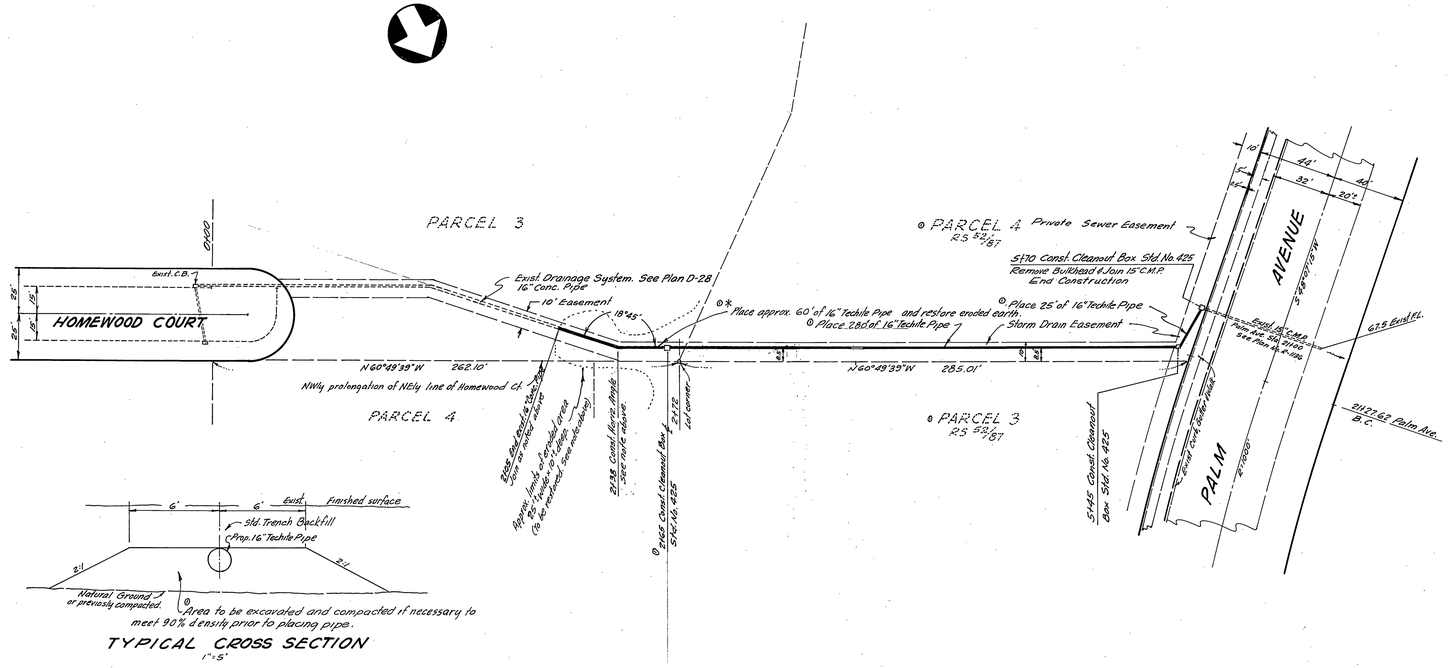

CRAWLEY, HAWKINS & HIEBER ENGINEERS & SURVEYORS RIVERSIDE, CALIFORNIA Approved George O. Crawley Date: 2-5-68 Reg. Civil Engr. No. 9455	* Added CMP to conform to exist. conditions. 71.46 ① Changed to Techite Pipe, rigid joints deleted 2-21-69. Revised grade 5170 to 5145. Gen. Quantity 10-1-69		CITY OF RIVERSIDE, CALIFORNIA DEPARTMENT OF PUBLIC WORKS
For: Riv. Conv. Hospital	MARK / REVISIONS / APPR. / DATE	DESIGNED BY G.C. DRAWN BY G.C. CHECKED BY MCG	APPROVED BY / BY / DATE OFFICE ENGINEER / 3-6 PARK DEPARTMENT TRAFFIC DIVISION ASSISTANT CITY ENG. / 3/6 APPROVED BY DIRECTOR OF PUBLIC WORKS DATE 3-5-68

STORM DRAIN PLAN & PROFILE From 331'± Westerly of HOMEWOOD COURT TO PALM AVENUE RECORD OF SURVEY 1015	PROJECT NO. D-160 SHEET 1 OF 1
HORIZ. SCALE: 1" = 40' VERT. SCALE: 1" = 2'	FILE NO. 4080