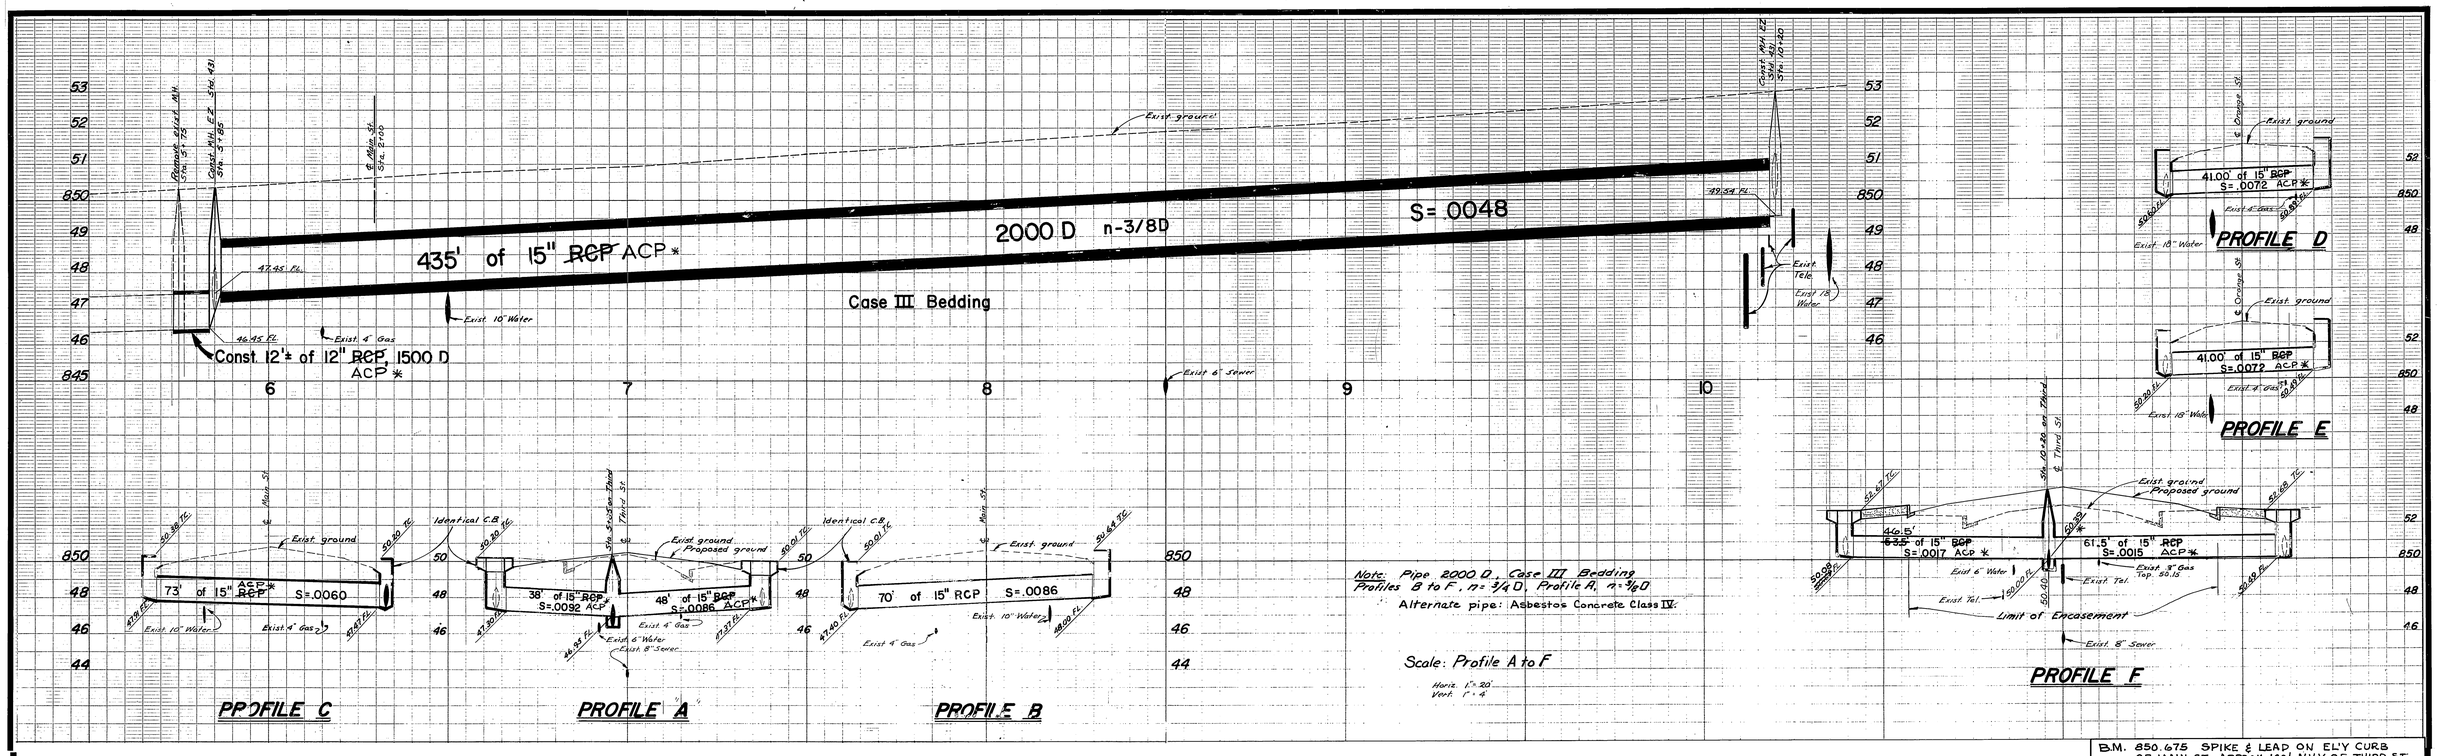

B.M. 850.675 SPIKE & LEAD ON EL'Y CURB OF MAIN ST. APPROX. 100' N'LY OF THIRD ST.
F.B. 845/53

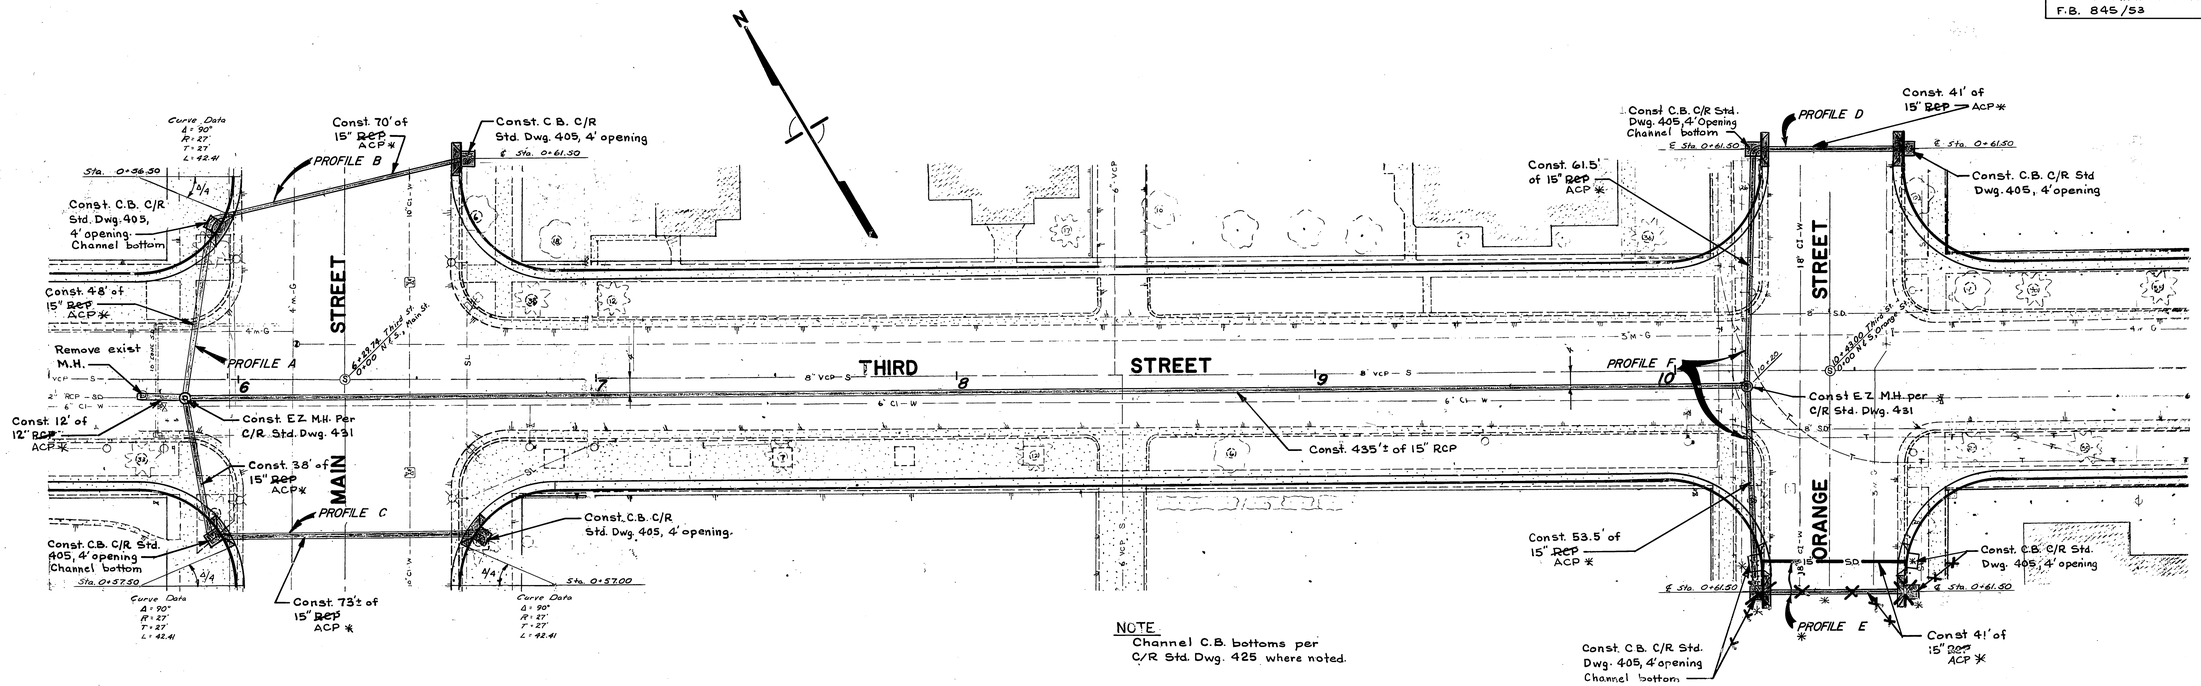

NOTE
Channel C.B. bottoms per C/R Std. Dwg. 425 where noted.

FOR STREET IMPROVEMENTS SEE DWG R-1257

* AS BUILT 1/12/71 DCK

MARK	REVISIONS	APPR.	DATE

DESIGNED BY J. Castro DRAWN BY R. Kihm CHECKED BY DCH

CITY OF RIVERSIDE, CALIFORNIA
DEPARTMENT OF PUBLIC WORKS

APPROVED BY	BY	DATE
OFFICE ENGINEER		5/70
PARK DEPARTMENT		
TRAFFIC DIVISION		
ASSISTANT CITY ENG.		6-3

APPROVED BY
DIRECTOR OF PUBLIC WORKS
DATE 6-11-70

THIRD STREET STORM DRAIN EXTENSIONS

MAIN TO ORANGE

HORIZ. SCALE: 1" = 20' VERT. SCALE: 1" = 2'

PROJECT NO. 3139

D-166

SHEET 1 OF 2

SS NO. 354

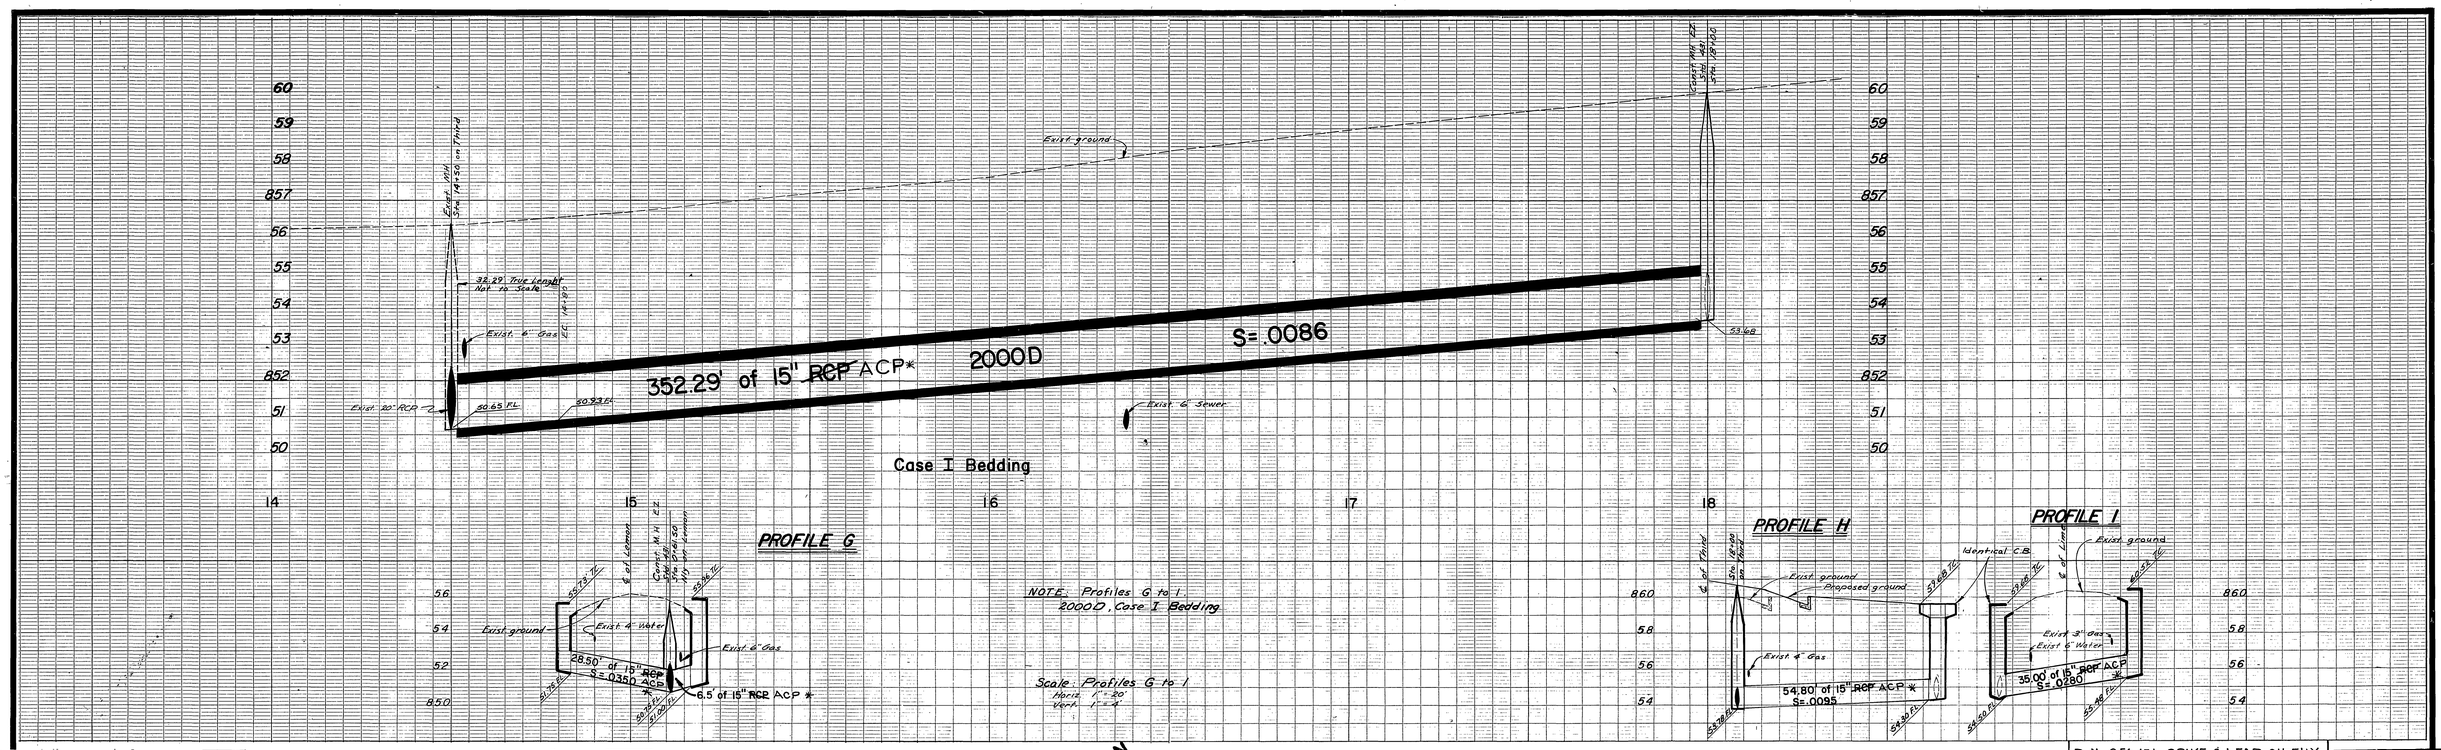

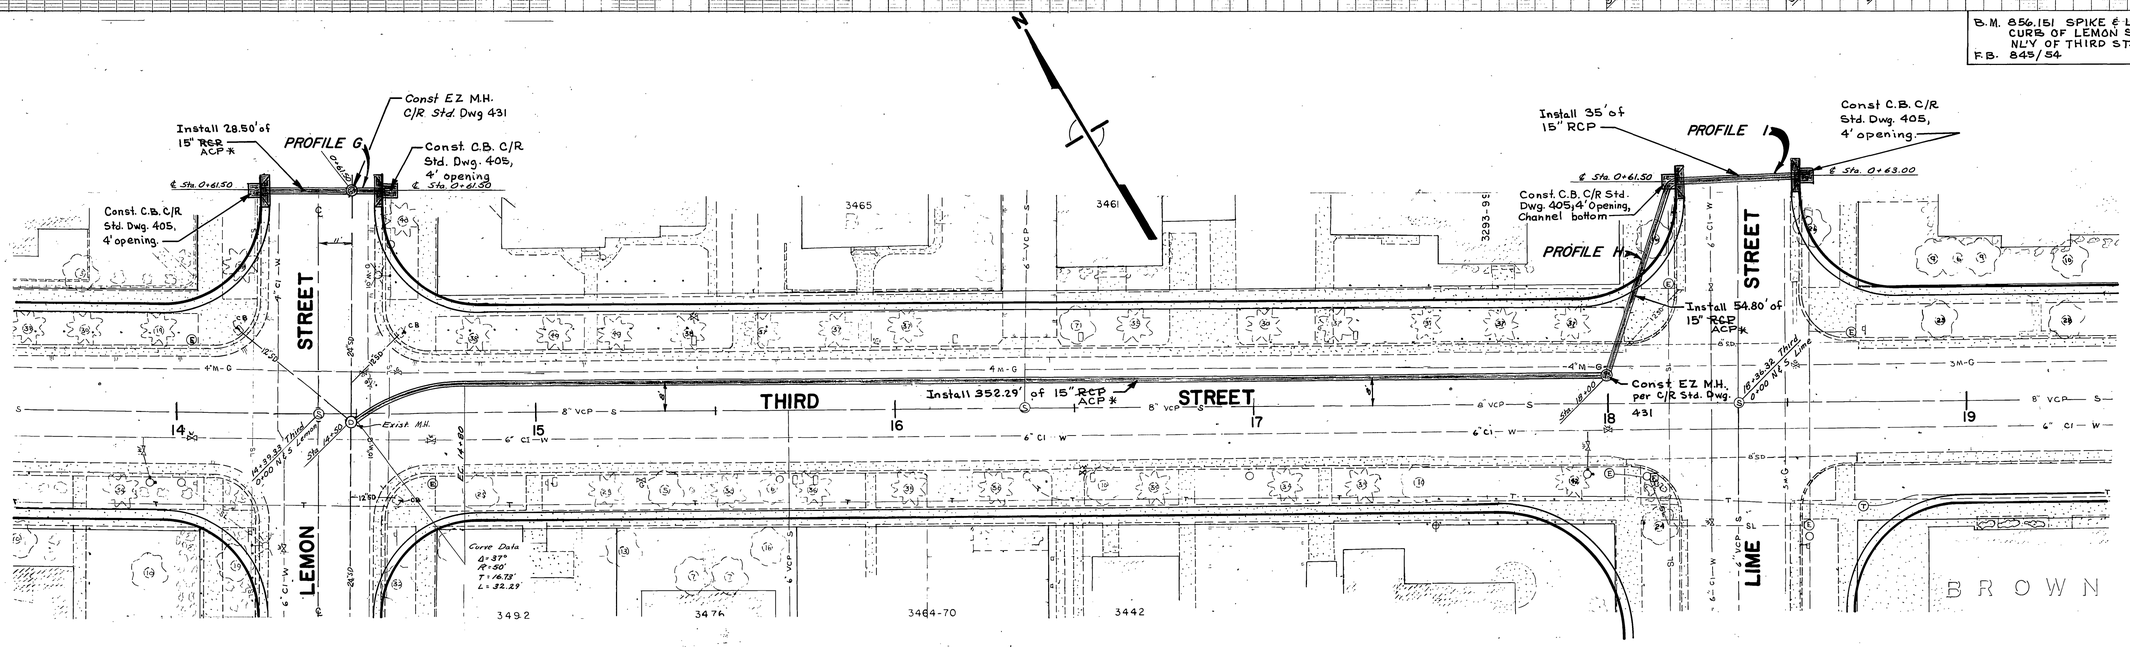

* AS BUILT 1/12/71 RCK

FOR STREET IMPROVEMENTS SEE DWG R-1257

MARK	REVISIONS	APPR.	DATE

DESIGNED BY J. Conti DRAWN BY R. Kihm CHECKED BY DCH

CITY OF RIVERSIDE, CALIFORNIA
DEPARTMENT OF PUBLIC WORKS

APPROVED BY	BY	DATE
OFFICE ENGINEER		5/70
PARK DEPARTMENT	—	—
TRAFFIC DIVISION	—	—
ASSISTANT CITY ENG.		6-3

APPROVED BY
DIRECTOR OF PUBLIC WORKS
DATE 6-11-70

THIRD STREET STORM DRAIN EXTENSIONS

LEMON TO LIME

HORIZ. SCALE: 1" = 20' VERT. SCALE: 1" = 2'

PROJECT NO. 3139

D-166

SHEET 2 OF 2

SS NO. 354