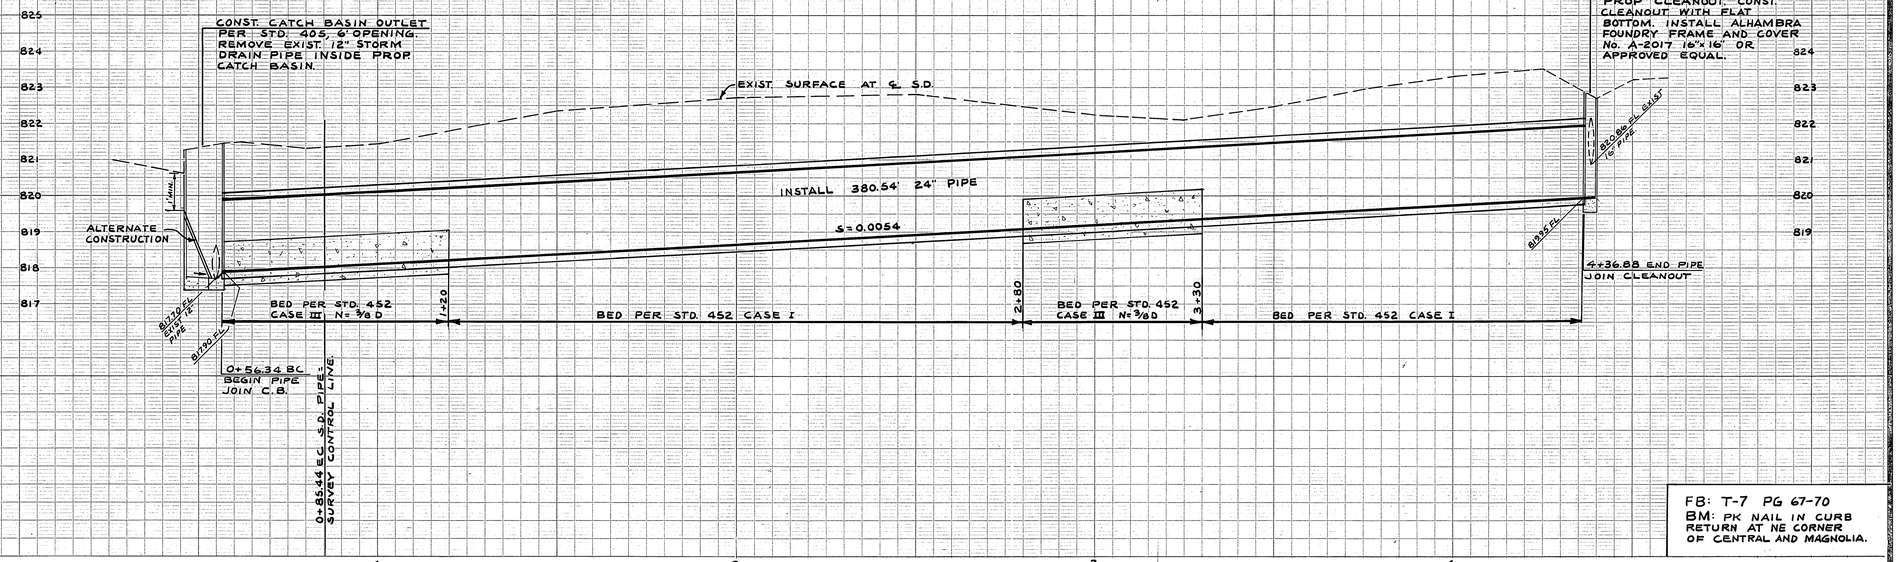

FB: T-7 PG 67-70
BM: PK NAIL IN CURB RETURN AT NE CORNER OF CENTRAL AND MAGNOLIA.

PIPE CURVE DATA
R= 90
Δ= 18° 31' 21"
L= 29.10
T= 14.68

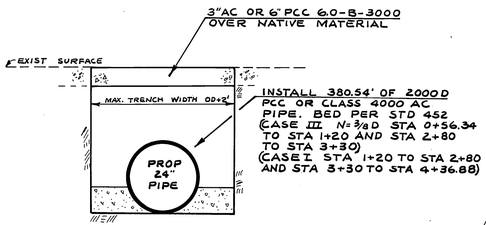

TYPICAL PIPE SECTION
SCALE: 1"= 2'

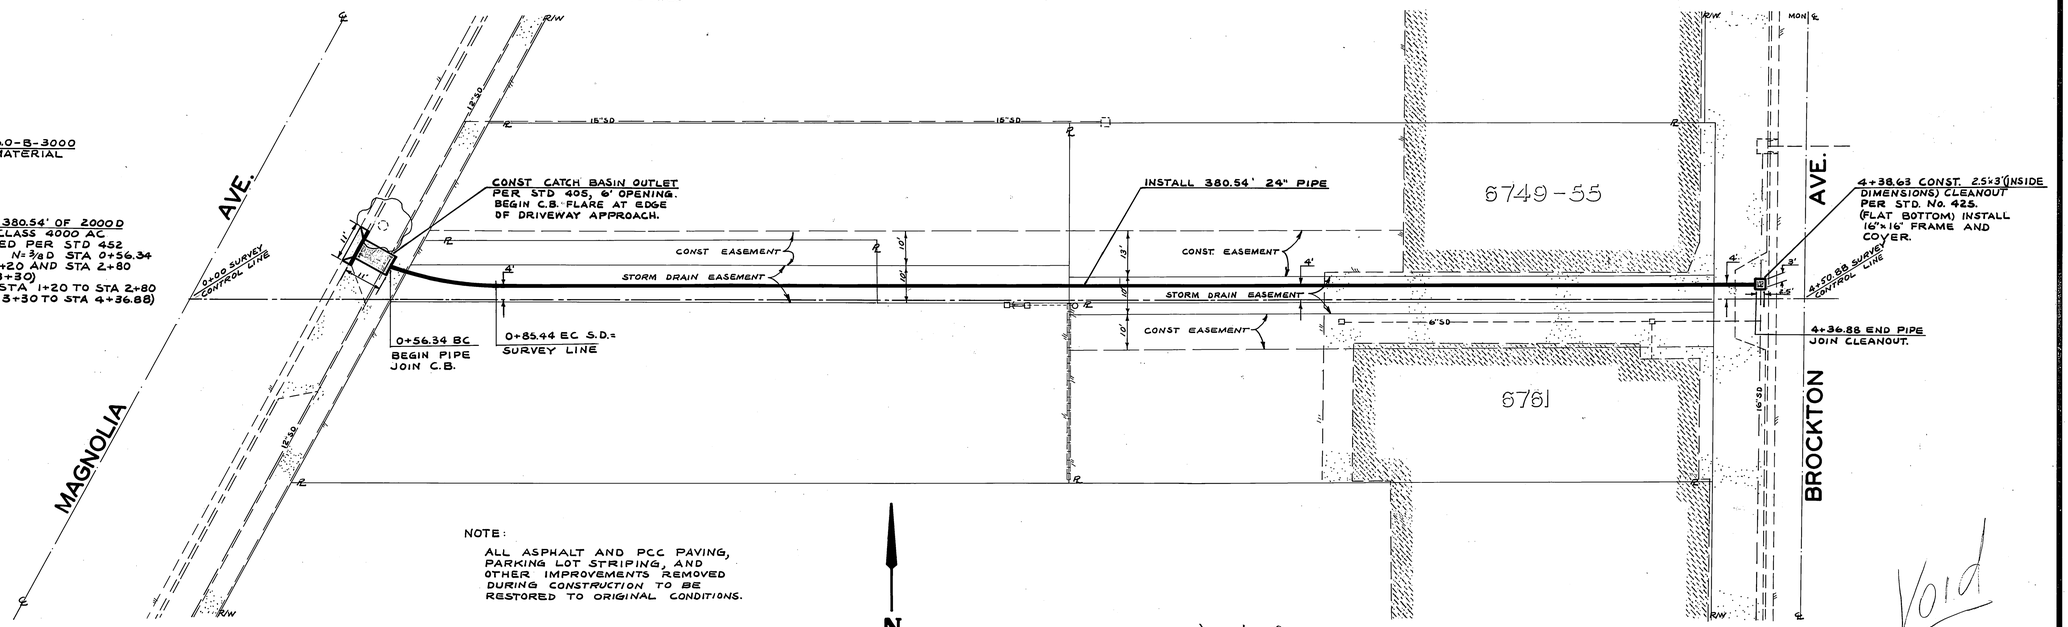

NOTE:
ALL ASPHALT AND PCC PAVING, PARKING LOT STRIPING, AND OTHER IMPROVEMENTS REMOVED DURING CONSTRUCTION TO BE RESTORED TO ORIGINAL CONDITIONS.

N

Void

NOT BUILT SEE D-180

MARK	REVISIONS	APPR.	DATE
DESIGNED BY BE	DRAWN BY BE	CHECKED BY	

CITY OF RIVERSIDE, CALIFORNIA
DEPARTMENT OF PUBLIC WORKS

APPROVED BY	BY	DATE
OFFICE ENGINEER		
PARK DEPARTMENT		
TRAFFIC DIVISION		
ASSISTANT CITY ENG.		

APPROVED BY
DIRECTOR OF PUBLIC WORKS
DATE 9-25-68

BROCKTON LOW STORM DRAIN

260' N'LY OF NELSON ST, FROM MAGNOLIA TO BROCKTON

PROJECT NO. 418

D-174

SHEET 1 OF 1

HORIZ. SCALE: 1" = 20' VERT. SCALE: 1" = 2'

FILE NO.