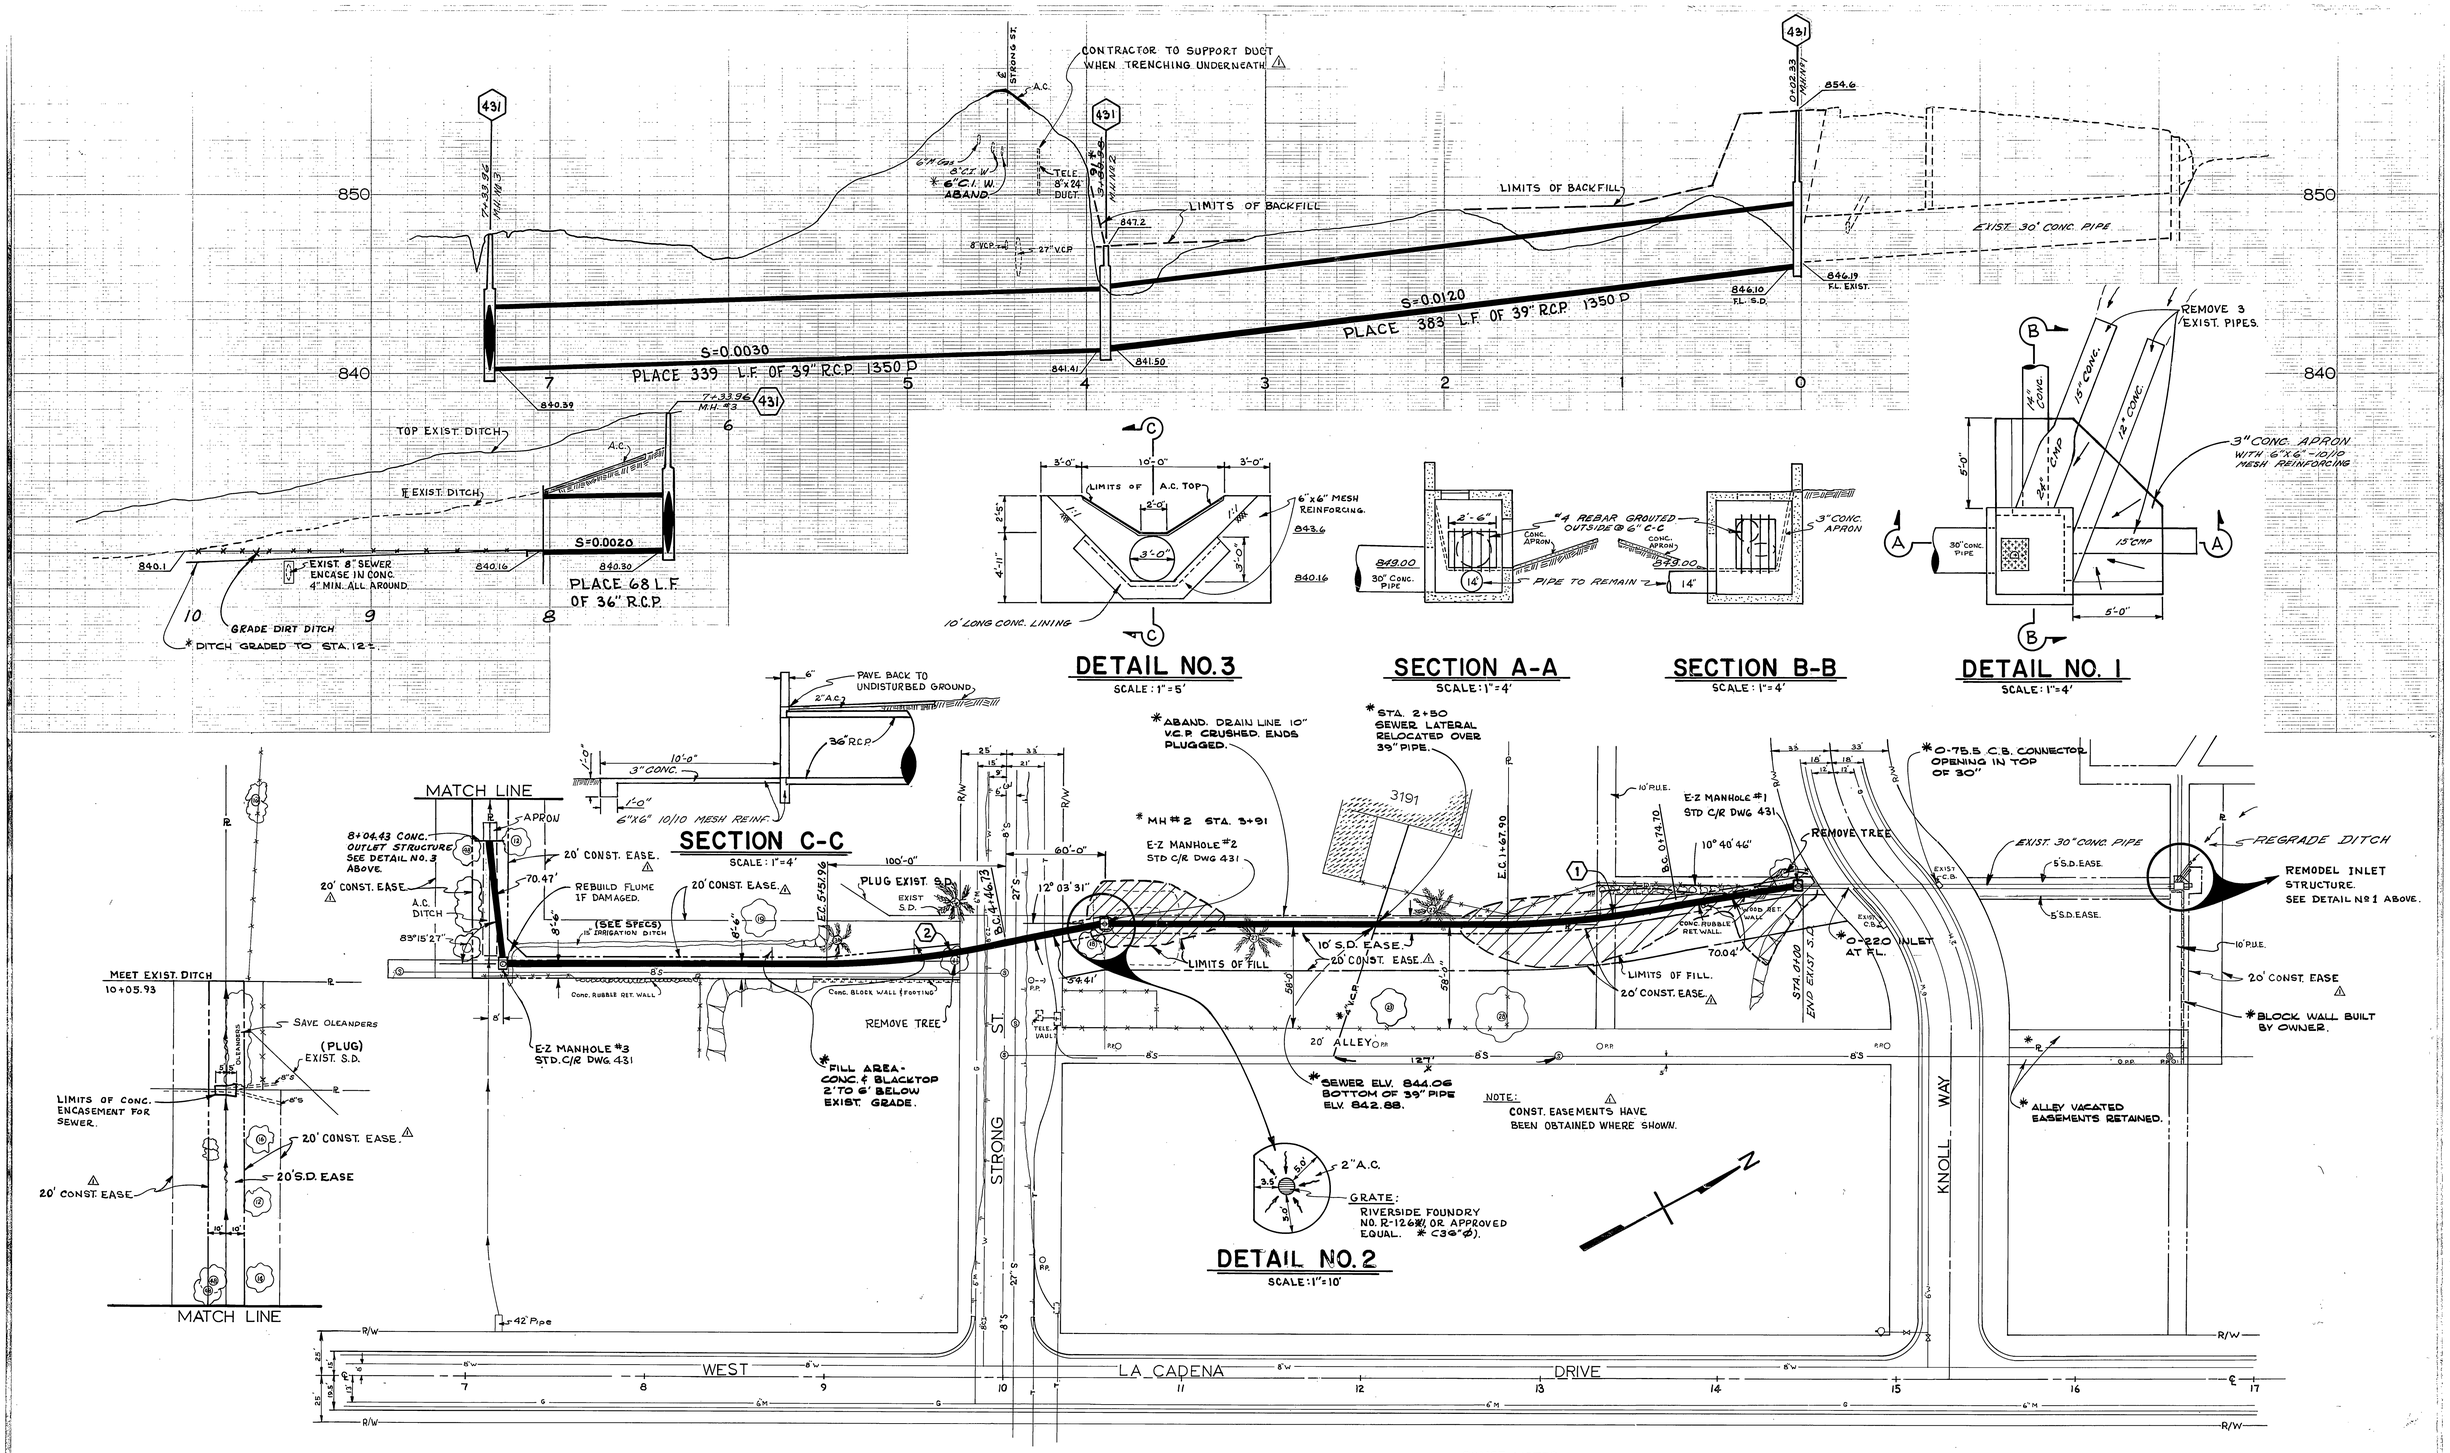

CONST. NOTES:

431 * CONST. M.H. PER C/R STD. DWG. NO. 431 - E-Z MANHOLE. MH. COVERS PER RIVERSIDE FOUNDRY NO. R-1261 (36"Ø).

*AS BUILT 6/15/70 KARL BCH

CURVE DATA SEWER				
Nº	R	Δ	T	L
1	500'	10° 40' 46"	46.74'	93.20'
2	500'	12° 03' 31"	52.81	105.23'

—CAUTION—
PACIFIC TELEPHONE
CABLES UNDERGROUND
BEFORE EXCAVATING
CALL COLLECT:
7:30 A.M. to 5 P.M. — After Hours & Holidays
Orange County 714-633-0811 — 714-547-6606
Riverside County 714-684-0071 — 714-547-6606

MARK	REVISIONS	APPR.	DATE
1	CHANGED RIGHT OF ENTRY TO CONST. EASE. ADDED NOTE FOR CONTRACTOR AT TELEPHONE DUCT.	RCH	4/10/70

DESIGNED BY PCW DRAWN BY R. Kim CHECKED BY DCH

CITY OF RIVERSIDE, CALIFORNIA
DEPARTMENT OF PUBLIC WORKS

APPROVED BY	BY	DATE
PRINCIPAL ENGINEER		
PARK DEPARTM		
TRAFFIC DIVISION		
CHIEF P. W. ENGR.		1-8

APPROVED BY
DIRECTOR OF PUBLIC WORKS
DATE

KNOLL-STRONG STORM DRAIN

BETWEEN KNOLL WAY AND 300'± SOUTH OF STRONG ST.

HORIZ. SCALE: 1" = 40' VERT. SCALE: 1" = 4'

PROJECT NO. 423

D-187

SHEET 1 OF 1

FILE NO.