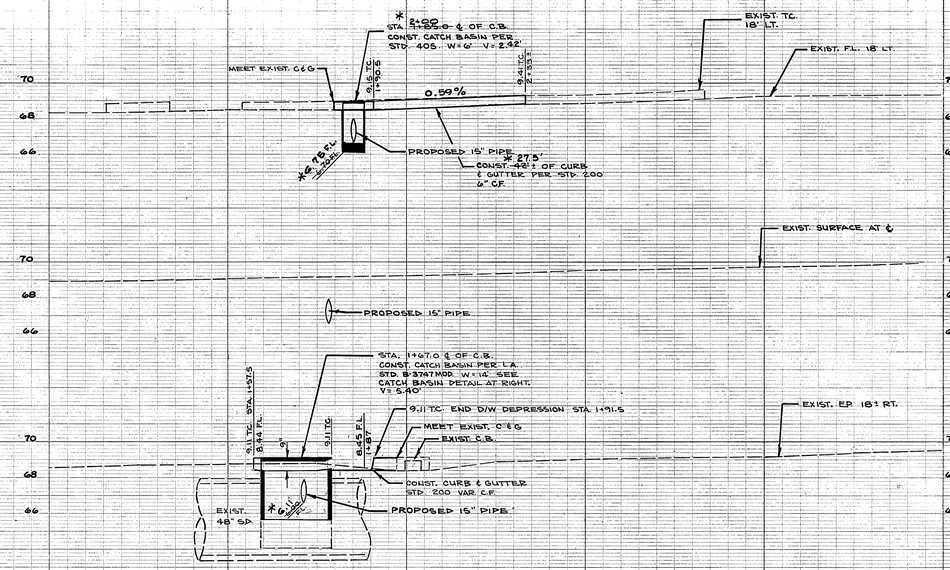

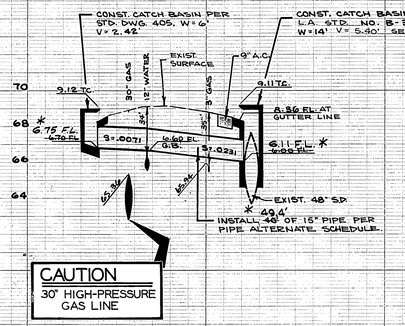

PIPE PROFILE

F.B. 919/42-45
B.M. 767.277 SPK. IN LEAD IN SLY CURB OF ARLINGTON AVE. 6'± W'LY OF ℄ OF PHOENIX PRODUCED.

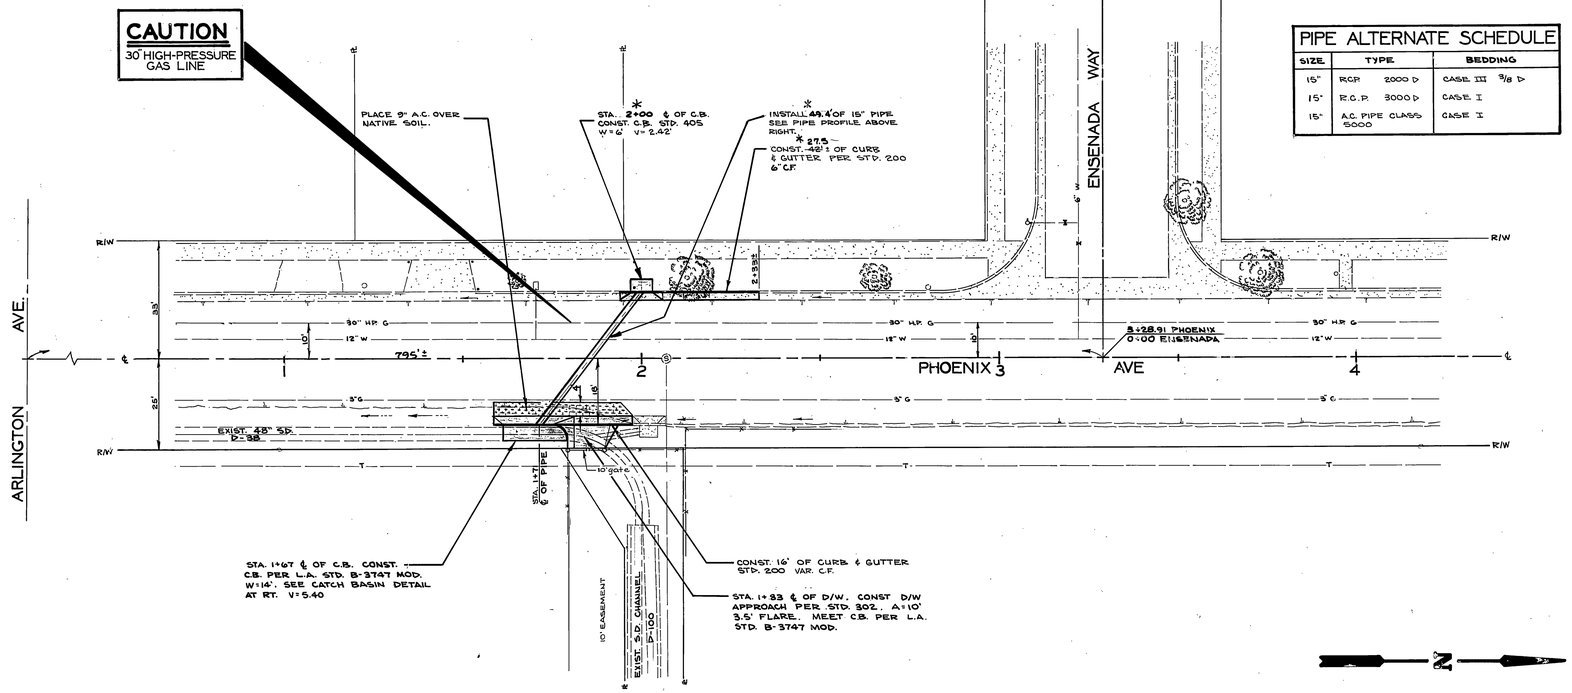

PIPE ALTERNATE SCHEDULE		
SIZE	TYPE	BEDDING
15"	RCP 2000 D	CASE III 3/8 D
15"	R.C.P. 3000 D	CASE I
15"	A.C. PIPE CLASS 5000	CASE I

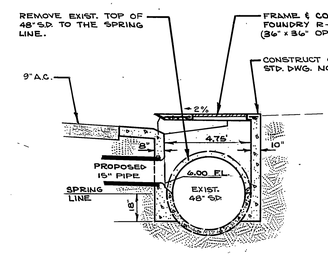

STA. 1+71

CATCH BASIN DETAIL

SCALE 1" = 4'

CONSTUCTION NOTES

1- CONTRACTOR SHALL ROUND ALL LEDGES ON THE INSIDE OF THE CATCH BASINS. USE 3" RADIUS.

2- UTILITIES HAVE BEEN PLOTTED FROM AVAILABLE RECORDS. UTILITIES COMPANIES ARE TO BE CONTACTED AT LEAST 48 HOURS PRIOR TO TRENCHING NEAR THEIR FACILITIES.

3- SAW CUT EXIST. A.C. WHERE A.C. REMOVAL IS INDICATED.

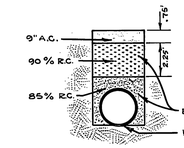

R.C. = RELATIVE COMPACTION

TYPICAL TRENCH SECTION

NO SCALE

* as built · 11/13/70 · Karl

-CAUTION-
PACIFIC TELEPHONE
CABLES UNDERGROUND
BEFORE EXCAVATING
CALL COLLECT:
7:30 A.M. to 5 P.M. | After Hours & Holidays
Orange County 714-633-0811 | 714-547-6606
Riverside County 714-684-0071 | 714-547-6606

MARK	REVISIONS	APPR.	DATE

DESIGNED BY Lansing DRAWN BY Lansing CHECKED BY BE

CITY OF RIVERSIDE, CALIFORNIA
DEPARTMENT OF PUBLIC WORKS

APPROVED BY	BY	DATE
PRINCIPAL ENGINEER	[illegible]	7/31
PARK DEPARTMENT	—	—
TRAFFIC DIVISION	—	—
CHIEF P. W. ENGR.	[illegible]	7/31

APPROVED BY [signature]
DIRECTOR OF PUBLIC WORKS
DATE 8-3-70

PHOENIX STORM DRAIN AT ENSENADA

PROJECT NO. 427

D-188

SHEET 1 OF 1

HORIZ. SCALE: 1" = 20' VERT. SCALE: 1" = 4' FILE NO.