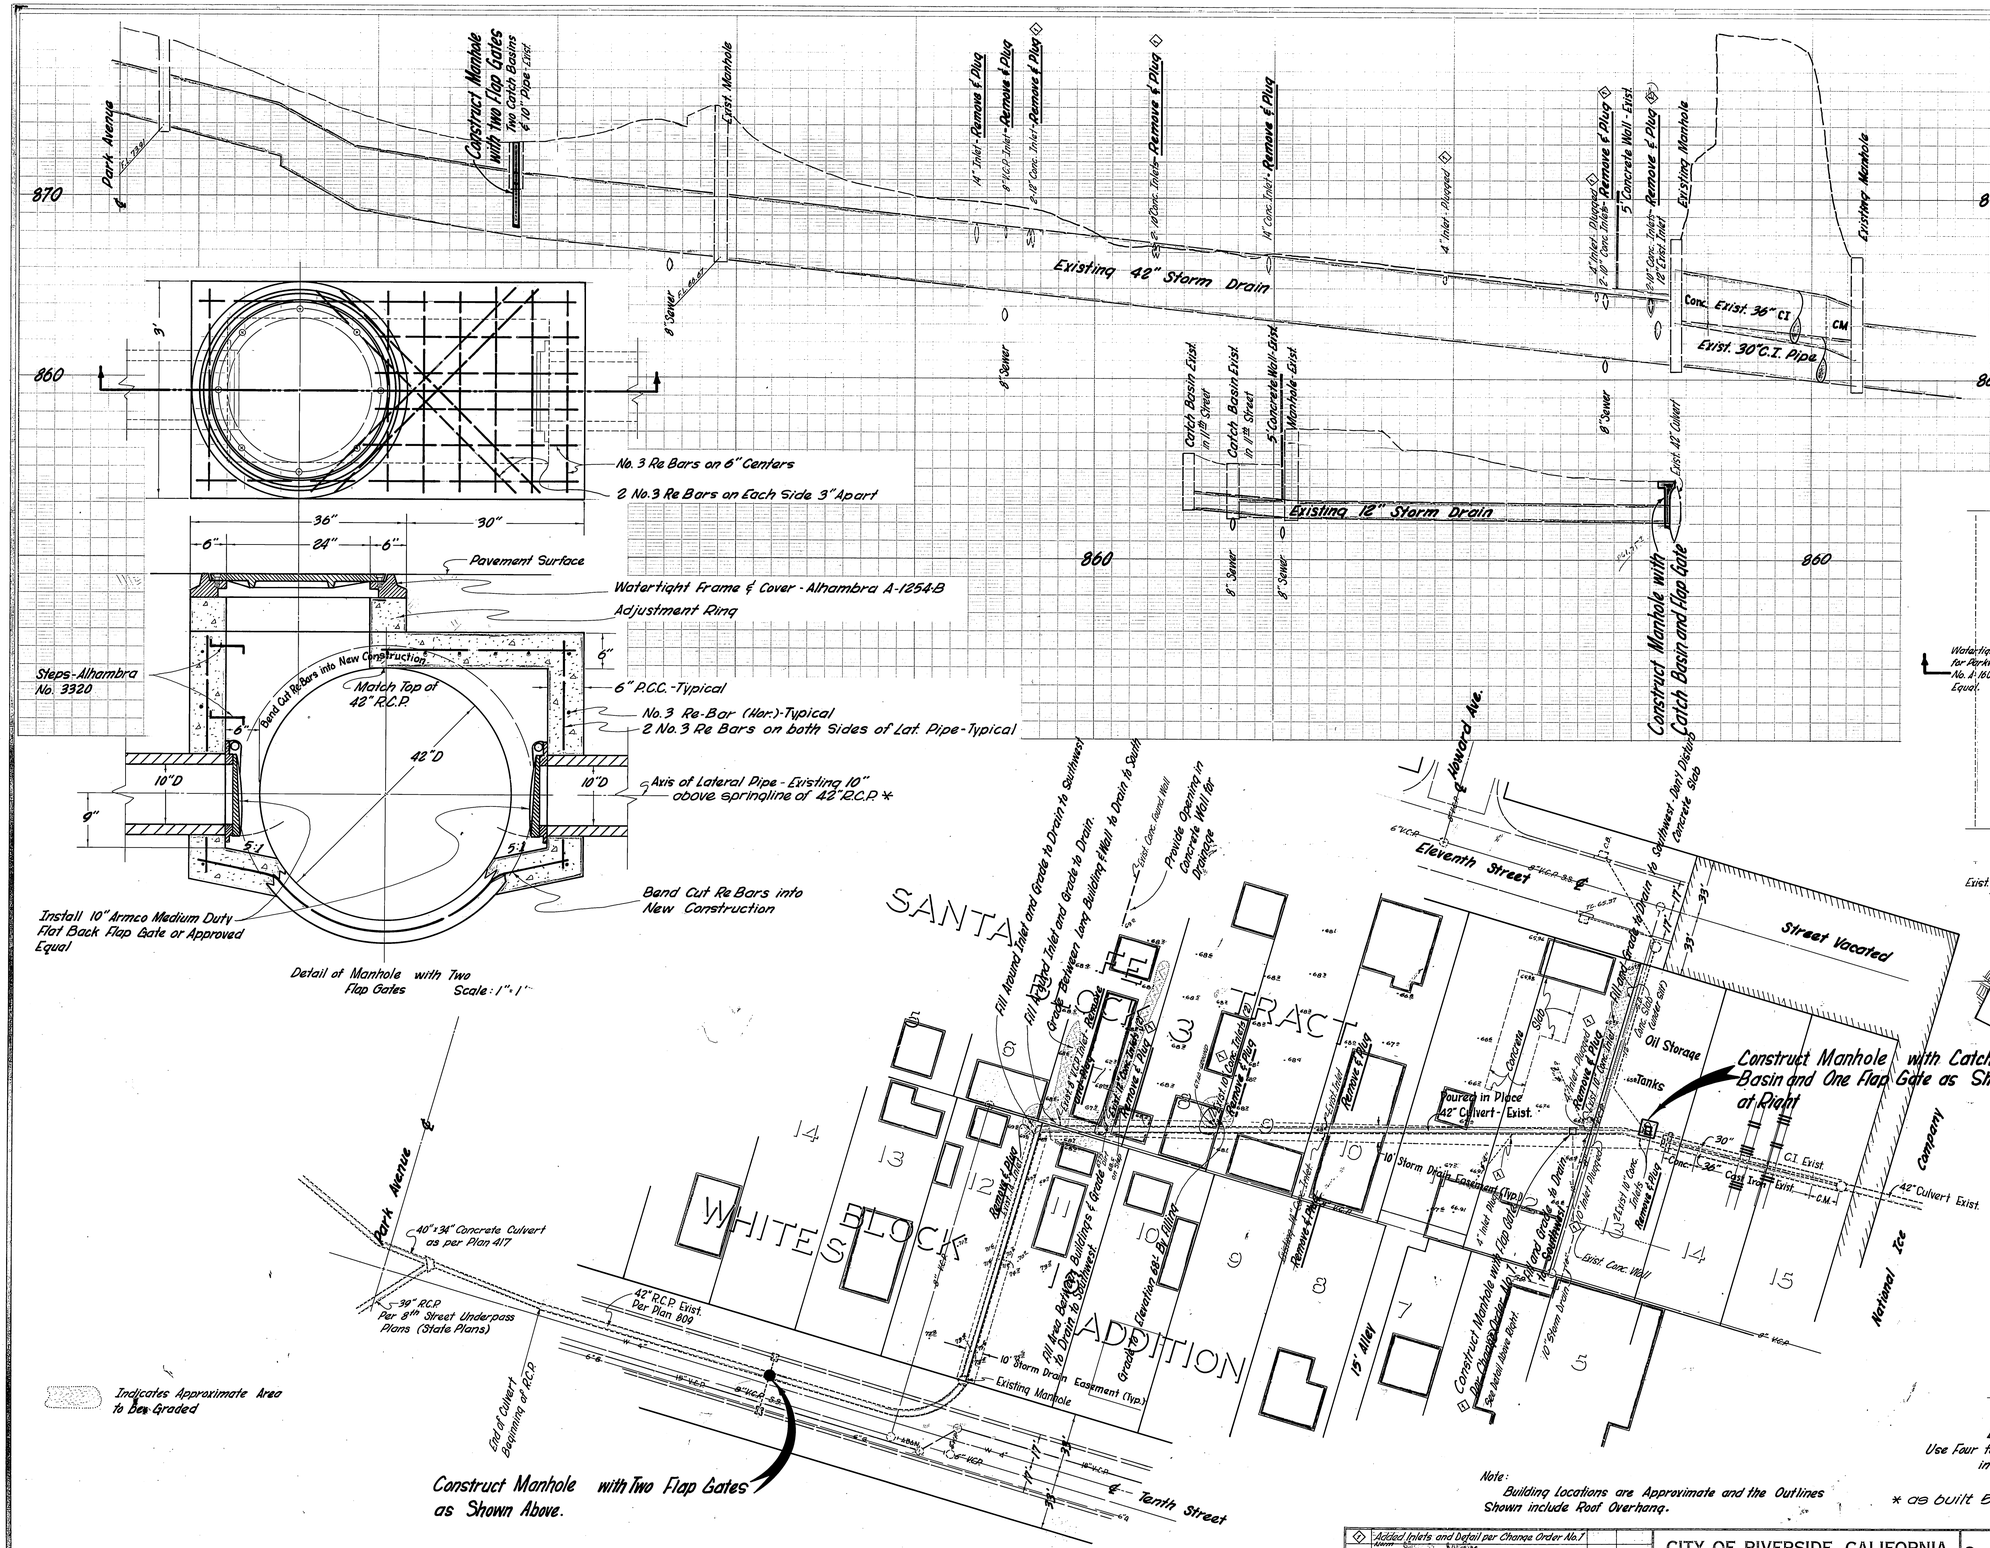

Note:
Building Locations are Approximate and the Outlines Shown include Roof Overhang.

* as built 5-19-70 norm

MARK	REVISIONS	APPR.	DATE
◇	Added Inlets and Detail per Change Order No. 1		

DESIGNED BY ____ DRAWN BY Norm CHECKED BY ____

CITY OF RIVERSIDE, CALIFORNIA
DEPARTMENT OF PUBLIC WORKS

APPROVED BY	BY	DATE
OFFICE ENGINEER		
~~PARK SUPERINTENDENT~~		
~~WATER SUPERINTENDENT~~		
ASSISTANT CITY ENG.	[illegible]	11-24

APPROVED BY
DIRECTOR OF PUBLIC WORKS
DATE

Box Springs Storm Drain Modification
@ Grey Hollow
Between Park Ave & Nat'l. Ice Co. & 10TH & 11TH St.

HORIZ. SCALE: 1" = 40' VERT. SCALE: 1" = 4'

PROJECT NO. D-197
SHEET 1 OF 1
FILE NO.