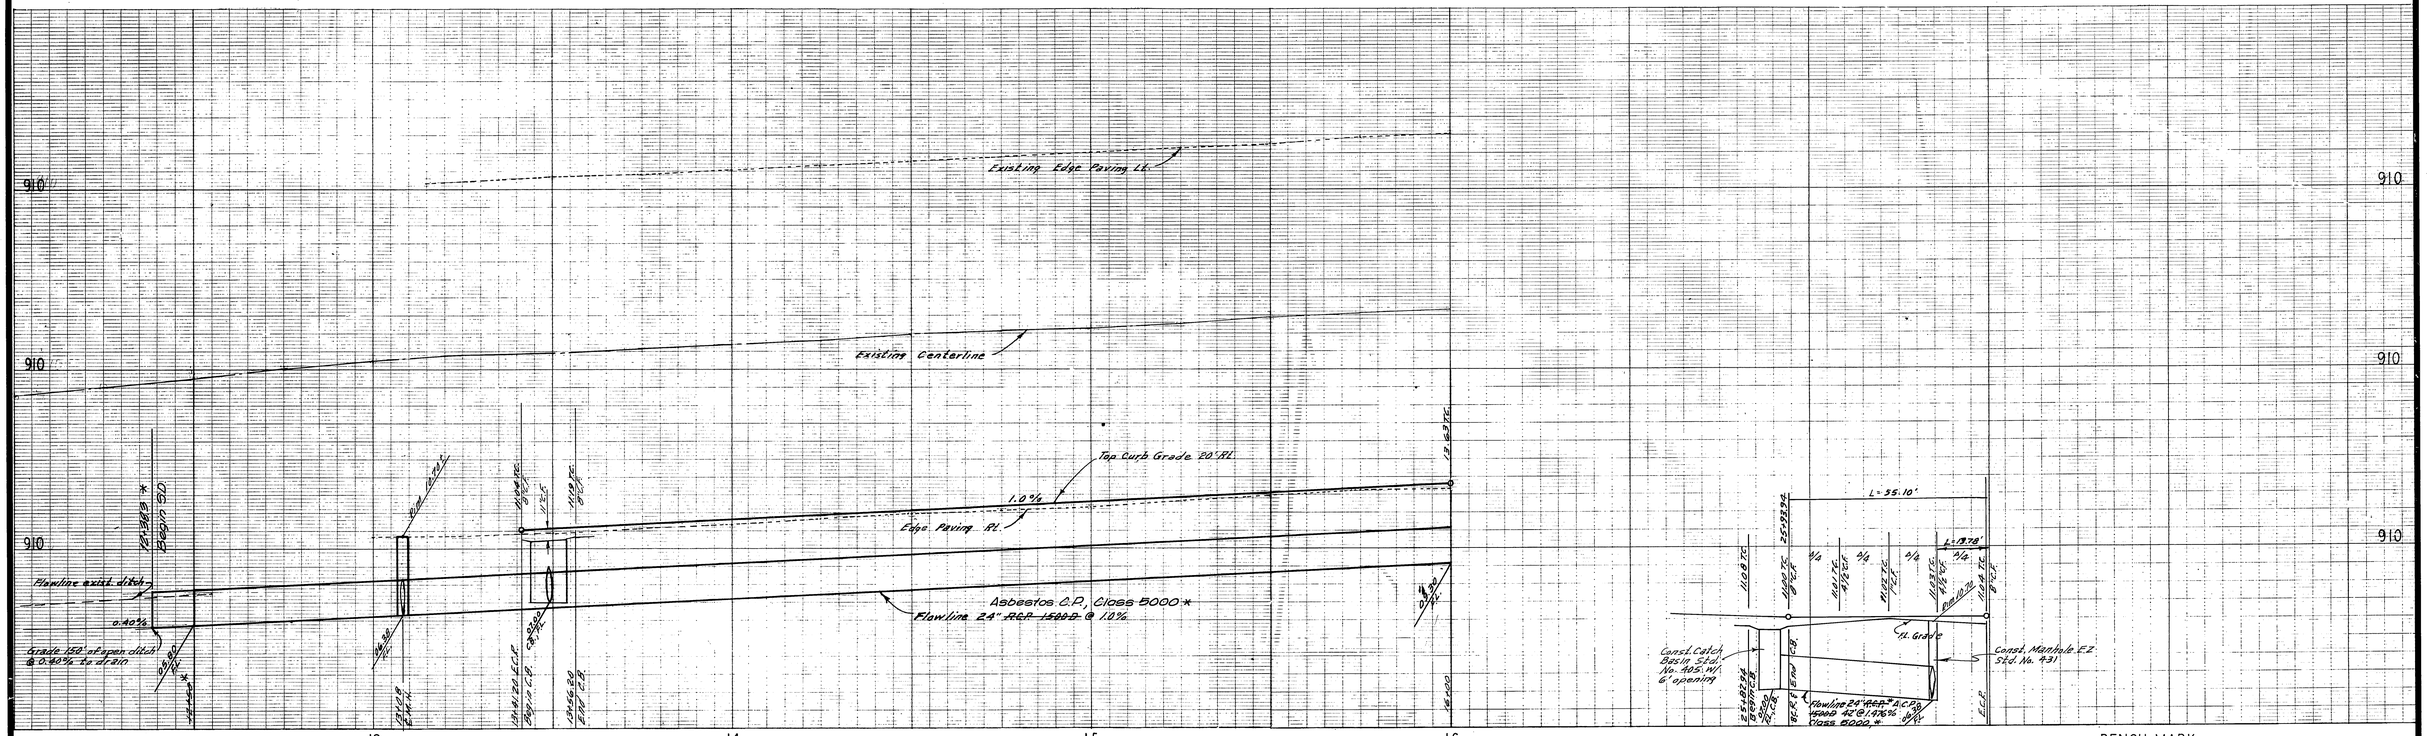

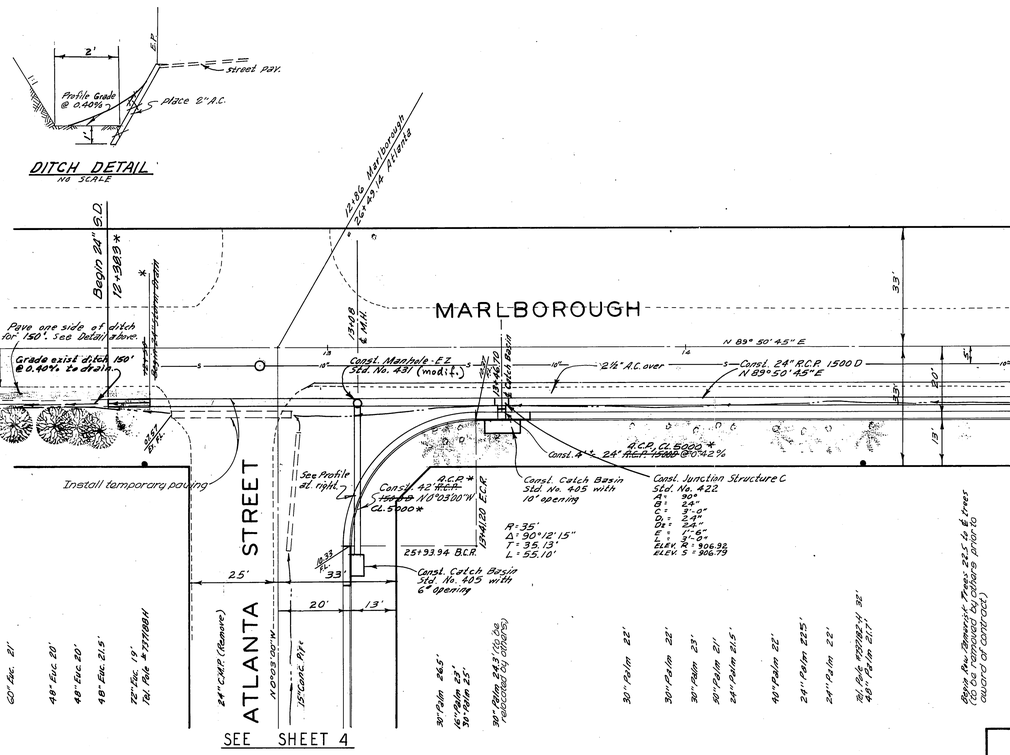

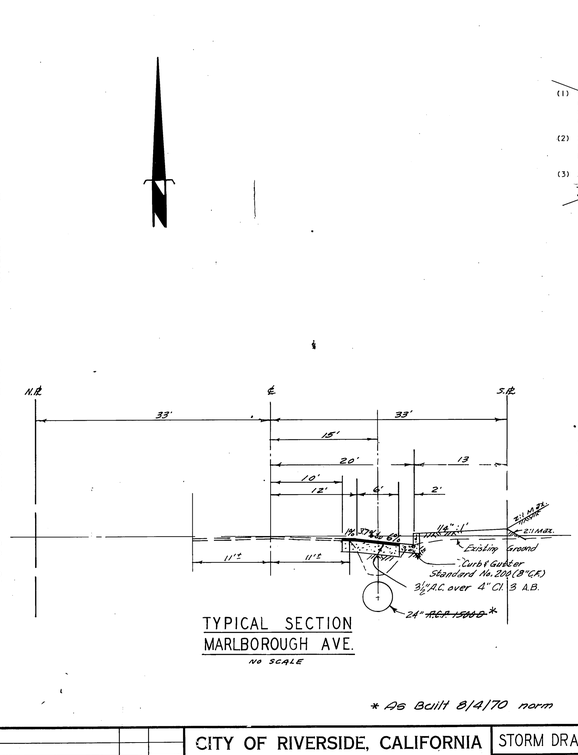

BENCH MARK

R.R. spike in pole No. 18308-J NW cor Iowa Ave. and Marlborough Ave. ELEV. 927.562 C/A FB 602-77

GENERAL NOTES

(1) It shall be the responsibility of the contractor to clear the right of way in accordance with the provisions of law as it affects each utility, including irrigation lines and appurtenances, and at no cost to the City.

(2) Construction shall be in accordance with the City of Riverside, Department of Public Works, Specifications No. 461 and Standard Drawings.

(3) Storm drain will be installed by City's contractor and construction shall be in accordance with Standard Specification, 1970 Edition, and special provisions.

QUANTITY ESTIMATE

24" ~~RCP 1500 D~~ - A.C.P., Class 5000 *	782.7* ~~777~~ L.F.
Catch Basin Standard No. 405	2 Ea.
Manhole E2 Standard No. 431 (modif.)	1 Ea.
Junction Structure C Standard No. 422	1 Ea.
A.C. Paving	720* S.F.

* As Built 8/4/70 norm v BY KARL 8/5/70

NOTICE TO CONTRACTOR

The existence and location of any underground utility pipes or structures shown on these plans are obtained by a search of the available records. To the best of our knowledge, there are no existing utilities except as shown on these plans.

The Contractor is required to take due precautionary measures to protect the utility lines shown and any other lines not of record or not shown on these plans.

ALBERT A. WEBB ASSOCIATES
CIVIL ENGINEERS
RIVERSIDE, CALIFORNIA
APPROVED BY Albert A. Webb DATE 5/14/70
R.E. No. 9876
W.O. 70-112 FOR: F.B.

MARK	REVISIONS	APPR.	DATE

DESIGNED BY BEL DRAWN BY B.E.L. CHECKED BY

CITY OF RIVERSIDE, CALIFORNIA
PUBLIC WORKS DEPARTMENT

	BY	DATE
APPROVED BY		
PRINCIPAL ENGINEER	[illegible]	5/26
PARK DEPARTMENT		
TRAFFIC DIVISION		
CHIEF PUB. WKS. ENGR.	[illegible]	5/26

APPROVED BY
DIRECTOR OF PUBLIC WORKS
DATE

STORM DRAIN PLAN AND PROFILE
MARLBOROUGH AVE.
M.P. - 4 - 690
SCALE: 1" = 20' Horiz. , 1" = 4' Vert.

ACCOUNT No.
DRAWING NUMBER D-204
SHEET 1 OF 2
70-112-D

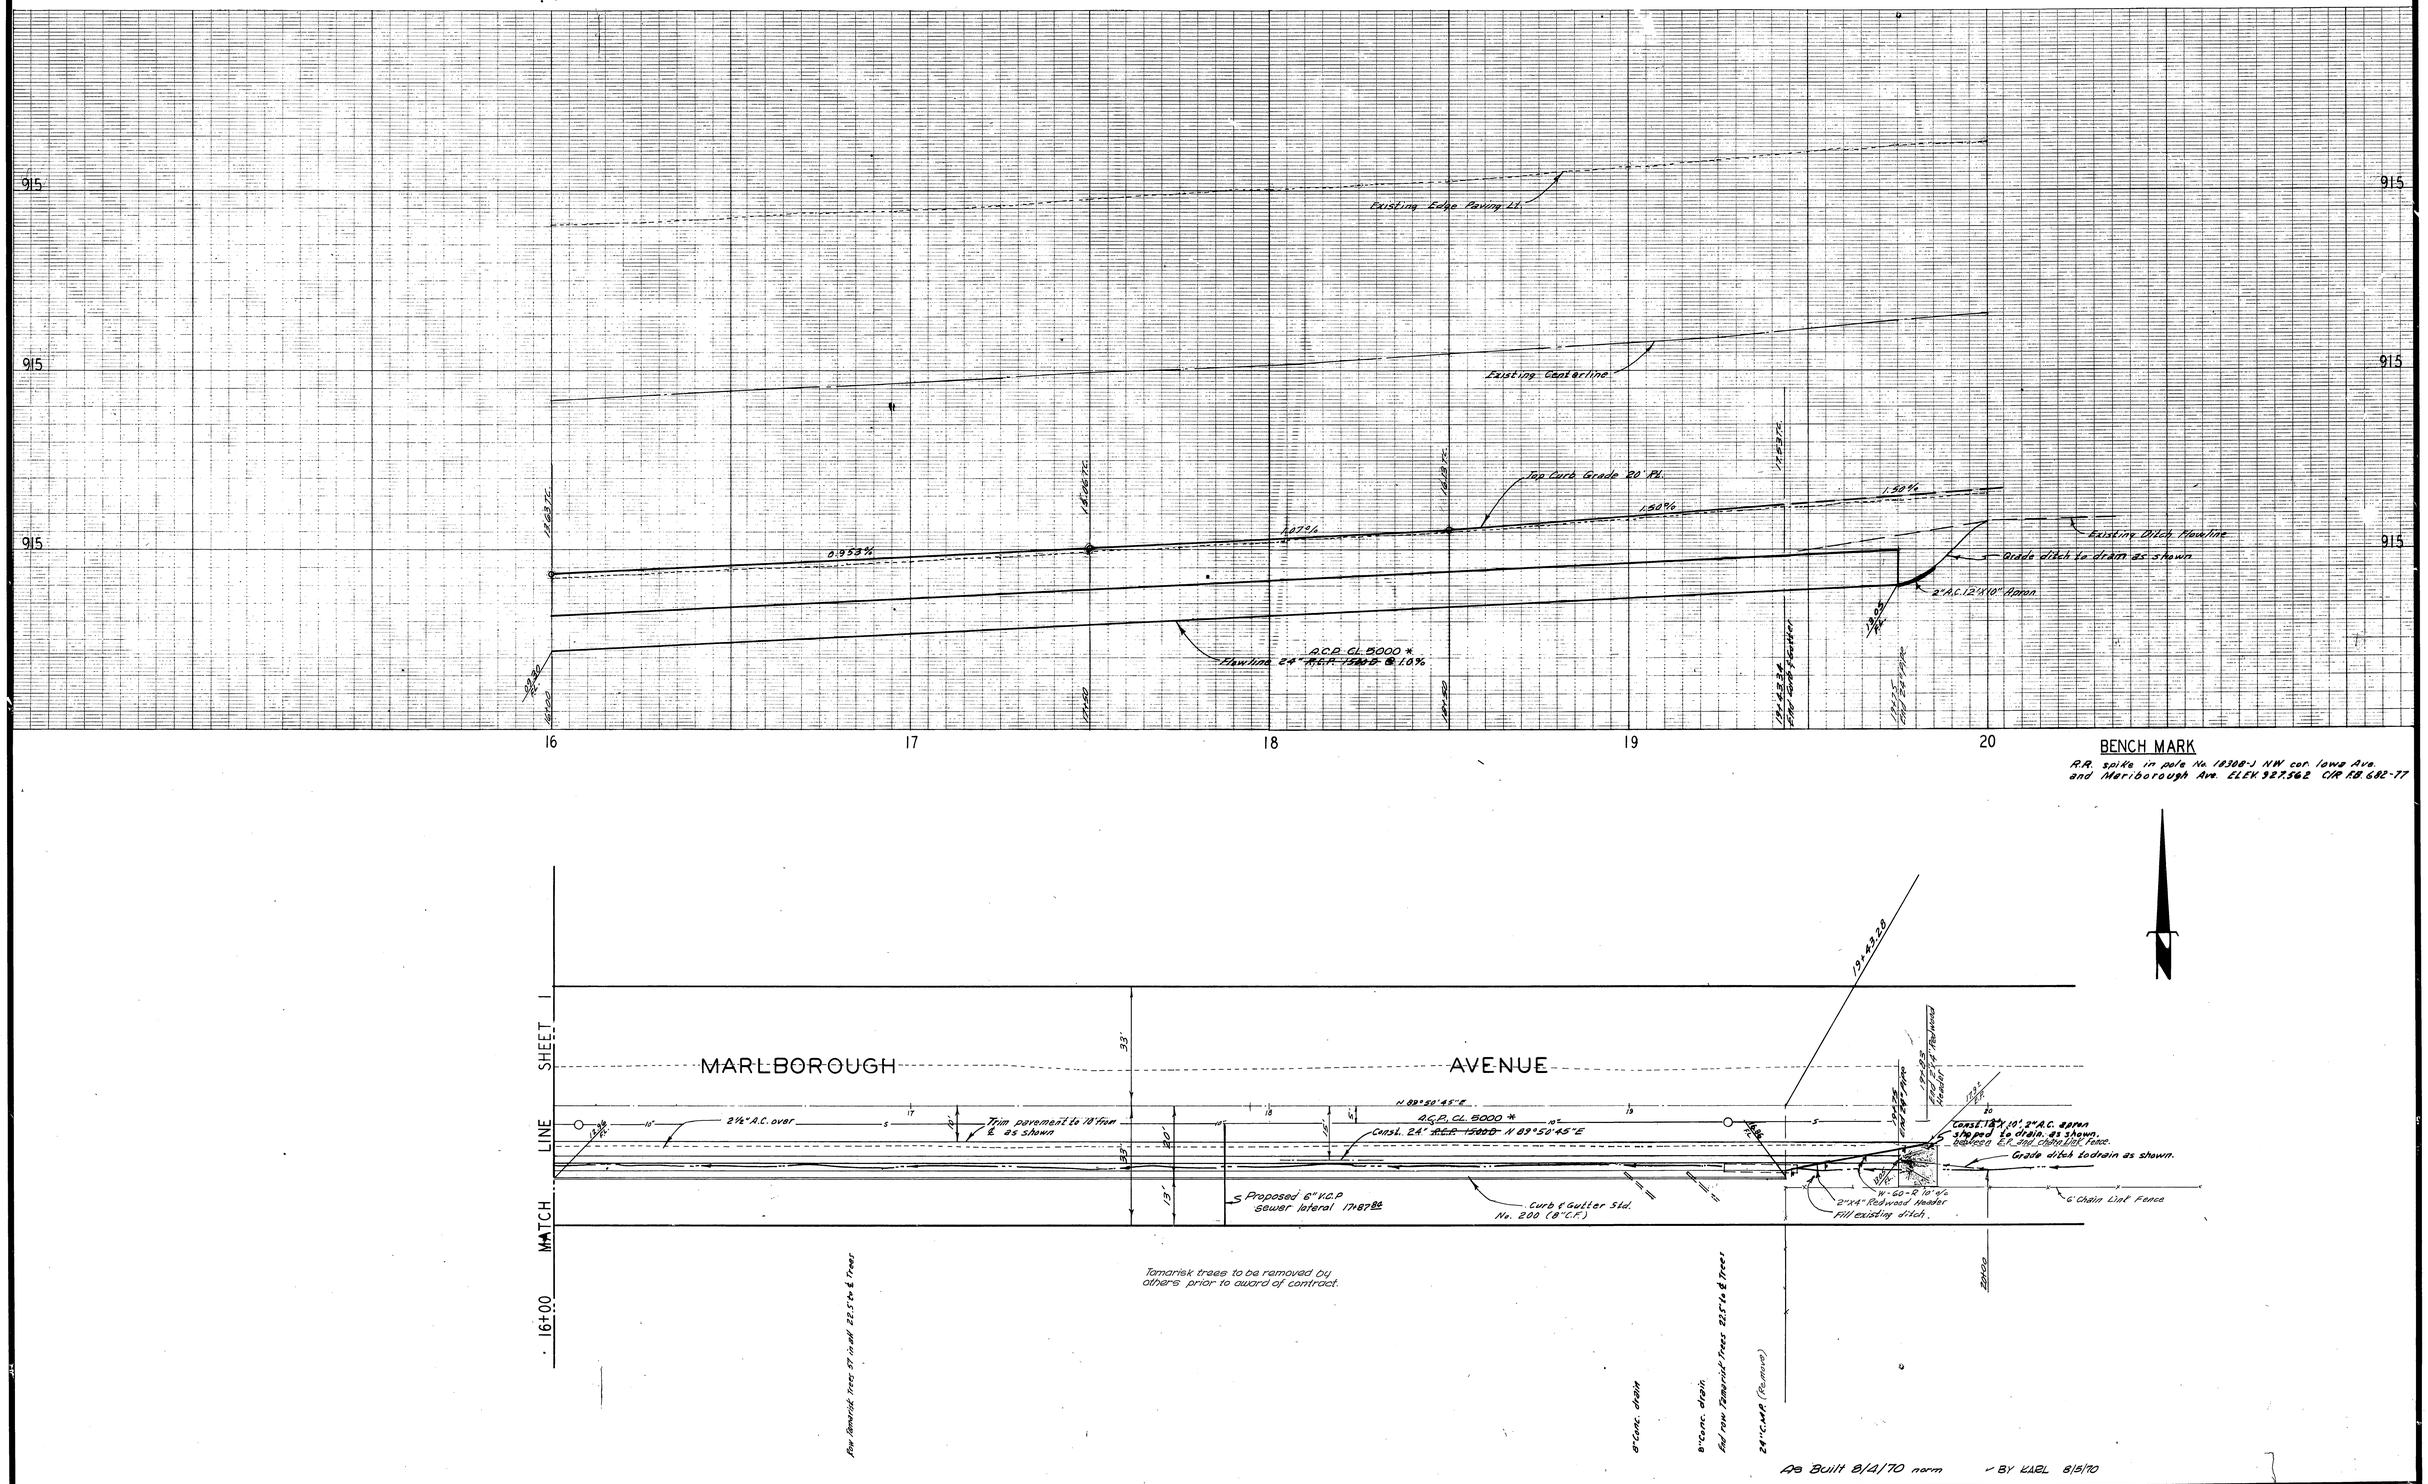

NOTICE TO CONTRACTOR

The existence and location of any underground utility pipes or structures shown on these plans are obtained by a search of the available records. To the best of our knowledge, there are no existing utilities except as shown on these plans.

The Contractor is required to take due precautionary measures to protect the utility lines shown and any other lines not of record or not shown on these plans.

ALBERT A. WEBB ASSOCIATES
CIVIL ENGINEERS
RIVERSIDE, CALIFORNIA
APPROVED BY Ernest N. Webb DATE 5/14/70
R.E. No. 9876
W.O. 70-112 FOR: F.B.

MARK	REVISIONS	APPR.	DATE

DESIGNED BY BEL DRAWN BY BEL CHECKED BY

CITY OF RIVERSIDE, CALIFORNIA
PUBLIC WORKS DEPARTMENT

APPROVED BY	BY	DATE
PRINCIPAL ENGINEER	[illegible]	5/26
PARK DEPARTMENT	—	—
TRAFFIC DIVISION	—	—
CHIEF PUB. WKS. ENGR.	[illegible]	5/26

APPROVED BY [signature]
DIRECTOR OF PUBLIC WORKS
DATE 5-27-70

STORM DRAIN PLAN AND PROFILE
MARLBOROUGH AVE.
M.P. - 4 - 690
SCALE: 1" = 20' Horiz., 1" = 4' Vert.

ACCOUNT No.
DRAWING NUMBER
D-204
SHEET 2 OF 2
70-112-D