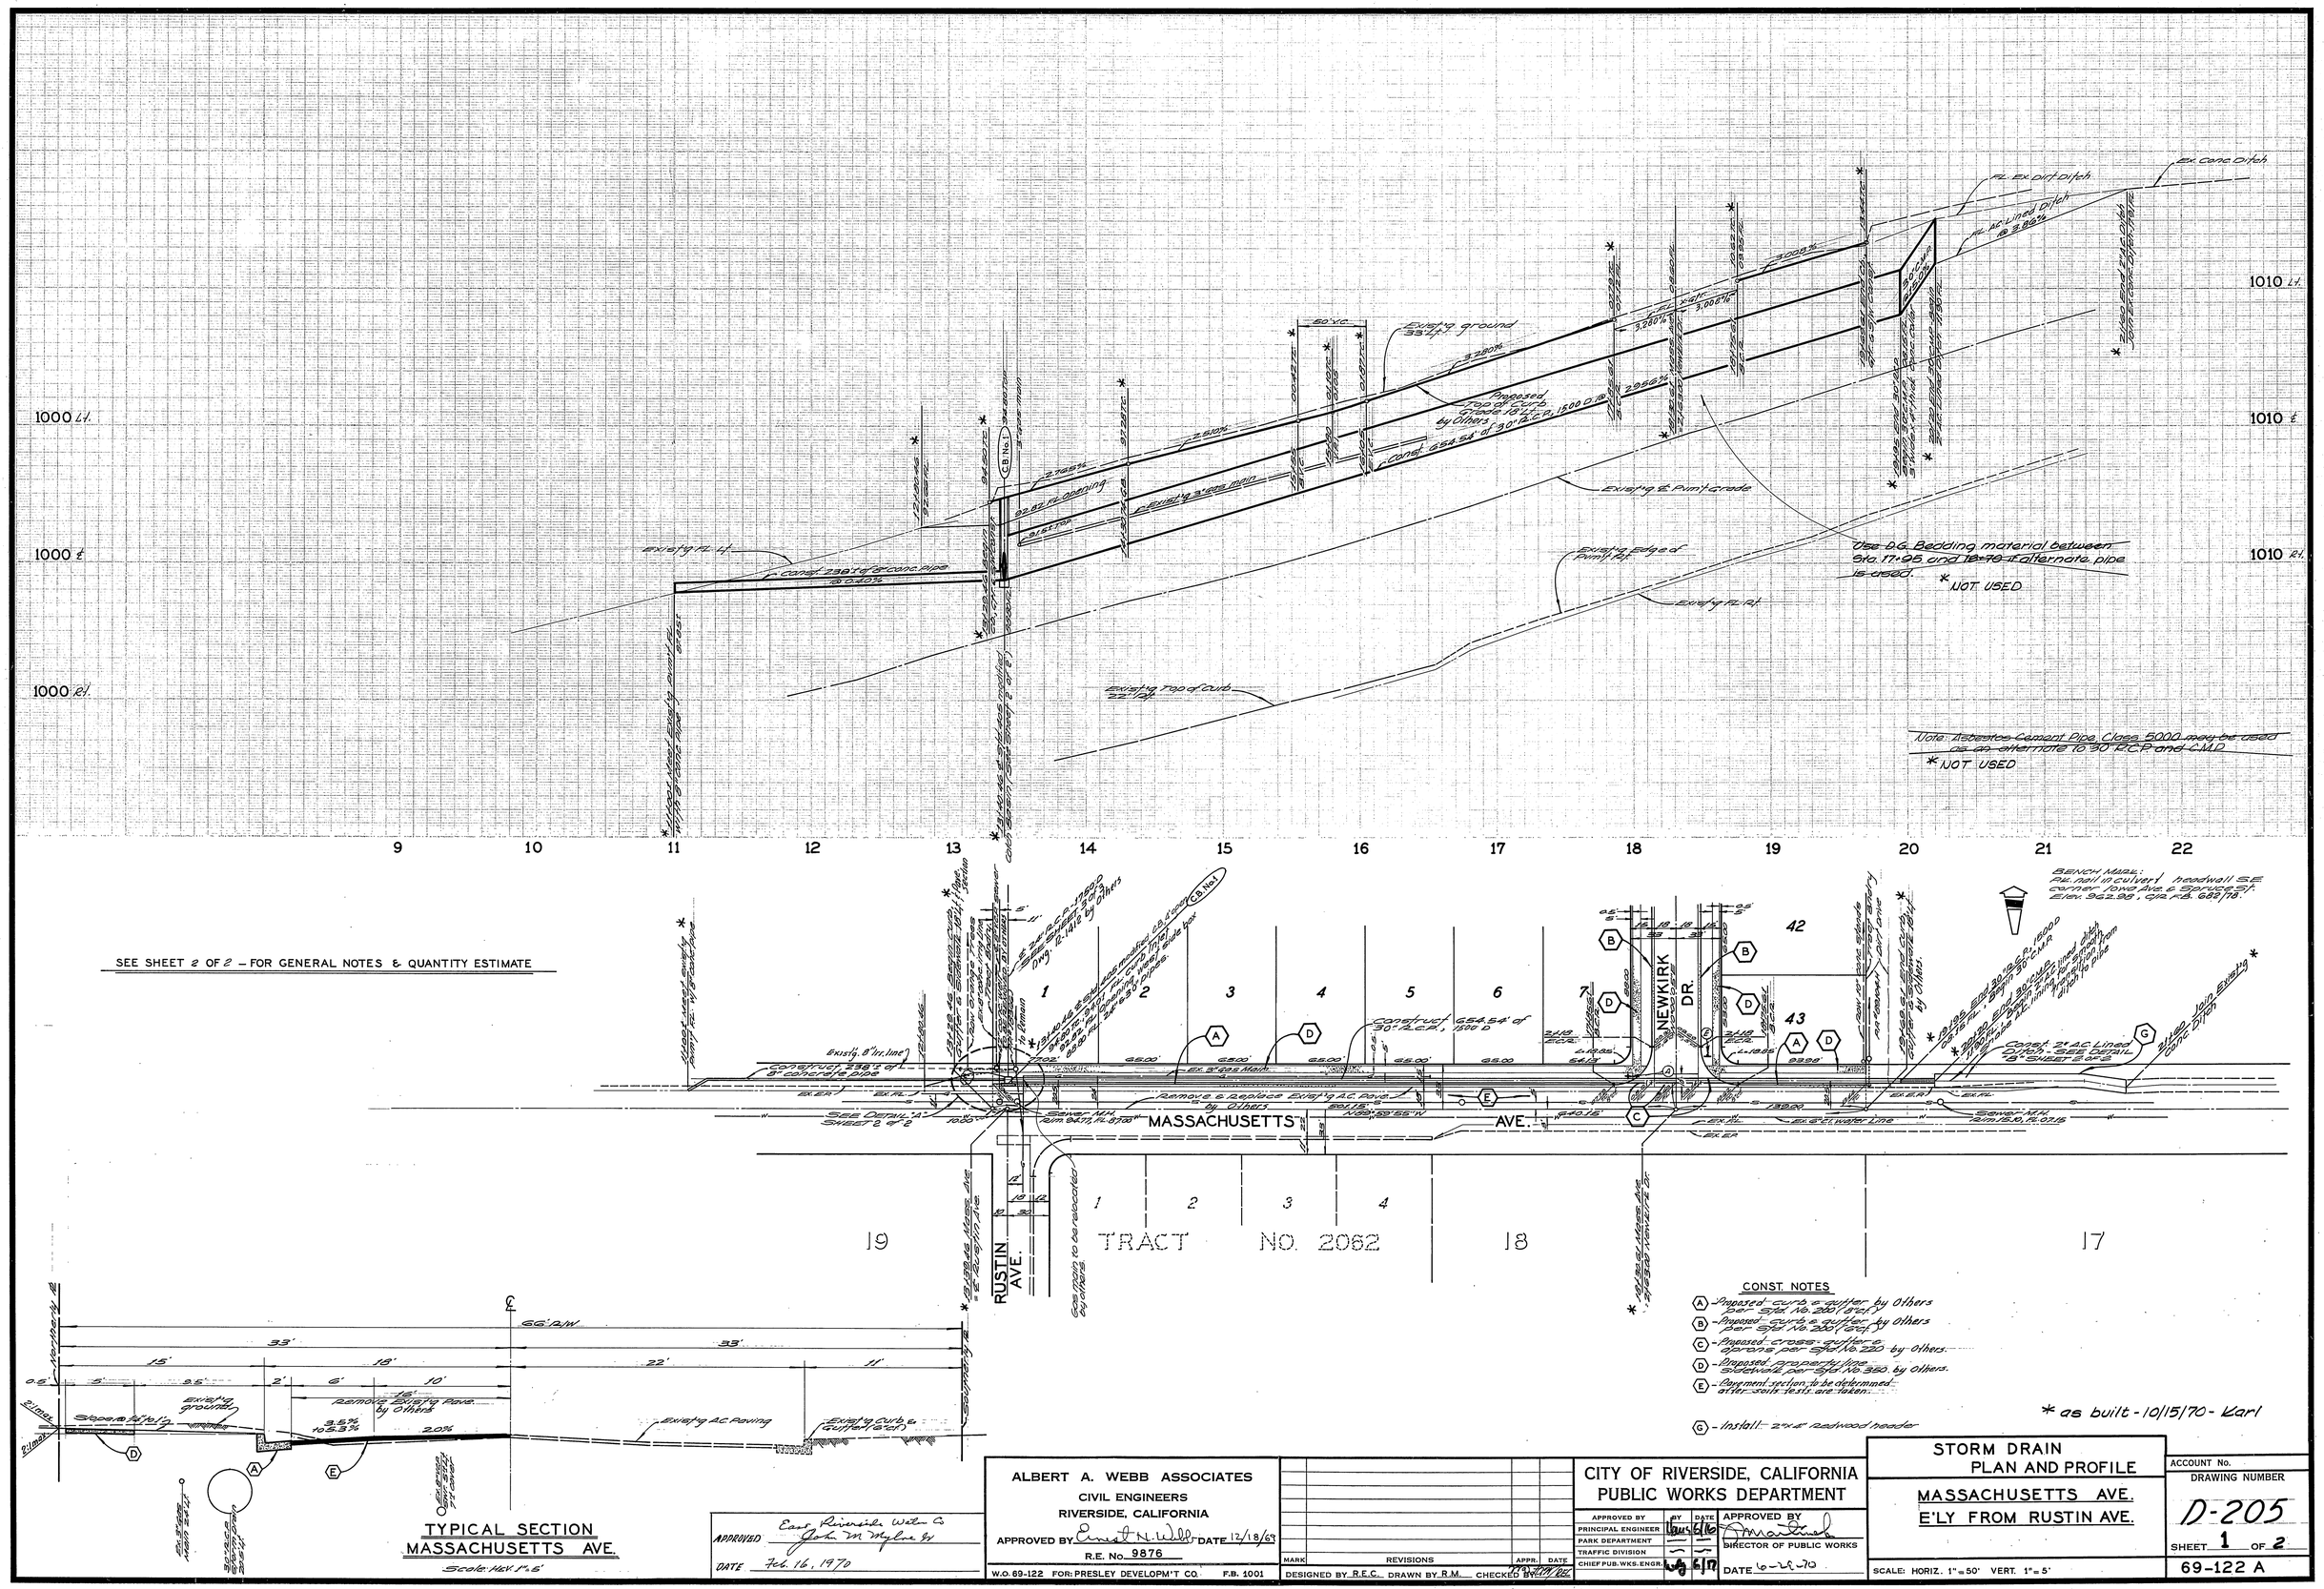

APPROVED East Riverside Water Co. John M. Mylne Jr.
DATE Feb. 16, 1970

ALBERT A. WEBB ASSOCIATES
CIVIL ENGINEERS
RIVERSIDE, CALIFORNIA
APPROVED BY Ernest N. Webb DATE 12/18/69
R.E. No. 9876
W.O. 69-122 FOR: PRESLEY DEVELOPM'T CO. F.B. 1001

MARK	REVISIONS	APPR.	DATE

DESIGNED BY R.E.C. DRAWN BY R.M. CHECKED BY

CITY OF RIVERSIDE, CALIFORNIA
PUBLIC WORKS DEPARTMENT

APPROVED BY	BY	DATE
PRINCIPAL ENGINEER	[illegible]	6/16
PARK DEPARTMENT	—	—
TRAFFIC DIVISION	—	—
CHIEF PUB. WKS. ENGR.	[illegible]	6/17

APPROVED BY [signature]
DIRECTOR OF PUBLIC WORKS
DATE 6-29-70

STORM DRAIN
PLAN AND PROFILE
MASSACHUSETTS AVE.
E'LY FROM RUSTIN AVE.

SCALE: HORIZ. 1" = 50' VERT. 1" = 5'

ACCOUNT No.
DRAWING NUMBER
D-205
SHEET 1 OF 2
69-122 A

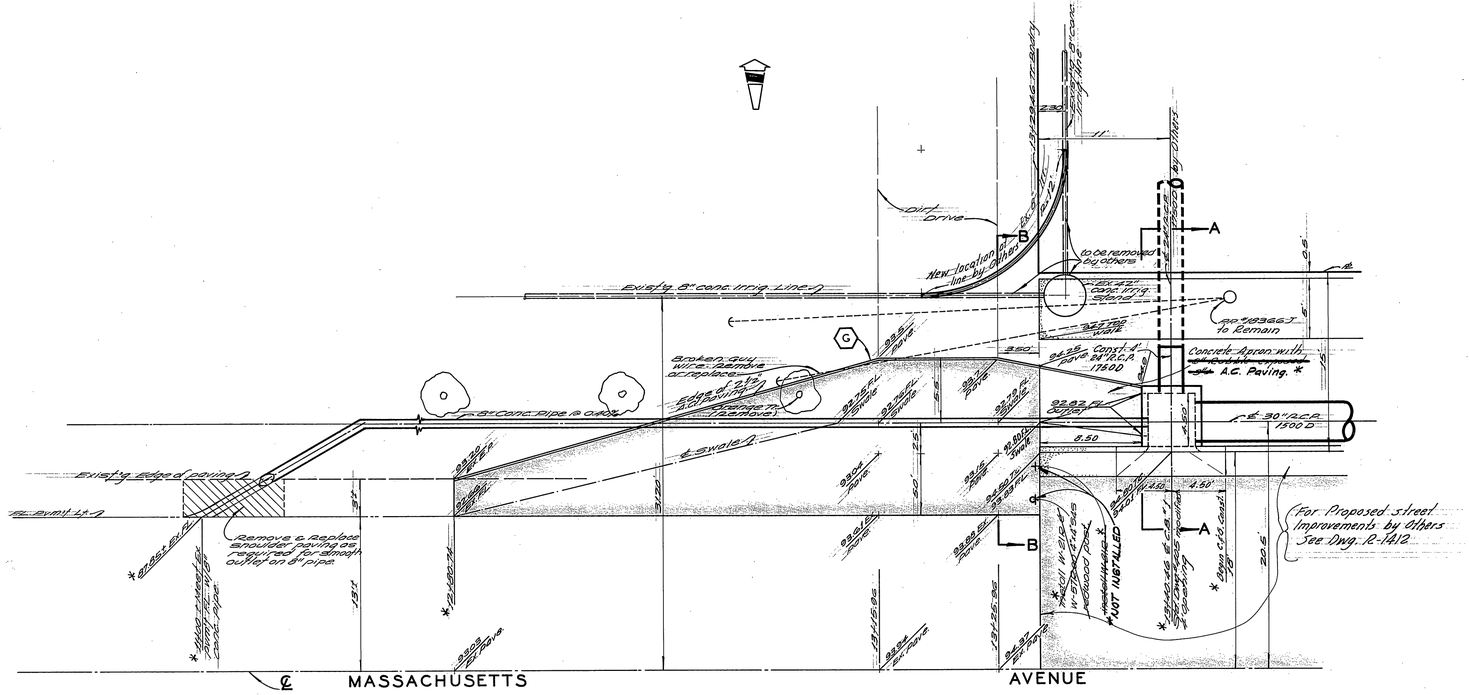

DETAIL "A"

Scale 1" = 6'

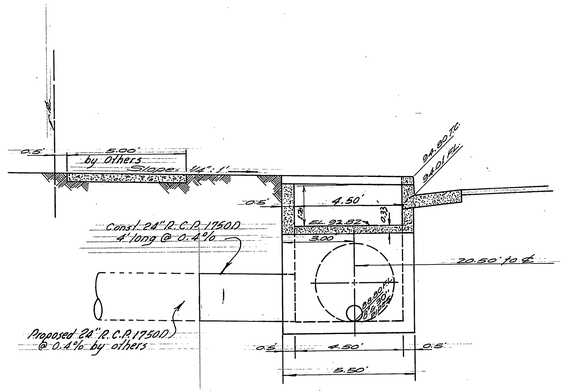

SECTION A-A

Scale 1" = 3'

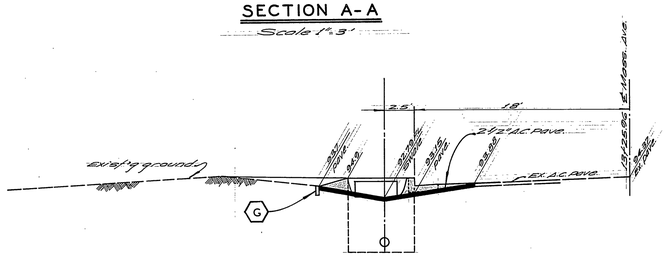

SECTION B-B

Scale 1" = 6'

NOTICE TO CONTRACTOR

The existance and location of any underground utility pipes or structures shown on these plans are obtained by a search of the available records. To the best of our knowledge, there are no existing utilities except as shown on these plans.

The Contractor is required to take due precautionary measures to protect the utility lines shown and any other lines not of record or not shown on these plans.

(G) 2"x4" Redwood Header to be installed.

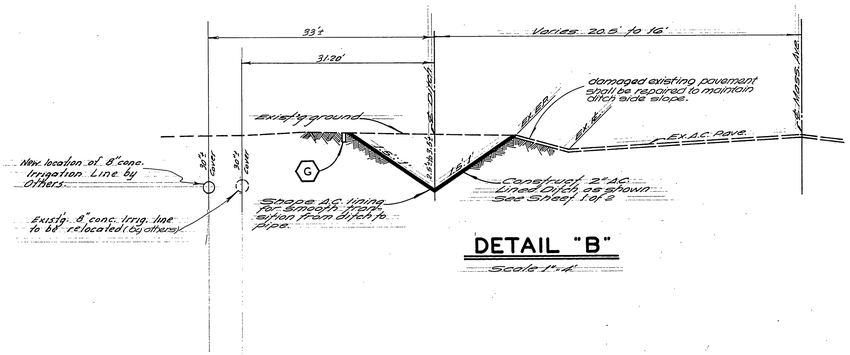

DETAIL "B"


QUANTITY ESTIMATE

24" Reinf. Conc. Pipe 1750 D	4 L.F.
30" Reinf. Conc. Pipe 1500 D	655 L.F.
30" Corr. Metal Pipe	25 L.F.
8" Concrete Pipe	238 L.F.
A.C. Pave.	1780 S.F.
Catch Basin Type 3 - Std. No. 405	1 Ea.
2"x4" Redwood Header	200 L.F.

* as built 10-15-70 · Karl

APPROVED East Riverside Water Co.
DATE 2/16/70

ALBERT A. WEBB ASSOCIATES
CIVIL ENGINEERS
RIVERSIDE, CALIFORNIA
APPROVED BY Ernest N. Webb DATE 12/18/69
R.E. No. 9876
W.O. 69-122 FOR: PRESLEY DEVELOPM'T Co. F.B. 1001

MARK	REVISIONS	APPR.	DATE

DESIGNED BY R.E.C. DRAWN BY R.M. CHECKED BY

CITY OF RIVERSIDE, CALIFORNIA
DEPARTMENT OF PUBLIC WORKS

APPROVED BY	BY	DATE
OFFICE ENGINEER		6/16
PARK DEPARTMENT	—	—
TRAFFIC DIVISION	—	—
ASSISTANT CITY ENGINEER		6/17

APPROVED BY
DIRECTOR OF PUBLIC WORKS
DATE 6-29-70

STORM DRAIN
DETAIL SHEET
MASSACHUSETTS AVE.
E'LY. FROM RUSTIN AVE.

SCALE: 1" = AS SHOWN

PROJECT NO. D-205
SHEET 2 OF 2
FILE NO. 69-122-D