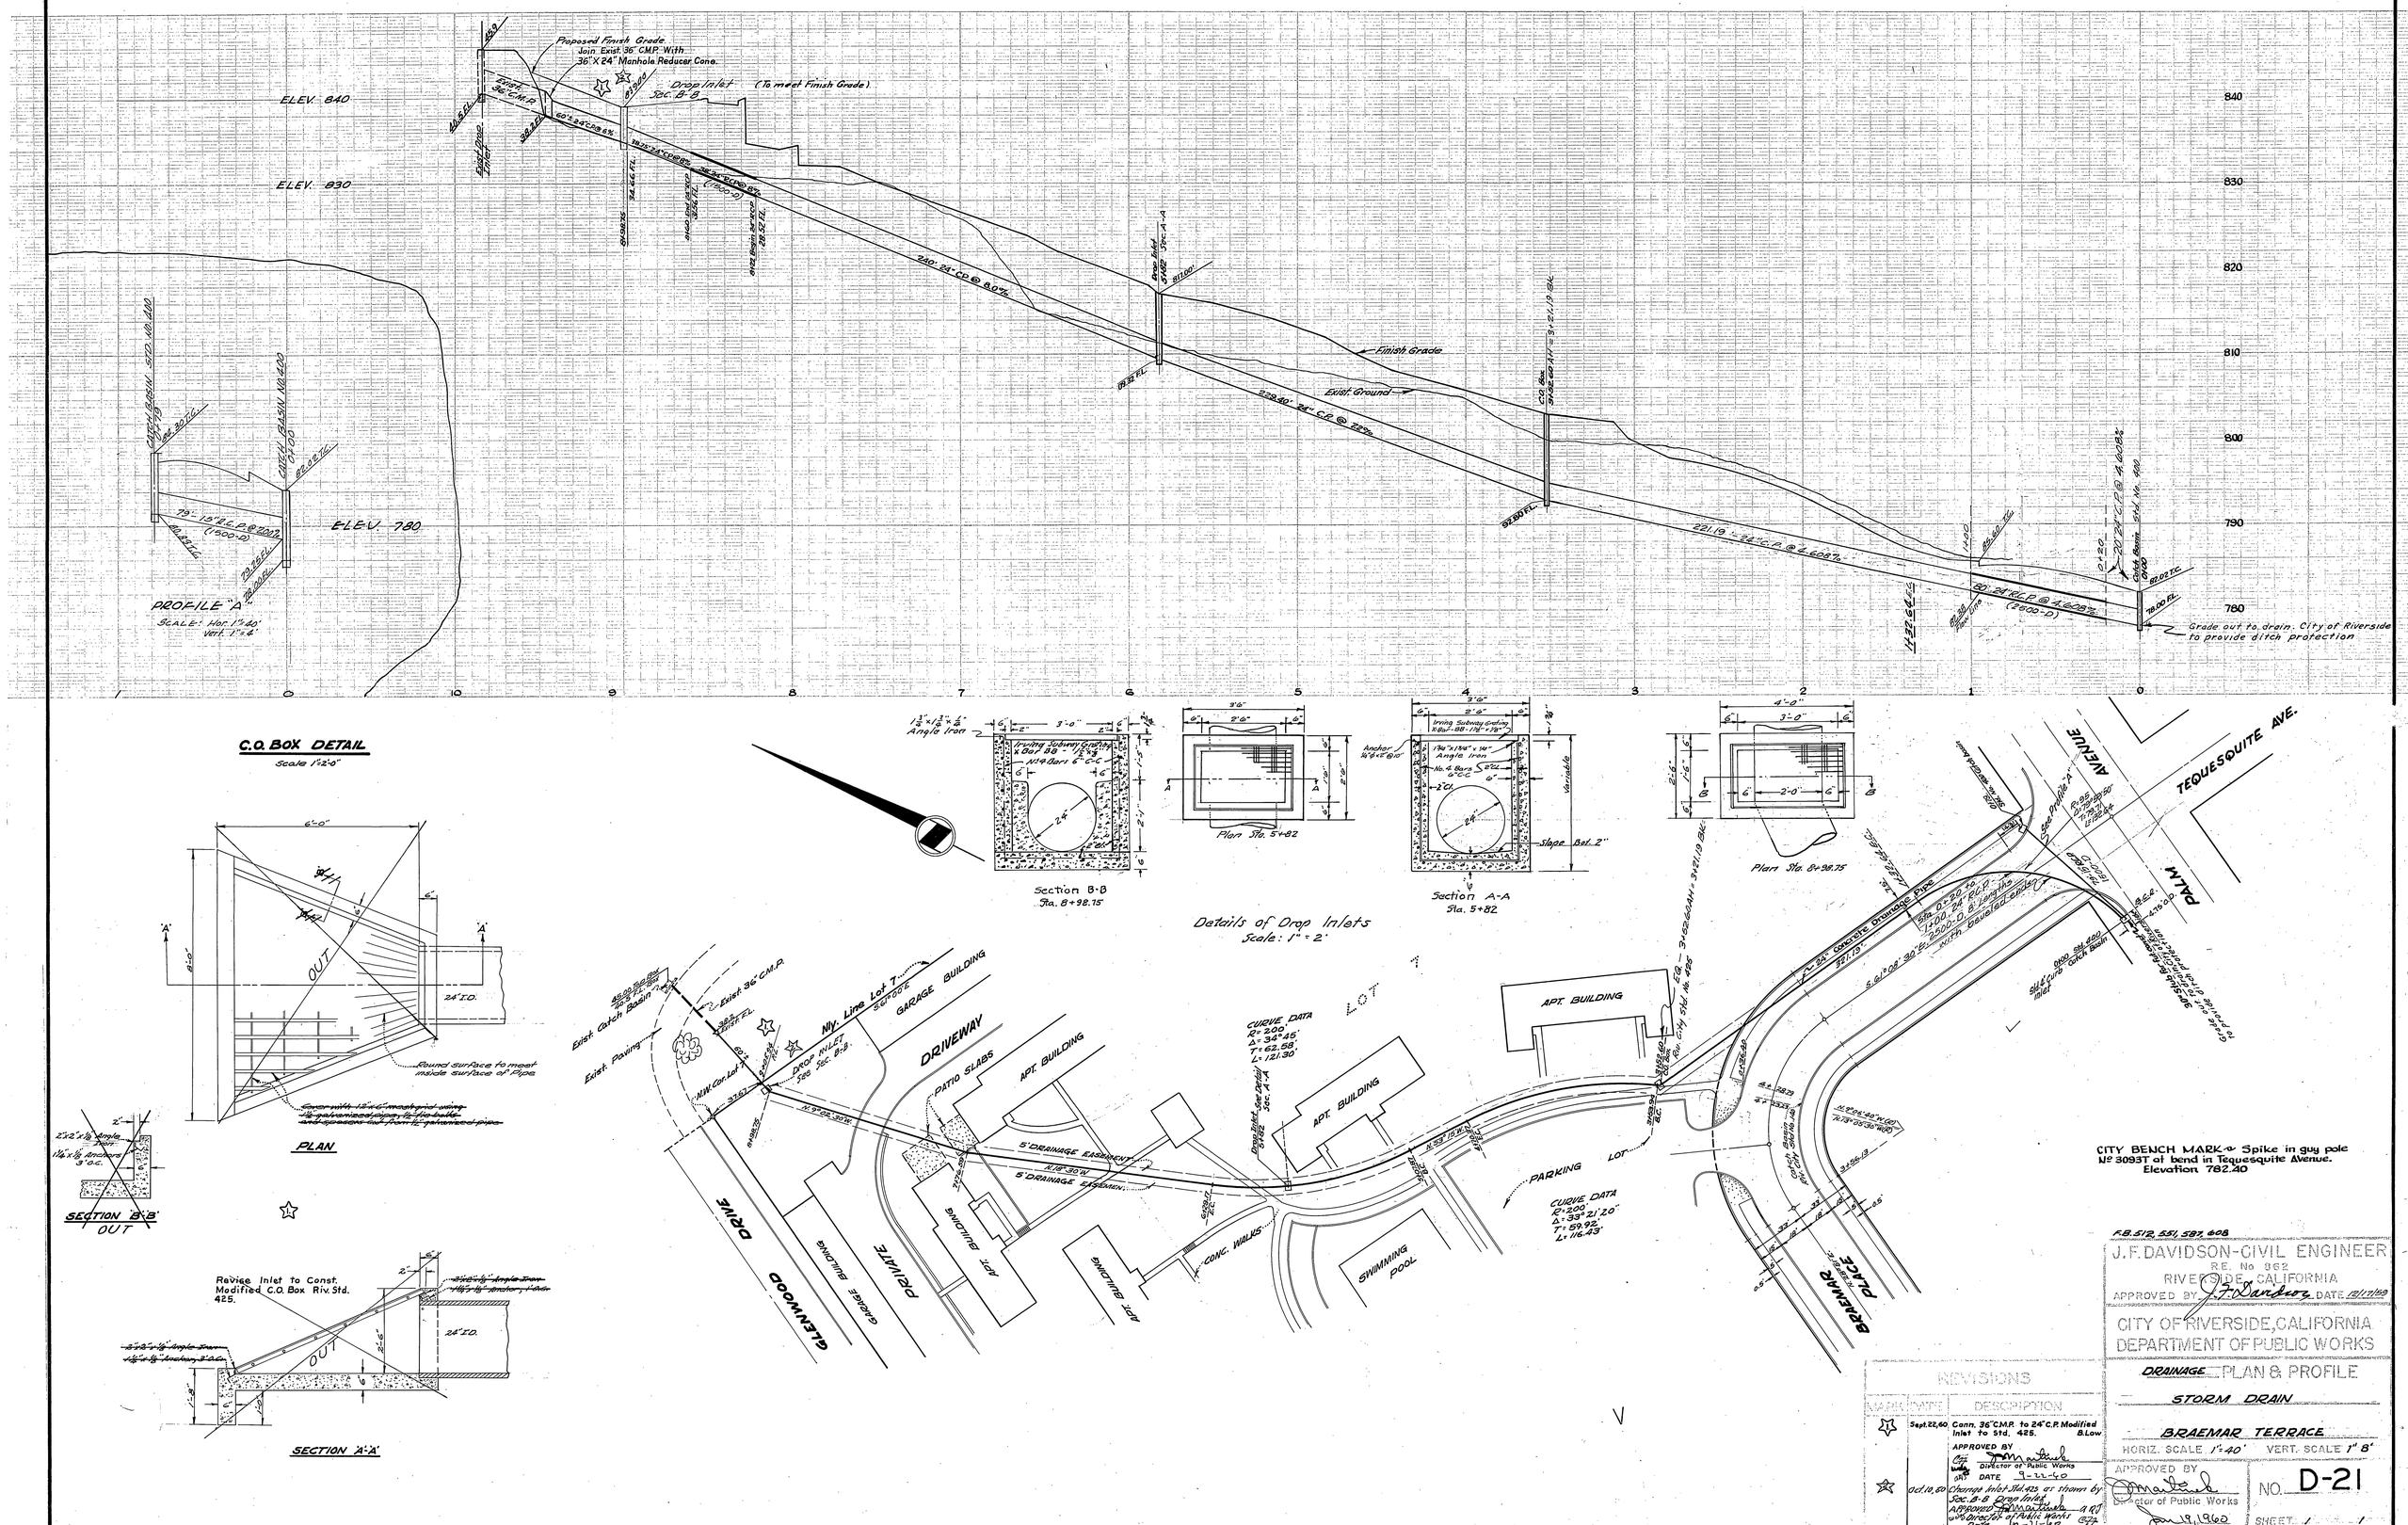

CITY BENCH MARK ~ Spike in guy pole No 3093T at bend in Tequesquite Avenue. Elevation 782.40

F.B. 512, 551, 587, 608

J. F. DAVIDSON-CIVIL ENGINEER
R.E. No 862
RIVERSIDE, CALIFORNIA
APPROVED BY J. F. Davidson DATE 12/17/59

CITY OF RIVERSIDE, CALIFORNIA
DEPARTMENT OF PUBLIC WORKS

DRAINAGE PLAN & PROFILE

STORM DRAIN

BRAEMAR TERRACE

HORIZ. SCALE 1"=40' VERT. SCALE 1" 8'

APPROVED BY
Director of Public Works
Jan 19, 1960

NO. D-21

SHEET 1 1

REVISIONS

MARK	DATE	DESCRIPTION
1	Sept. 22, 60	Conn. 36" C.M.P. to 24" C.P. Modified Inlet to Std. 425. B. Low
		APPROVED BY Director of Public Works DATE 9-22-60
2	Oct. 10, 60	Change Inlet Std. 425 as shown by Sec. B-B Drop Inlet. APPROVED Director of Public Works Date 10-21-60

INDEXED