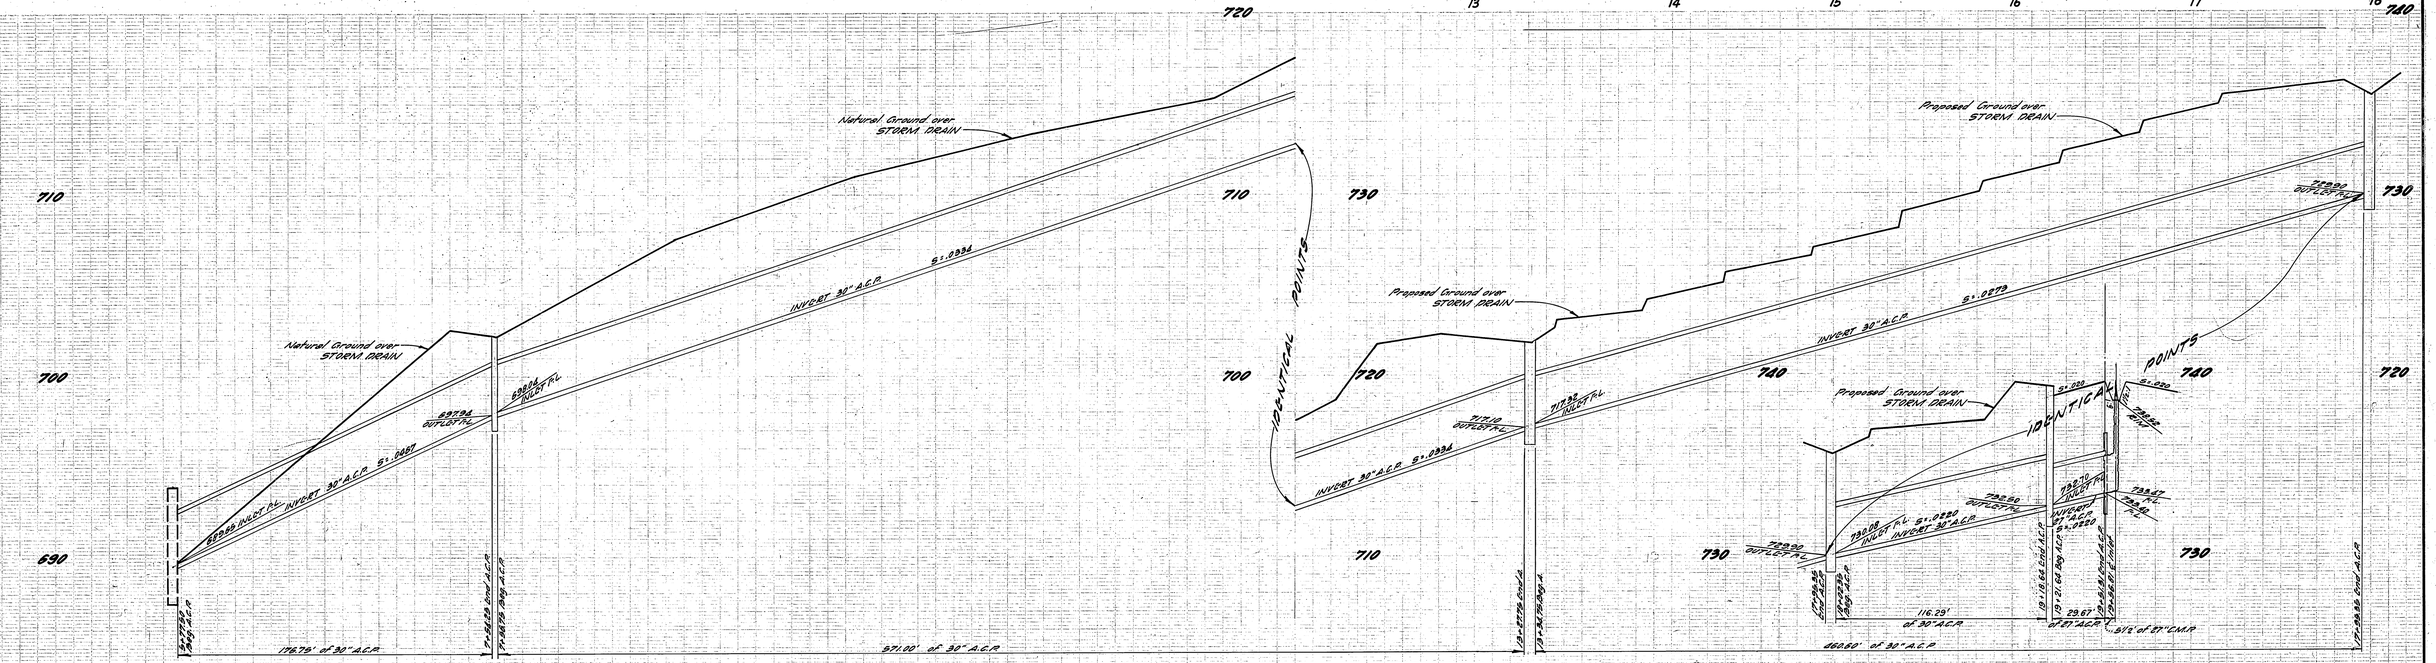

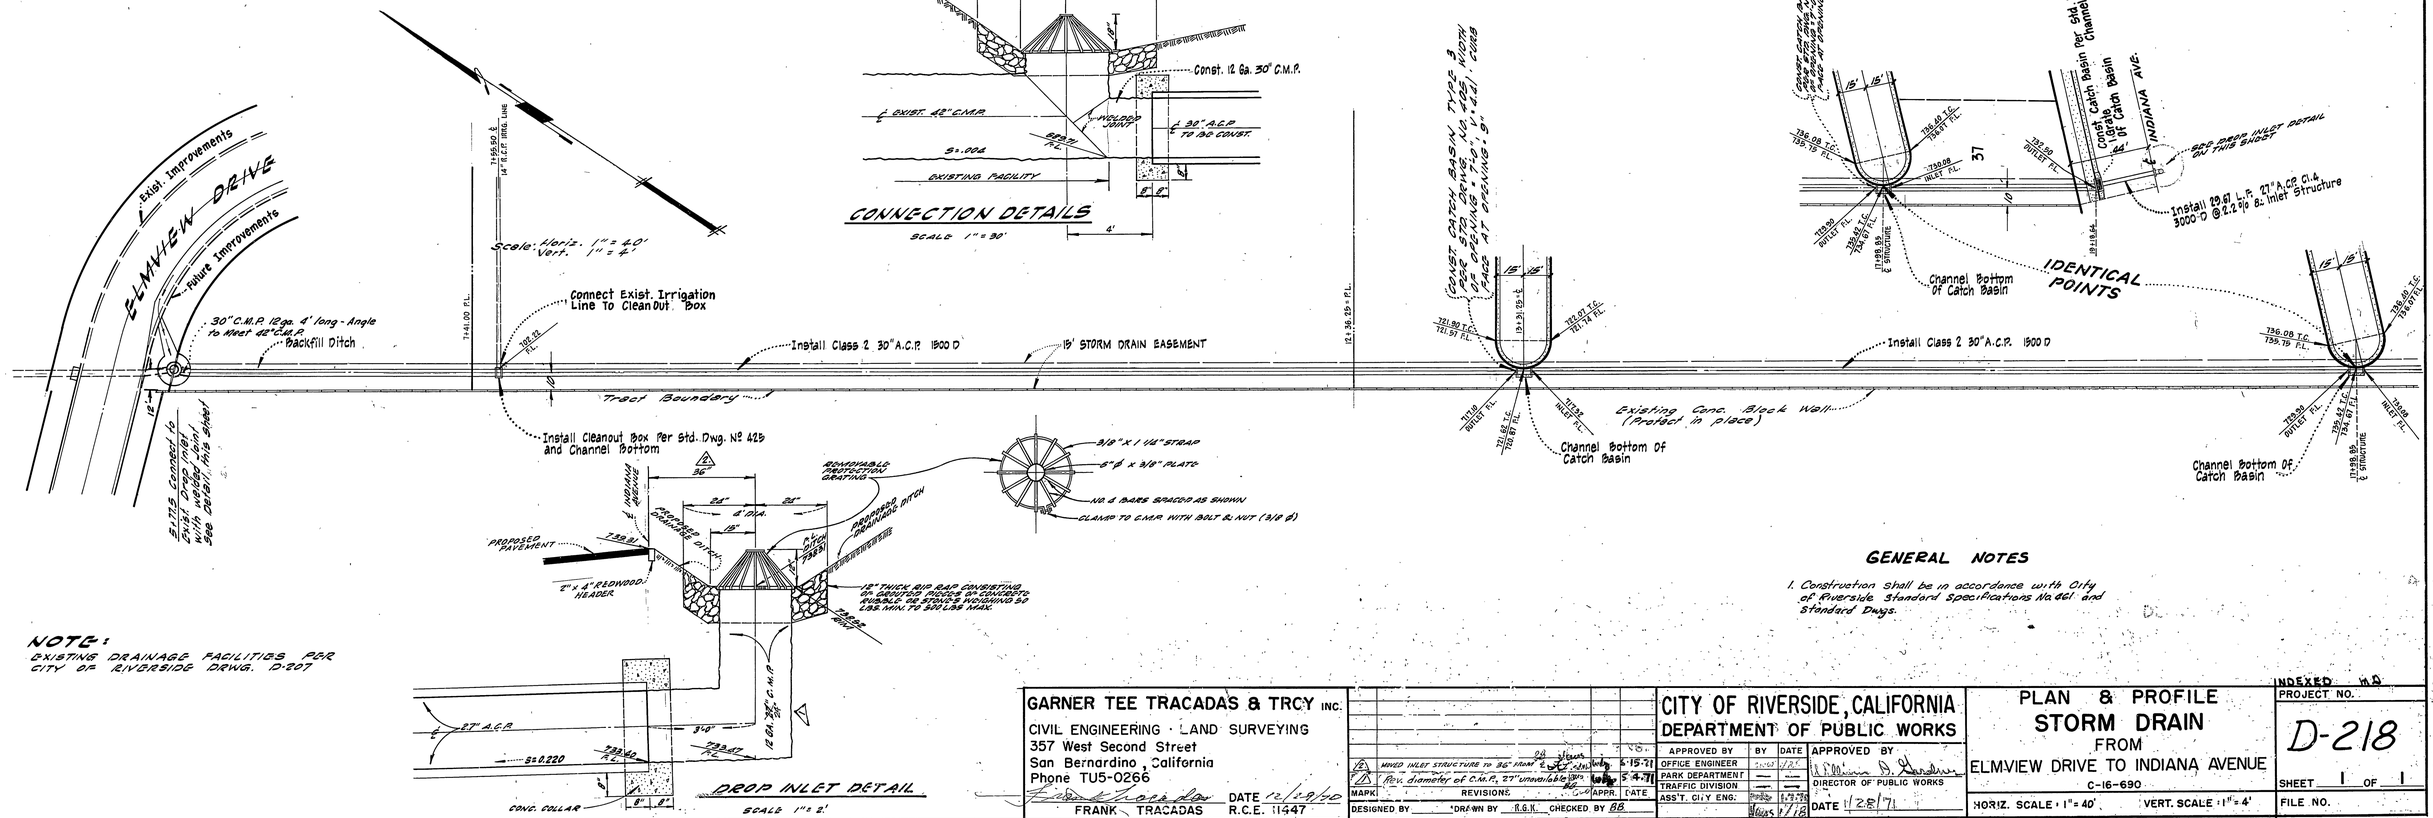

NOTE:
EXISTING DRAINAGE FACILITIES PER CITY OF RIVERSIDE DRWG. D-207

GENERAL NOTES

1. Construction shall be in accordance with City of Riverside Standard Specifications No. 661 and Standard Dwgs.

GARNER TEE TRACADAS & TRCY INC.	
CIVIL ENGINEERING · LAND SURVEYING	
357 West Second Street	
San Bernardino, California	
Phone TU5-0266	
FRANK TRACADAS	DATE 12/2/70 R.C.E. 11447

MARK	REVISIONS	APPR.	DATE
1	MOVED INLET STRUCTURE TO 36" FROM ℄ INDIANA AVENUE		5-15-71
2	Rev. diameter of C.M.P., 27" unavailable		5-4-71

DESIGNED BY ____ DRAWN BY R.G.K. CHECKED BY BB

CITY OF RIVERSIDE, CALIFORNIA
DEPARTMENT OF PUBLIC WORKS

	BY	DATE
APPROVED BY OFFICE ENGINEER		
PARK DEPARTMENT	—	—
TRAFFIC DIVISION	—	—
ASST. CITY ENG.		1-27-71
APPROVED BY DIRECTOR OF PUBLIC WORKS		
DATE 1/28/71		

PLAN & PROFILE STORM DRAIN FROM ELMVIEW DRIVE TO INDIANA AVENUE

C-16-690

HORIZ. SCALE 1" = 40' VERT. SCALE 1" = 4'

INDEXED W.O.

PROJECT NO. D-218

SHEET 1 OF 1

FILE NO.