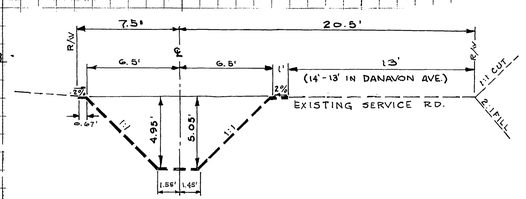

EXIST. CHANNEL SECTION #2
STA. 7+98 TO 17+18
SCALE 1" = 5'

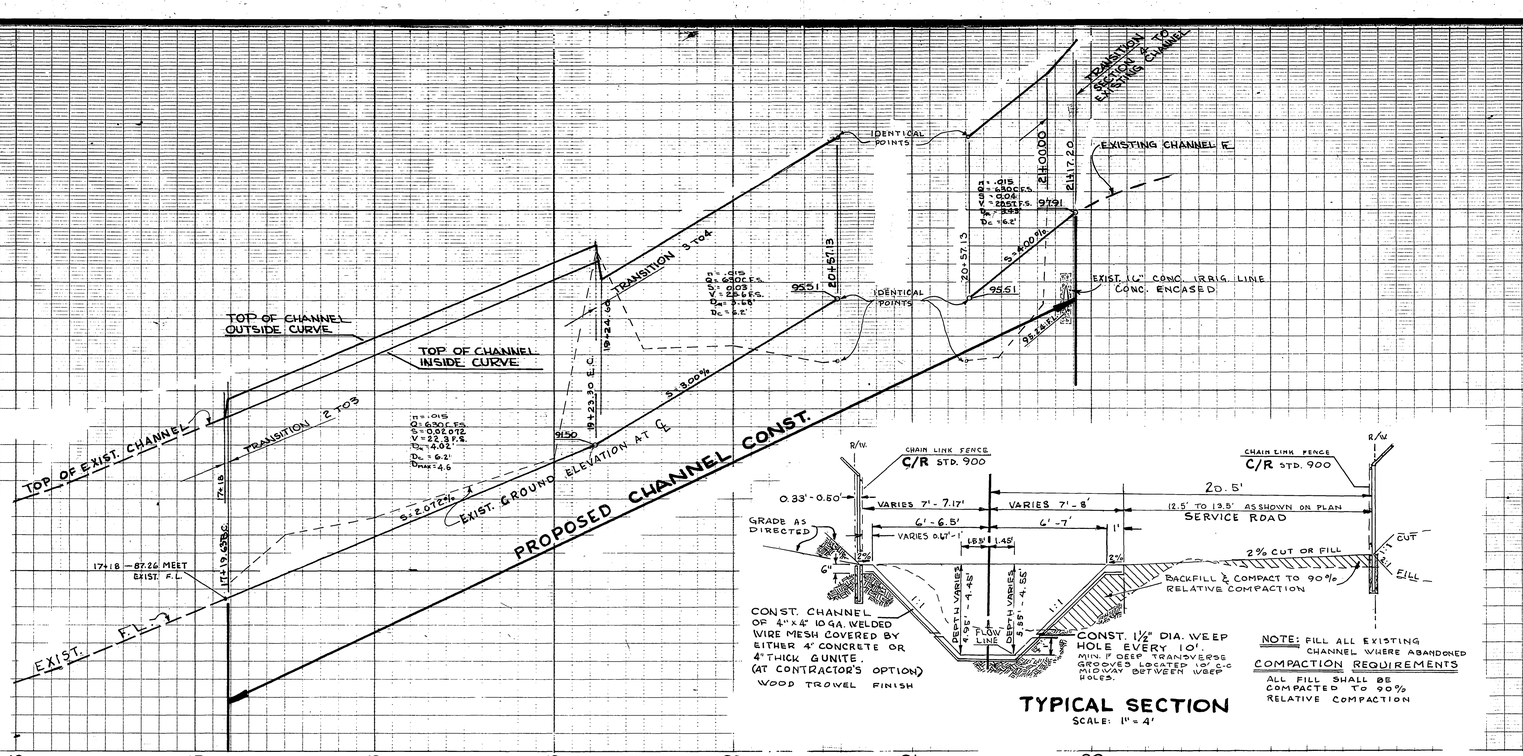

CONST. CHANNEL OF 4" x 4" 10 GA. WELDED WIRE MESH COVERED BY EITHER 4" CONCRETE OR 4" THICK GUNITE. (AT CONTRACTOR'S OPTION) WOOD TROWEL FINISH

CONST. 1½" DIA. WEEP HOLE EVERY 10' MIN. 1' DEEP TRANSVERSE GROOVES LOCATED 10' C-C MIDWAY BETWEEN WEEP HOLES.

NOTE: FILL ALL EXISTING CHANNEL WHERE ABANDONED

COMPACTION REQUIREMENTS
ALL FILL SHALL BE COMPACTED TO 90% RELATIVE COMPACTION

TYPICAL SECTION
SCALE: 1" = 4'

FIELD BOOK D-4 955
PAGES 57-79
B.M. ELEV. 768.16 - SPK. IN POWER POLE 35(22.) SW. COR. TYLER & VERNON ST. SEE FIELD BOOK "O" PG. 63.

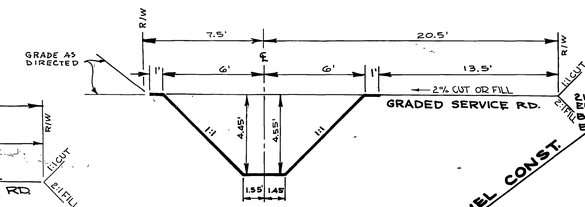

CHANNEL SECTION # 4
STA. 19+24.6 TO 21+00
NO SCALE

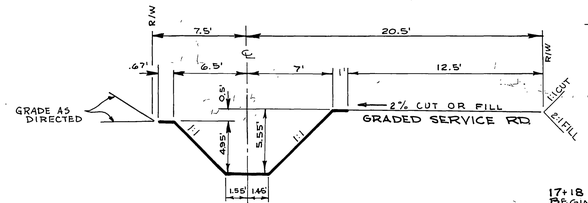

CHANNEL SECTION # 3
STA. 17+19.63 TO 19+23.30
NO SCALE

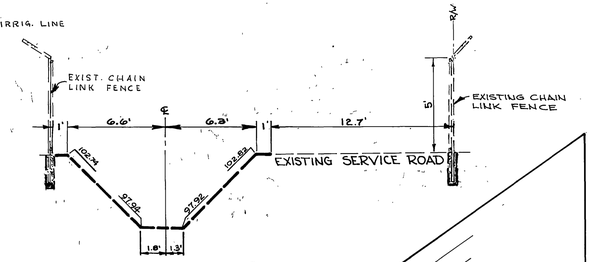

EXIST. CHANNEL SECTION # 5
STA. 21+17.20
SCALE 1" = 5'

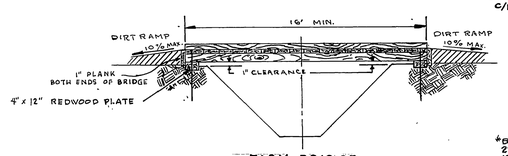

FARM BRIDGE
SIDE ELEVATION - SCALE 1"=5'
USE ROUGH CUT CONST. GRADE DOUGLAS FIR FOR DECKING.

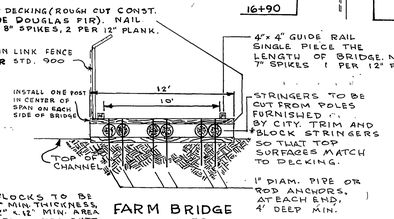

FARM BRIDGE
STA. 19+75
END ELEVATION
NO SCALE

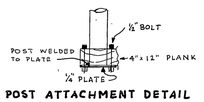

POST ATTACHMENT DETAIL
ON FARM BRIDGE
NO SCALE

AS BUILT - NO CHANGES - 1-24-72 gw

MARK	REVISIONS	APPR.	DATE

DESIGNED BY S.J.B. DRAWN BY W CHECKED BY

CITY OF RIVERSIDE, CALIFORNIA
DEPARTMENT OF PUBLIC WORKS

APPROVED BY	BY	DATE
OFFICE ENGINEER		
PARK DEPARTMENT		
TRAFFIC DIVISION		
ASSISTANT CITY ENG.		

APPROVED BY
DIRECTOR OF PUBLIC WORKS
DATE

TEMESCAL S.D. NO. 4

PROJECT NO. 473
D-219
SHEET 1 OF 1
HORIZ. SCALE: 1" = 40' VERT. SCALE: 1" = 2'
FILE NO.